


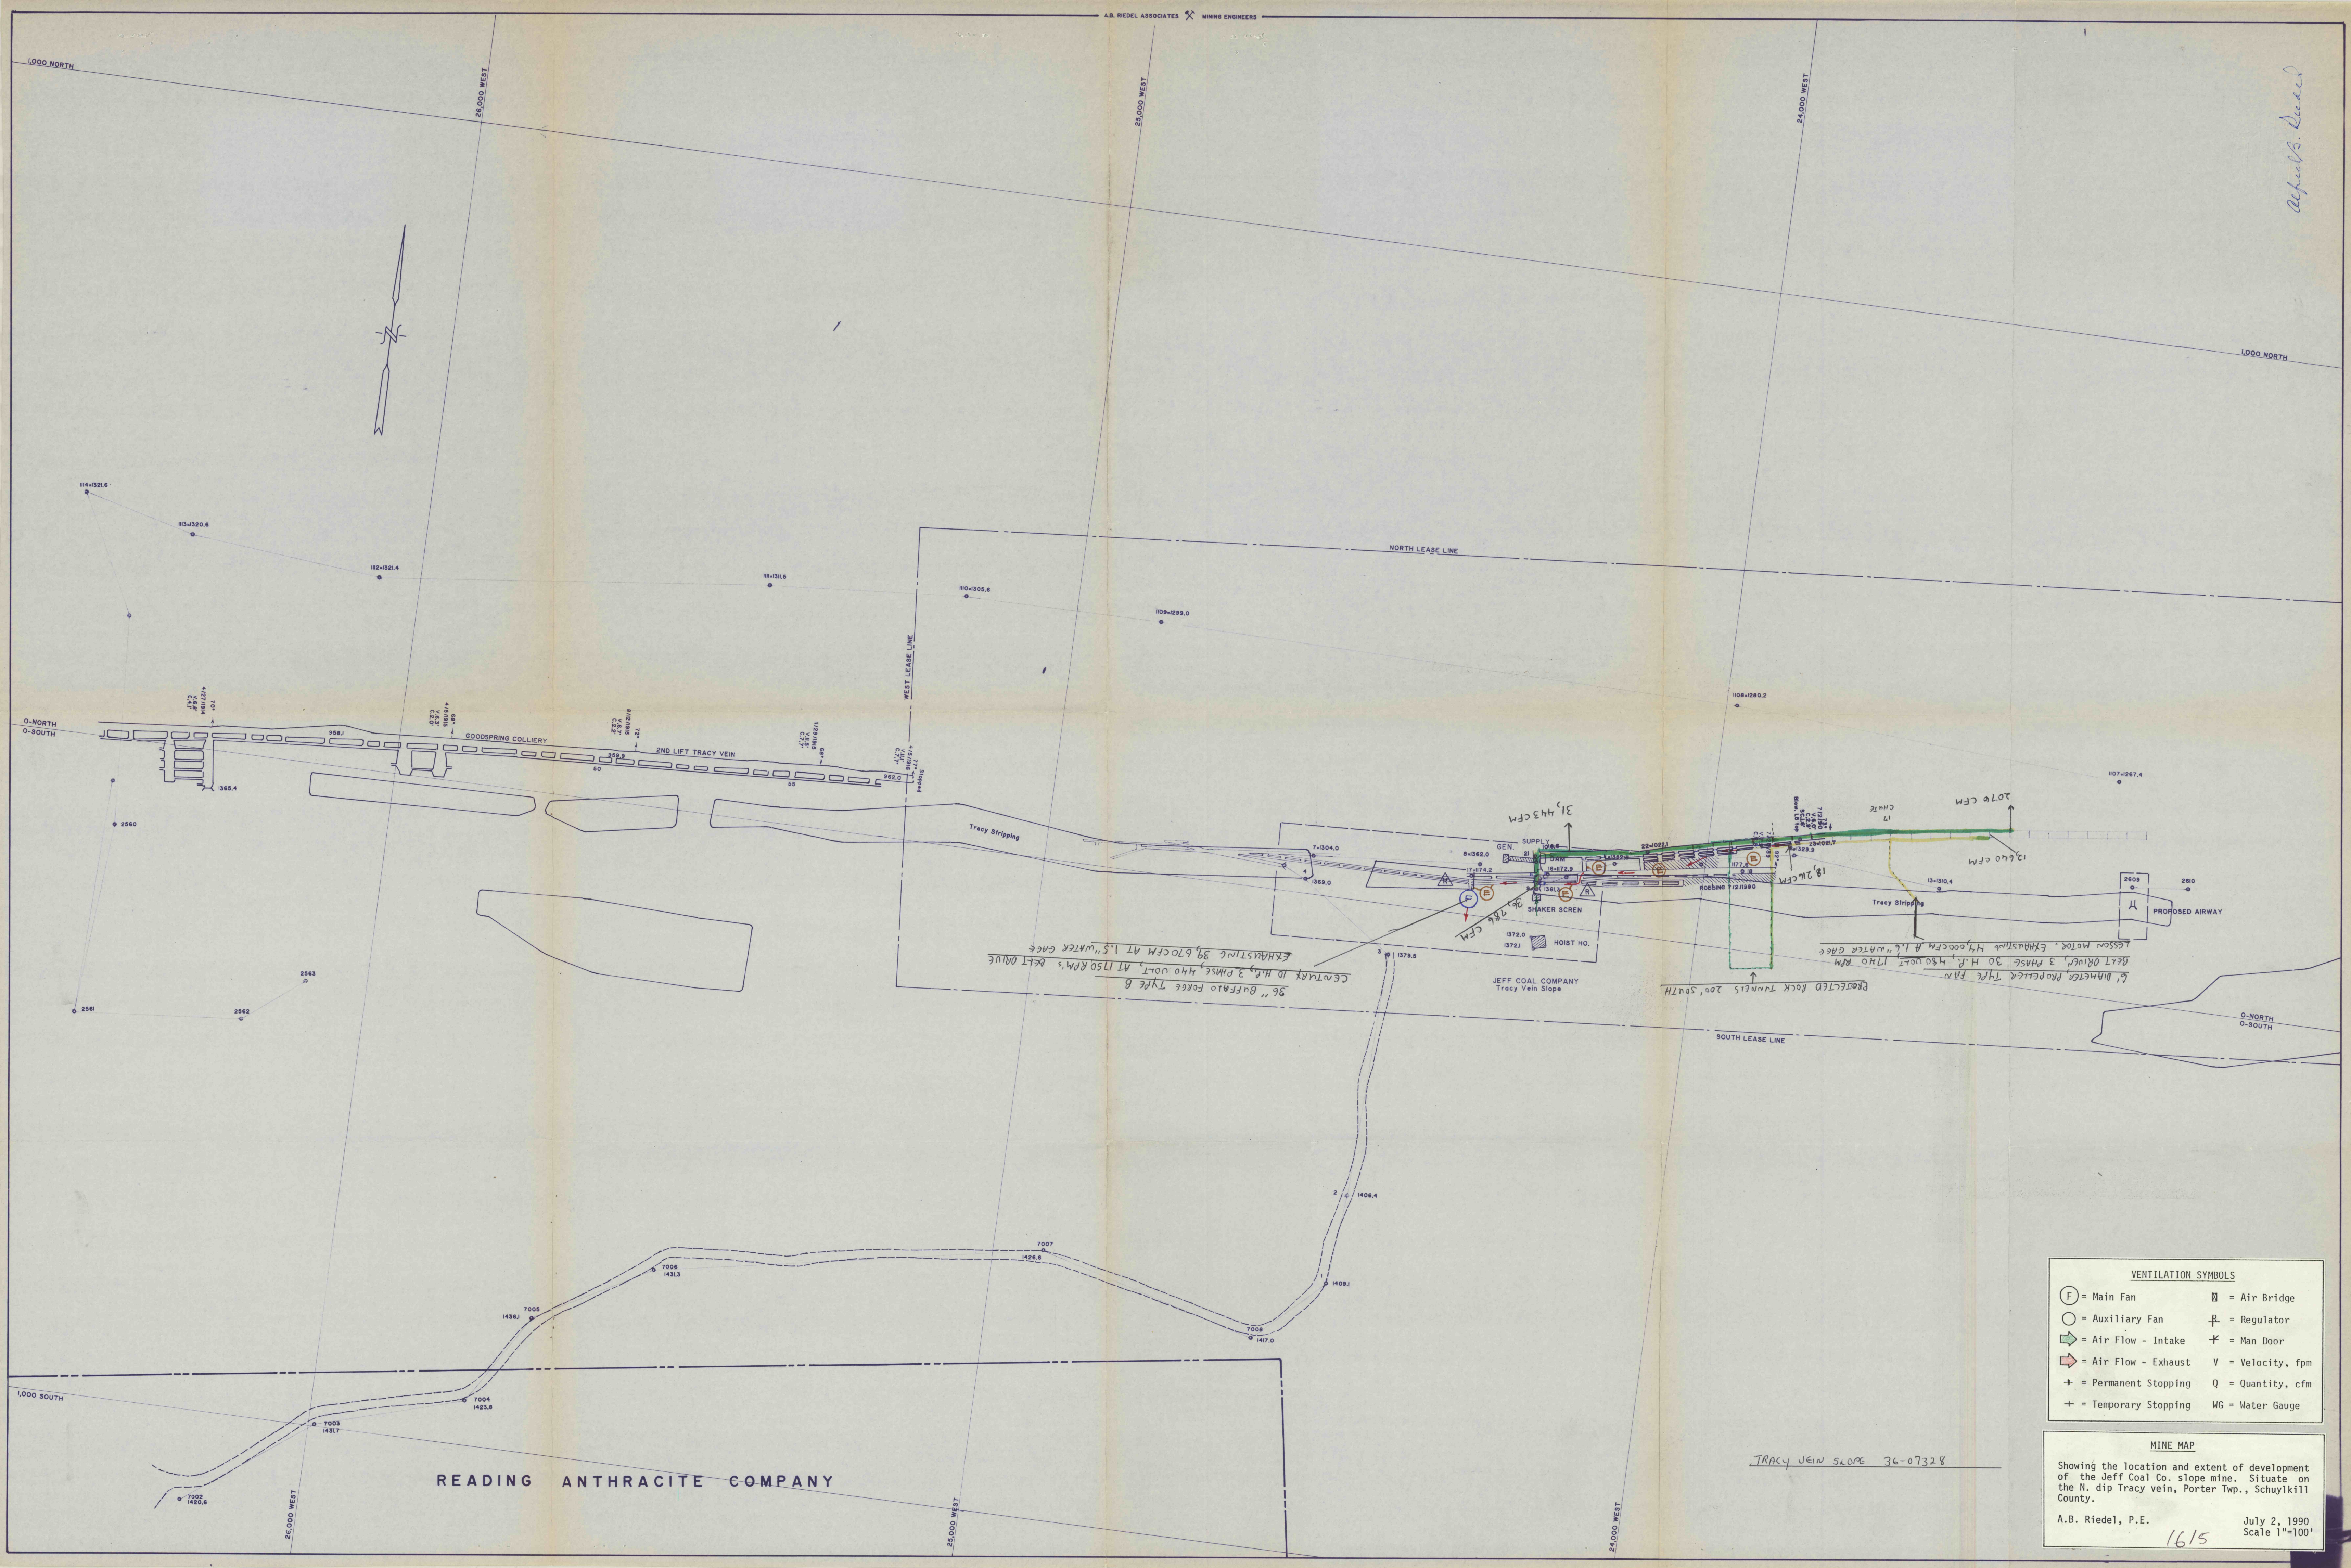

Alfred S. Riedel

VENTILATION SYMBOLS	
(F) = Main Fan	⌘ = Air Bridge
(A) = Auxiliary Fan	⌘ = Regulator
→ = Air Flow - Intake	⌘ = Man Door
↘ = Air Flow - Exhaust	V = Velocity, fpm
⊕ = Permanent Stopping	Q = Quantity, cfm
⊕ = Temporary Stopping	WG = Water Gauge

MINE MAP
Showing the location and extent of development of the Jeff Coal Co. slope mine. Situate on the N. dip Tracy vein, Porter Twp., Schuylkill County.
A.B. Riedel, P.E. July 2, 1990
Scale 1"=100'