


HORIZONTAL & VERTICAL CONTROL DATA


STA.	NORTH	EAST	ELEV.	DESCRIPTION
333	1857.66	-71989.28	1299.6	DRILL HOLE/ROCK
332	1927.52	-71755.55	1276.4	#5 REBAR
358	2071.98	-71549.72	1225.3	#5 REBAR/SLOPE

PETER PETERY TRACT

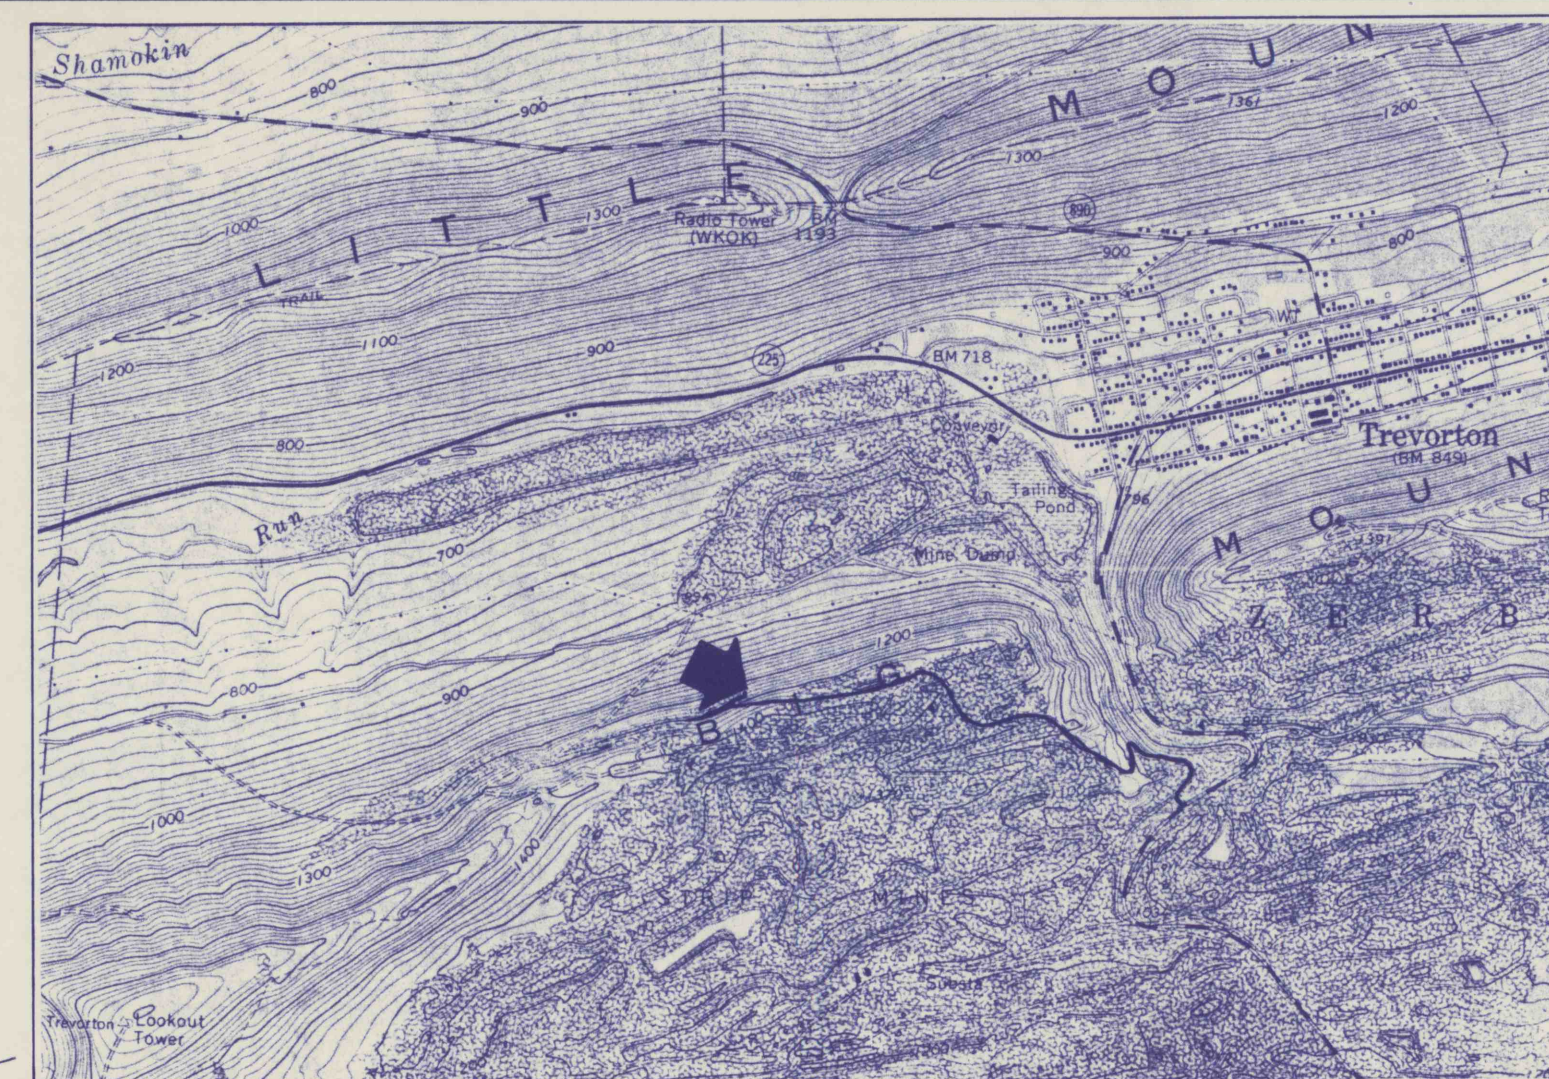

LOCATION MAP
1 INCH = 2000 FEET

THOMAS GRANT TRACT

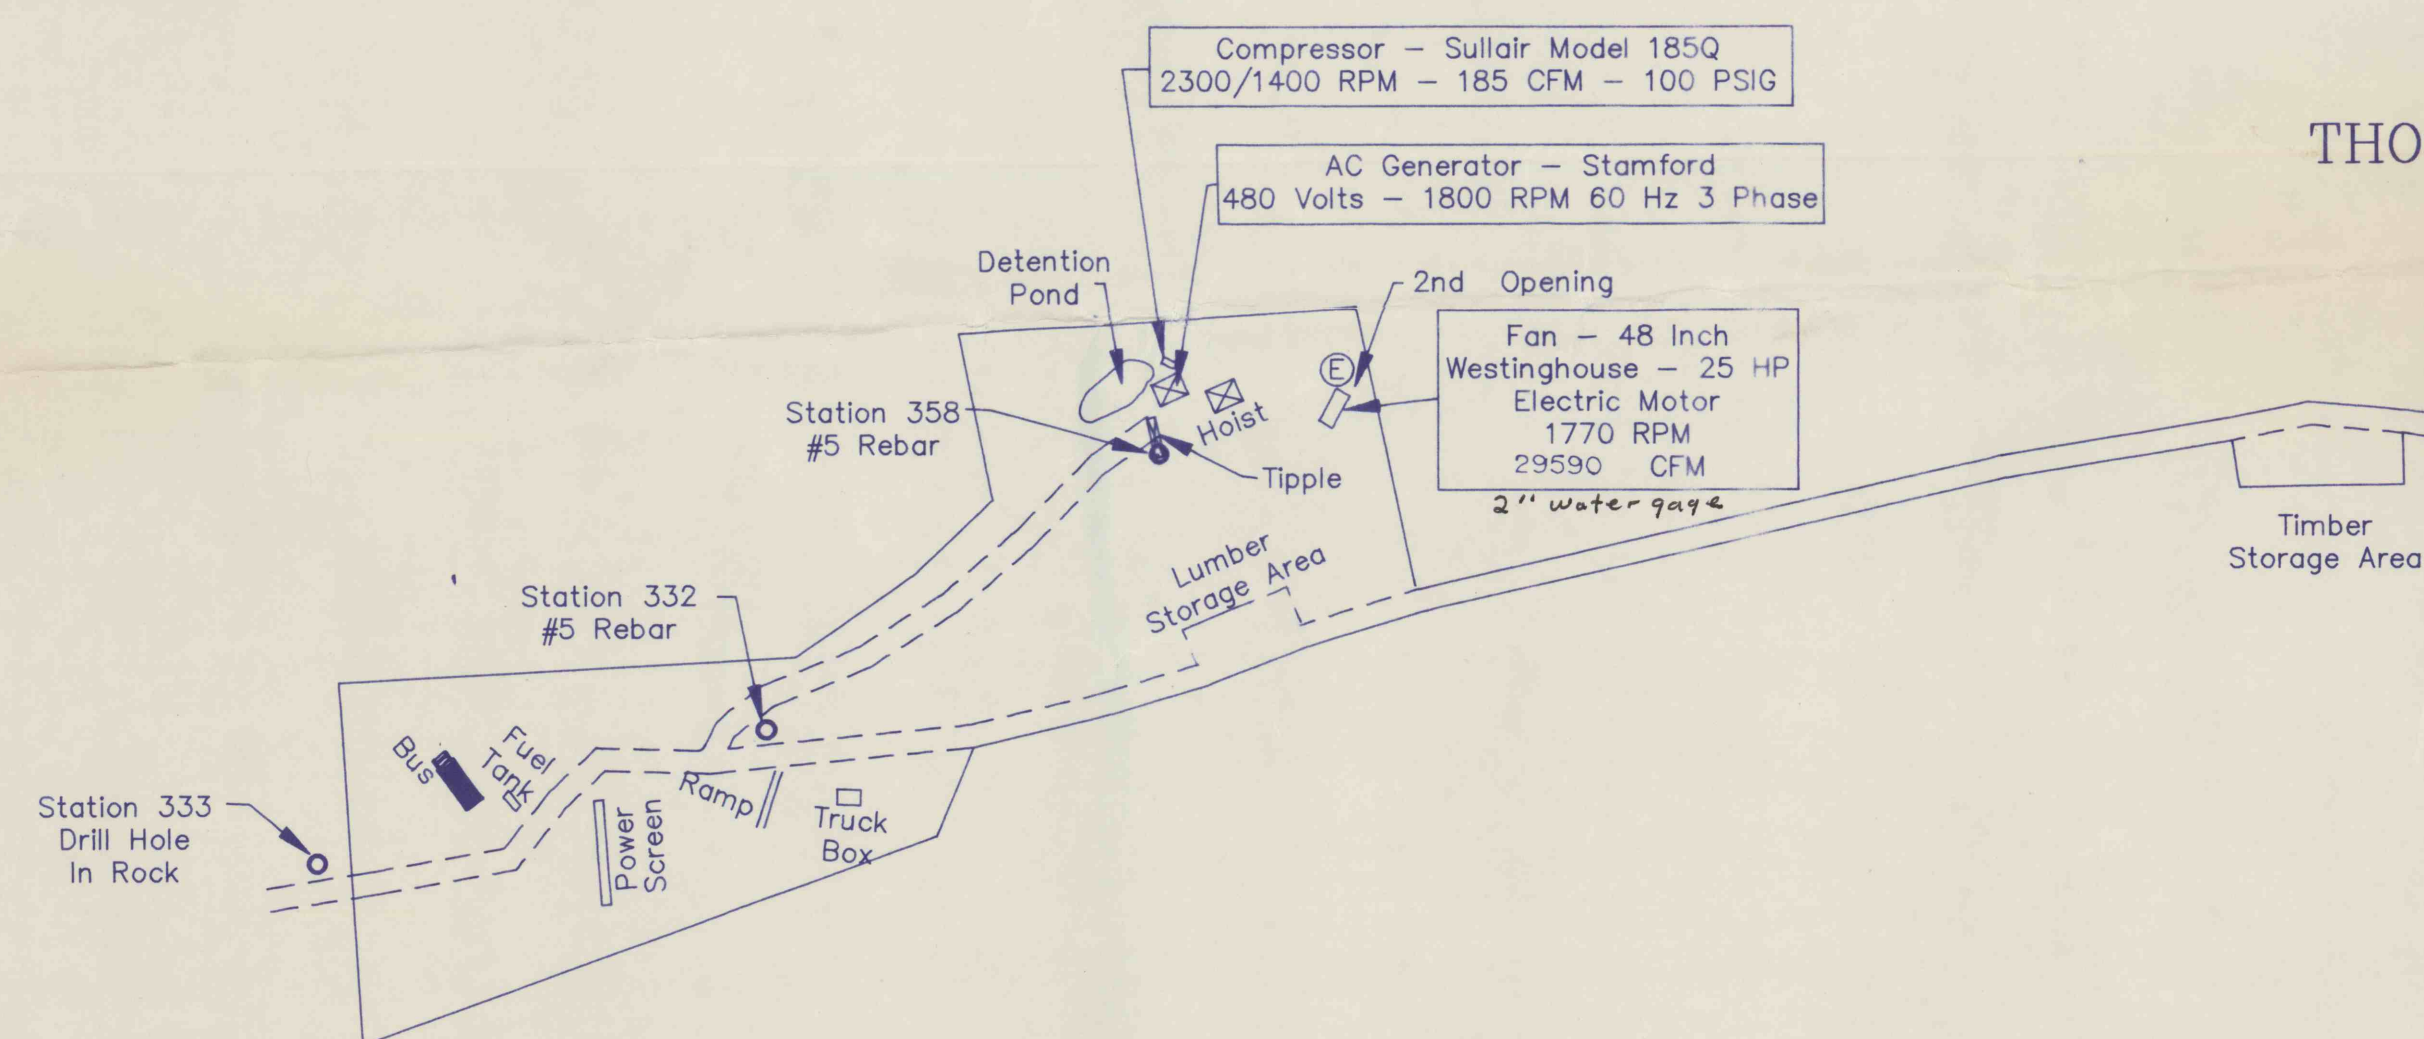

RECORDED
AUG 9 1994
U.S. DEPT. OF LABOR
BUREAU OF MINES
SHAMOKIN, PA.

Snyder Coal Co.

Legend:


- ESCAPWAY (E)
- RETURN AIR (R)
- INTAKE AIR (I)
- PERMANENT STOPPING (S)
- TEMPORARY STOPPING (T)
- PERMANENT STOPPING WITH DOOR (D)
- BLEEDER EVALUATION POINT (BEP)
- SURVEY STATION 358 (S)
- ROBBED (R)
- OLD WORKINGS MAPPED BY OTHERS AND/OR INACCESSIBLE (O)

Notes:

AFFECTED SURFACE AREA - 5.00 ACRES
PERMIT TO BE AMENDED

Prepared For:
K & L Coal Co.
742 Coal Street
Trevorton, PA 17881
(717) 797-3205
Mine ID No. 36-06649
Permit No. 49851314

Prepared By:
Taylor-Dobeck Associates
Professional Land Surveyors
RD#1 Box 659
Shamokin, PA 17872
(717) 648-1976

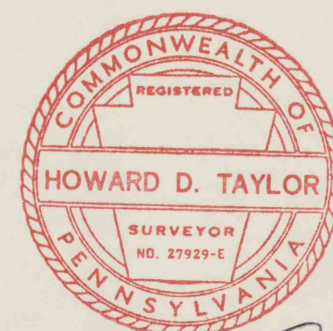

Howard D. Taylor


MINE & VENTILATION MAP
K & L COAL CO. - NO. 1 SLOPE
ZERO VEIN - SOUTH DIP

ZERBE TOWNSHIP
NORTHUMBERLAND COUNTY
PENNSYLVANIA

SCALE: 1 INCH = 100 FEET

JUNE 12, 1992

GRAPHIC SCALE

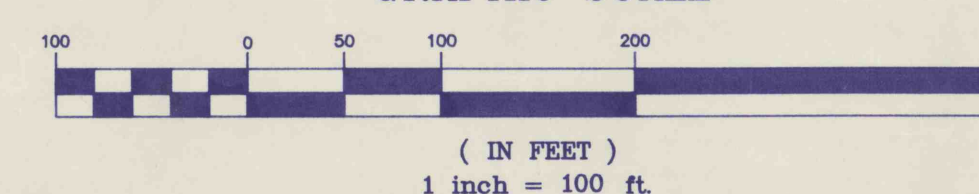

Revisions

NO.	DATE	DESCRIPTION	BY

Sheet No. 1