

PETER PETERY TRACT

THOMAS GRANT TRACT

Timber
Storage Area

MATCH LINE

SHEET NO. 1
SHEET NO. 2

Access Road

STRIPPING PIT

REFUSE
DISPOSAL AREA


Snyder
Coal Co.

Ramp
LOADING
AREA

TO STATE ROUTE NO. 2044
(L.R. NO. 49012)


Prepared For:
K & L Coal Co.
742 Coal Street
Trevorton, PA 17881
(717) 797-3205
Mine ID No. 36-06649
Permit No. 49851314

Prepared By:
Taylor-Dobeck Associates
Professional Land Surveyors
RD#1 Box 659
Shamokin, PA 17872
(717) 648-1976

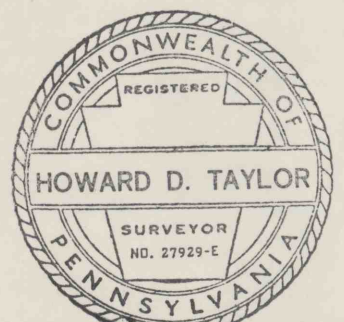

Howard D. Taylor

MINE & VENTILATION MAP
K & L COAL CO. - NO. 1 SLOPE
ZERO VEIN - SOUTH DIP
ZERBE TOWNSHIP
NORTHUMBERLAND COUNTY
PENNSYLVANIA

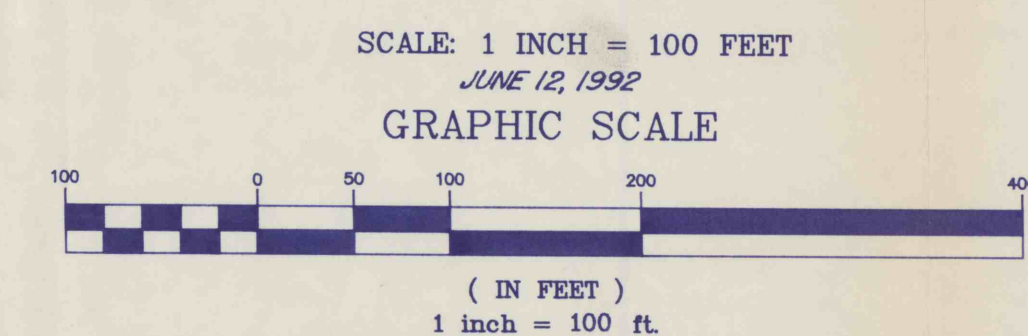

Revisions

NO.	DATE	DESCRIPTION	BY

Sheet No. 2