

PETER PETERY TRACT

TYPICAL SECTION THRU
A&D COAL CO. SLOPE
SCALE 1"=100'-0"

TYPICAL SECTION THRU
K&L COAL CO. SLOPE
SCALE 1"=100'-0"

MINE MAP
SCALE 1"=100'-0"

R & L COAL CO.

MINE MAP


SHOWING THE LOCATION AND EXTENT OF DEVELOPMENT OF K&L COAL CO.
SITUATED ON THE SOUTH DIP OF #10 VEIN, AND IN THE BIG MOUNTAIN SECTION
OF SEBEE TWO NORTHUMBERLAND CO. PA. JAN. 7, 1935
MAIN FAN 4' COLLAPSED, STEELVAN AXIFLO FAN, BELT DRIVEN BY 444VOLT 25 H.P. MOTOR
RUNS 1770 RPM, MAINT. 21.8 AMPS, EXHAUSTING 25,890 CFM WITH 2.5 INCHES WATER GAGE

THOMAS GRANT TRACT

THOMAS HAMILTON TRACT

TREVORTON ESTATE TRACT

LEGEND
RETURN AIR
STOPPING
INTAKE AIR
ESCAPEWAY
VEIN
ALL ADVANCEMENT SHOW AS OF JAN. 1935
ROCKS

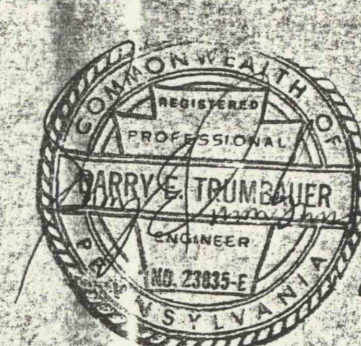

DEC 22
JAN 1-1930

2, 1990