

ASSOCIATE LANDS

N

BEAR VALLEY COLLIERY
14 VEIN, ZERBE, COAL TWP,
SHAMOKIN, PA, WESTERN MIDDLE FIELD
NORTHUMBERLAND COUNTY

14 VEIN J.H.D.
MOORE COAL CO. SURVEY


Scale 1"=100'

3-27-64

OLD COMPRESSION
FOUNDATION HOUSE

ADJACENT WORKINGS
NO. 14 VEIN

SHELDON DERCK
NO. 1 SLOPE - NO. 14 VEIN
MSHA I.D. #36-07010

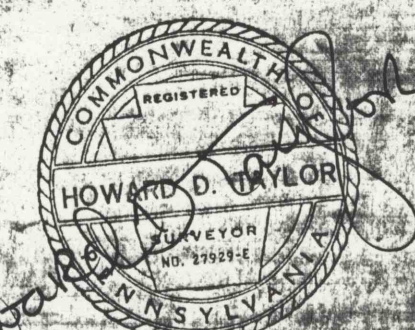

SHEET NO. 2

BERNARD HUBLEY TRACT

1636