


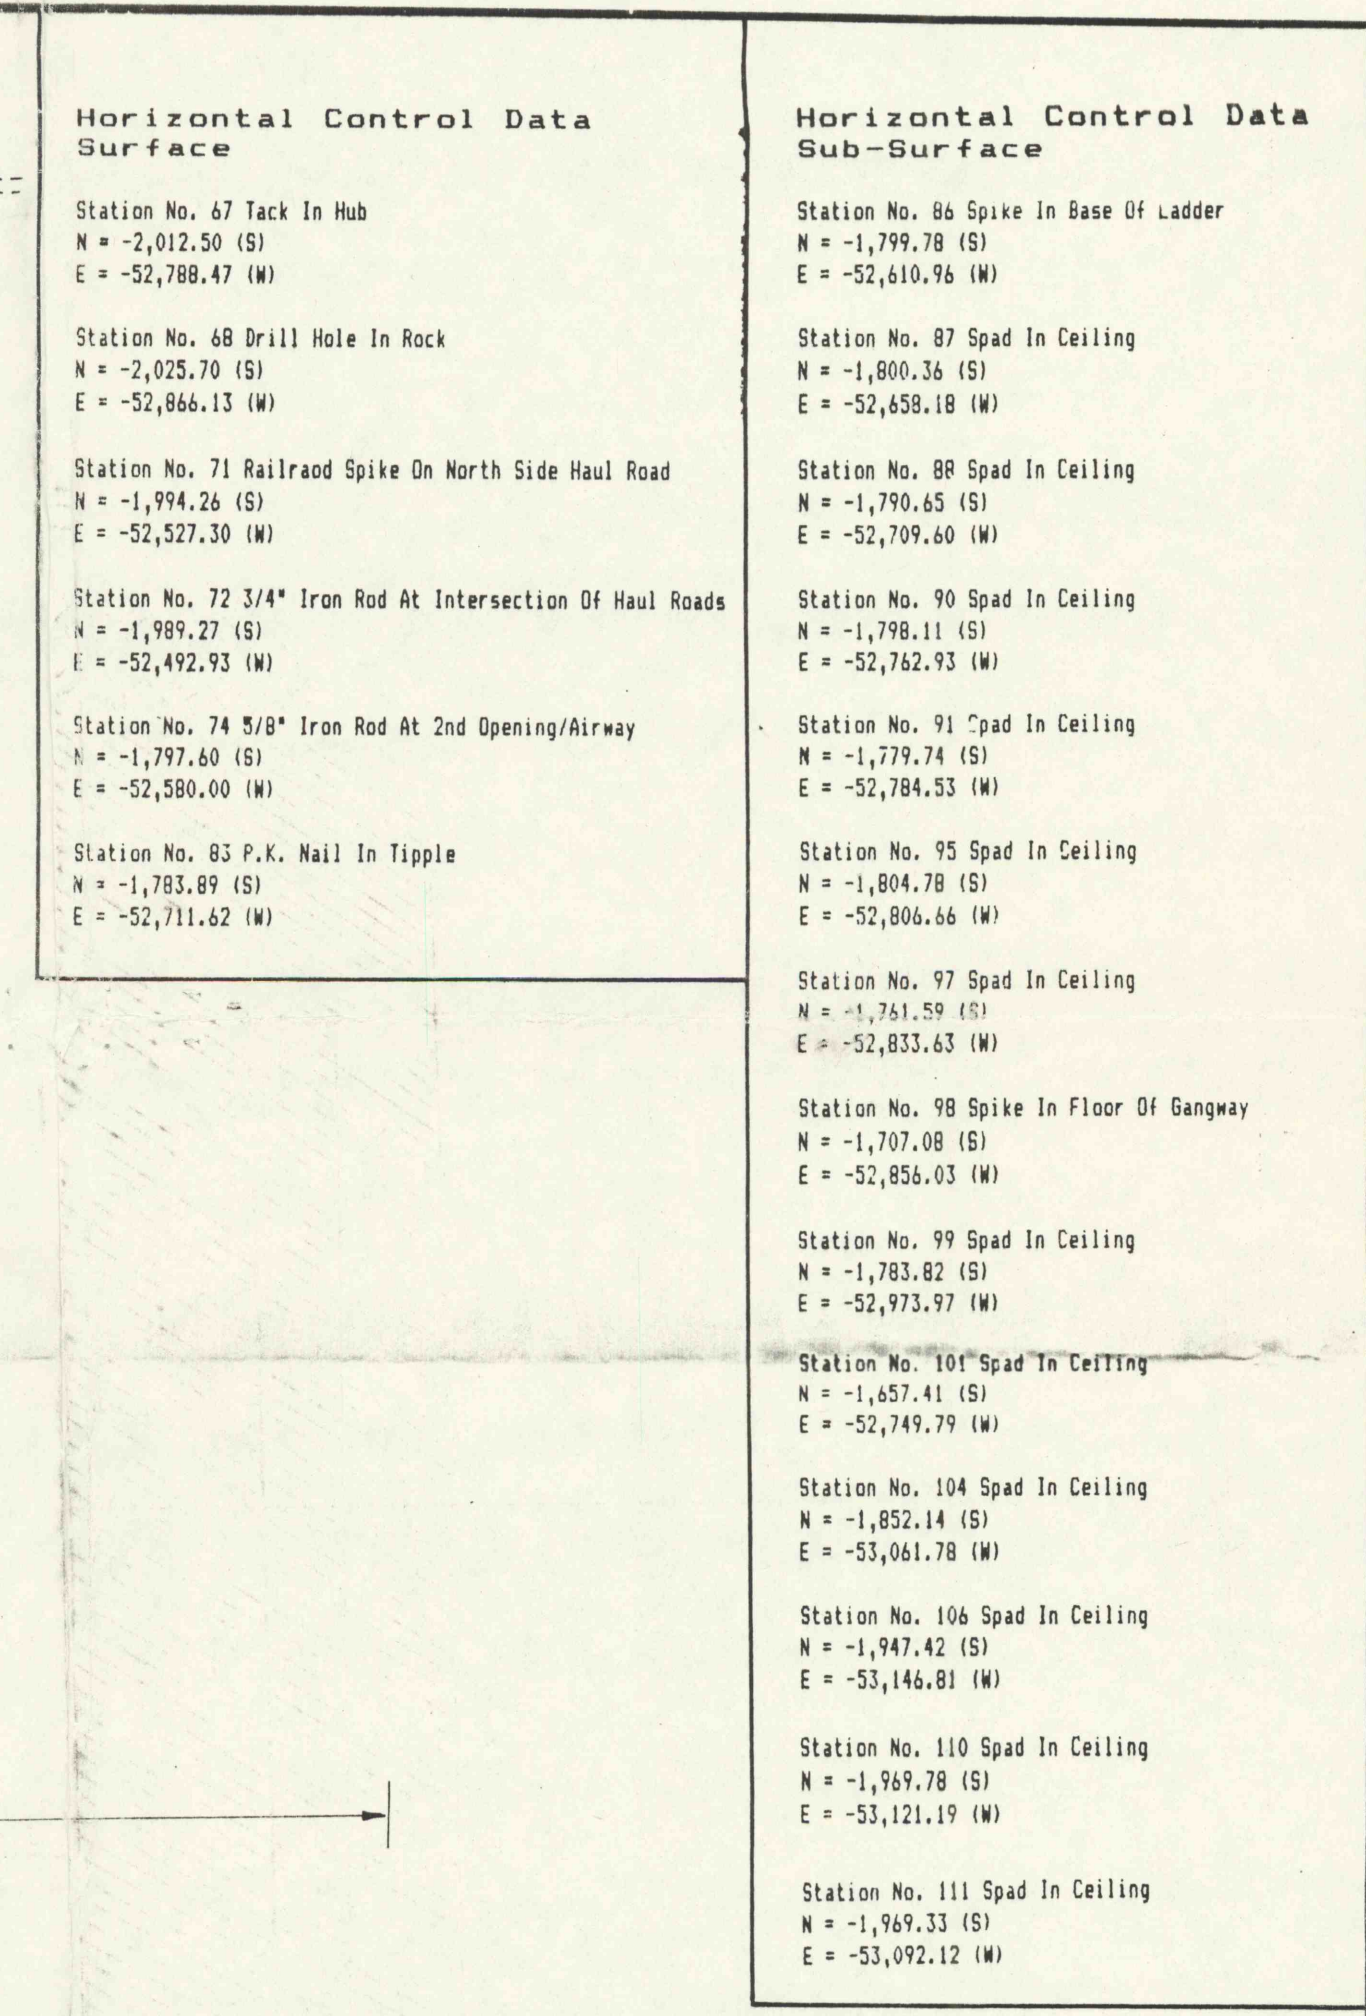

MSHA I.D. # 36-07018

Howard D. Taylor, P.L.S.

1639