


NEUMEISTER COAL CO ID# 36-07166

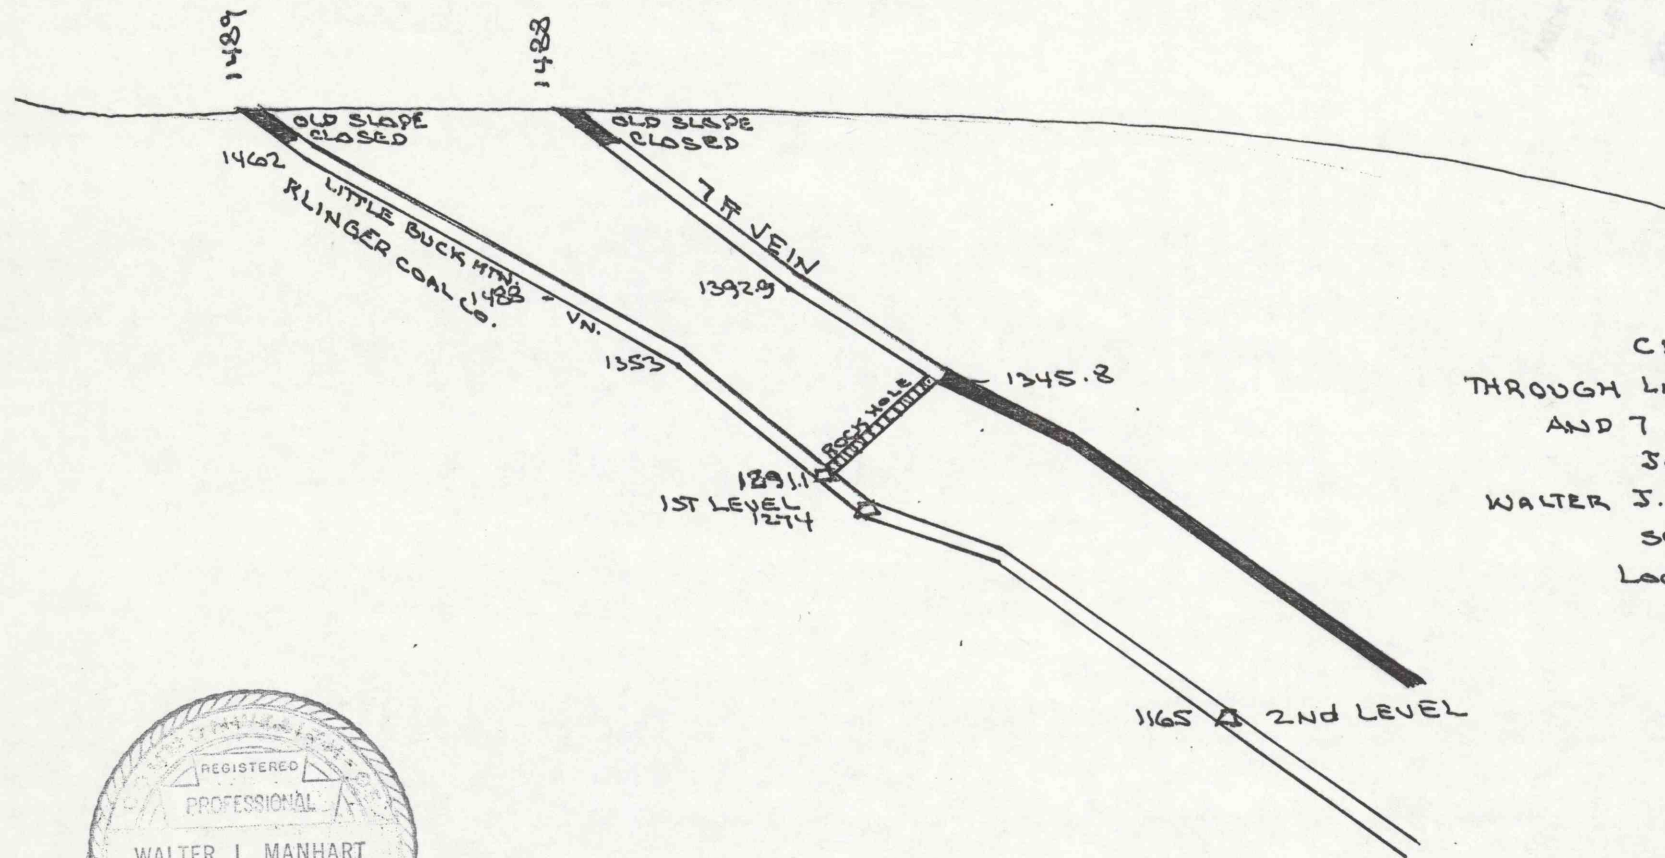

CROSS SECTION
THROUGH LITTLE BUCK MTN. SLOPE
AND 7 FOOT AIR HOLE
JUNE 27, 1992
WALTER J. MANHART P.E. 1195K
SCALE 1" = 100'
LOOKING EAST



WEST BUCK MTN.
GNY NO. 4 PLANE 1072.1
DRAINAGE
TUNNEL
WHITEASH
DRIFT

DATUM 1000

Walter J. Manhart

1642