


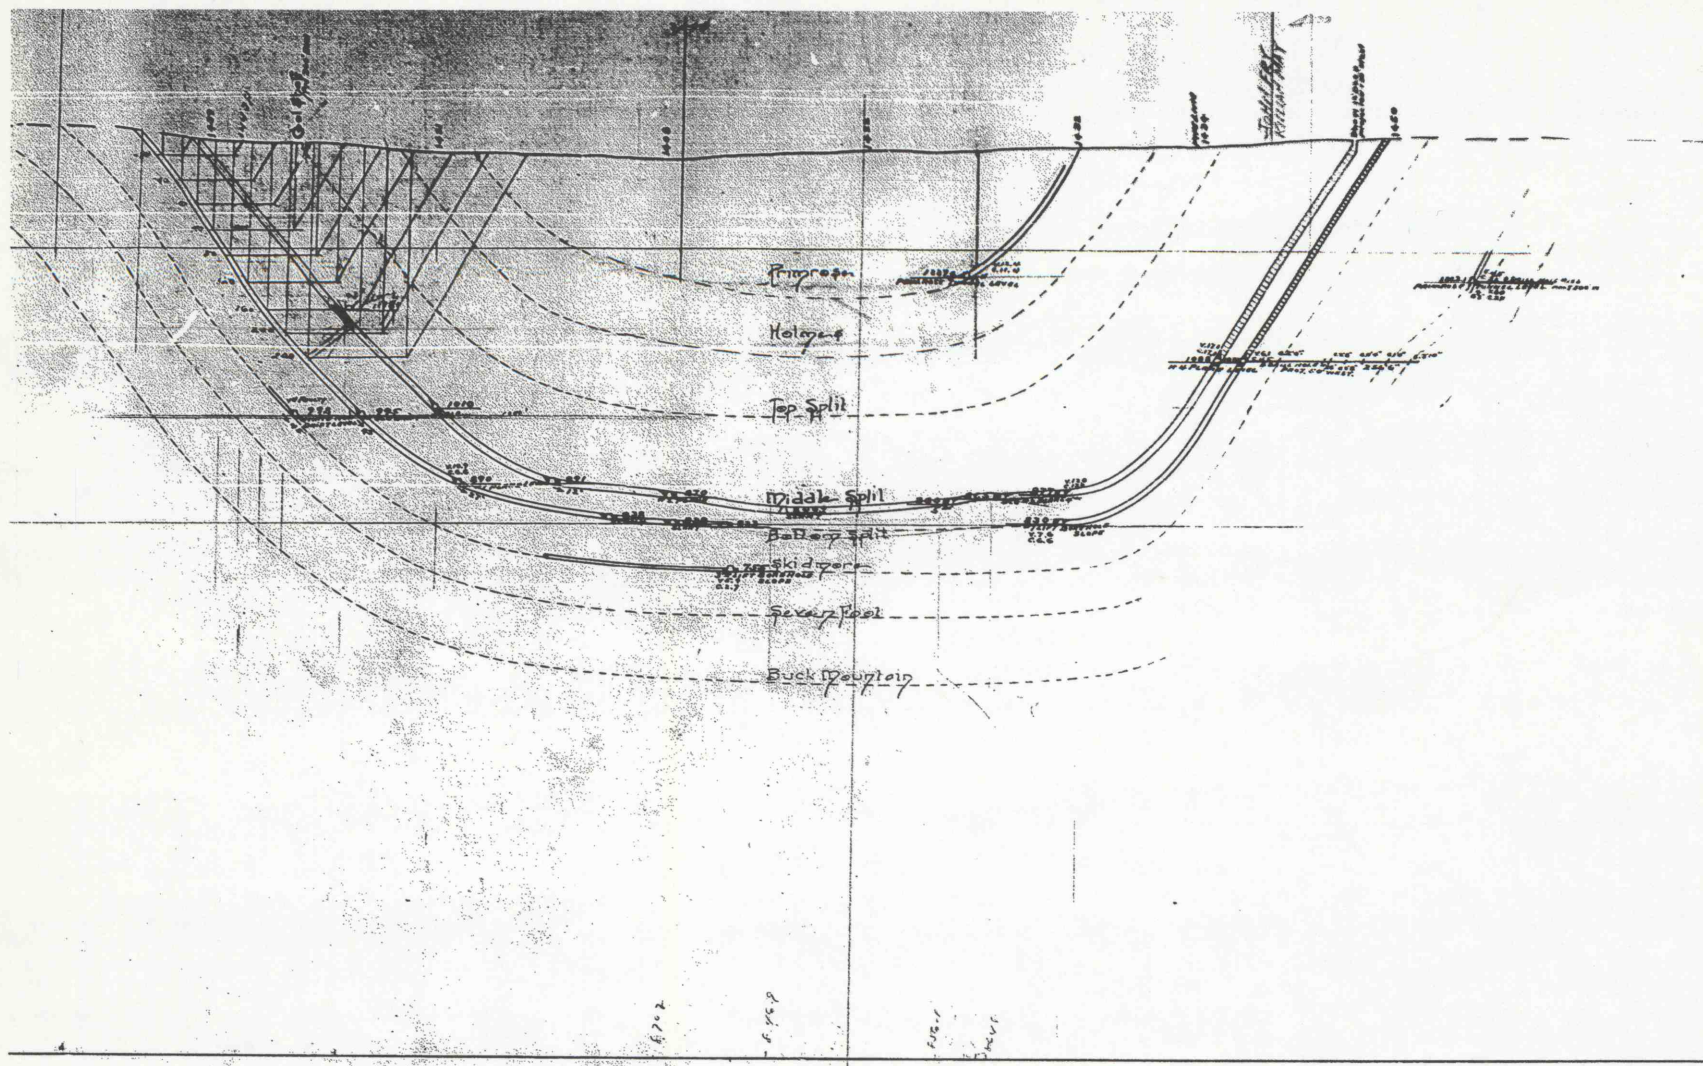

ROSS-SECTION #34

OTTO COLLIERY

4500' WEST OF #2 SHAFT

POTTSVILLE, PA.

MARCH 1924

1652