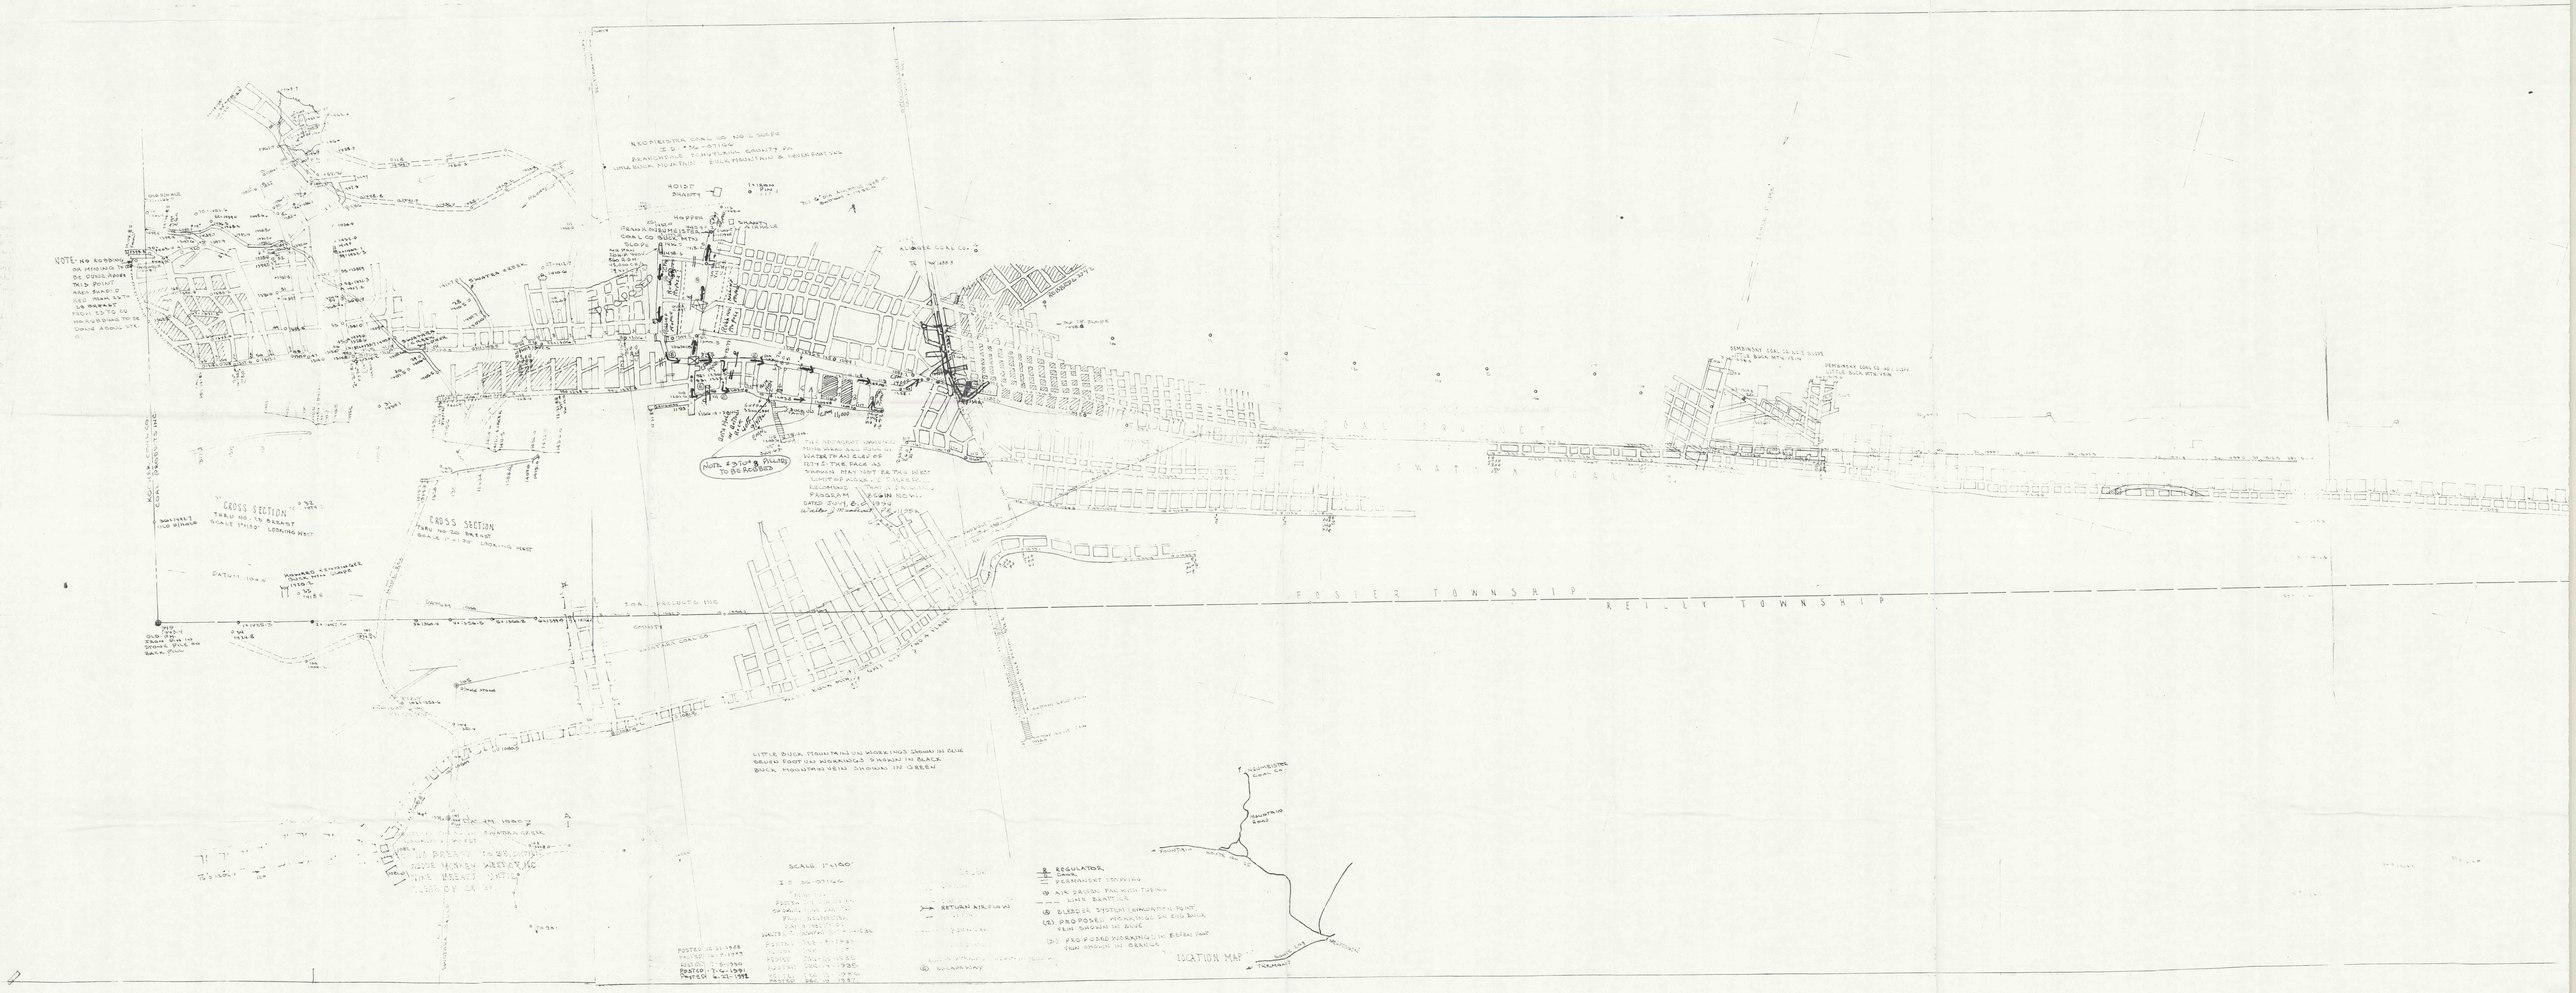
I.D. 50-07166
ZERAHLEHEM, SCHUYLKILL COUNTY, PA.
LITTLE BUCK MOUNTAIN - BUCK MOUNTAIN & GREEN POINT VEIN
HOIST
HOPPER
COAL CO. BUCK MTN.
SUPPLY
ALLOWABLE COAL CO.
SHANTER CREEK
NOTE: NO ROBBING ON MINING THE BE DONE ABOVE THIS POINT
NOTE: #3 TO #8 PILLARS TO BE ROBBED
"CROSS SECTION"
THRU NO. 20 BREAKT
SCALE 1"=20' LOOKING WEST
CROSS SECTION
THRU NO. 20 BREAKT
SCALE 1"=20' LOOKING WEST
PROPOSED PERMANENT STOPPING WITH DOOR
DATUM 1000
COAL PRODUCTS INC
COUNTY
SHANTER CREEK
OLD PIPE
EAST PIPE IN SINGLE PILE IN BACK PIN
FOSTER TOWNSHIP
REILLY TOWNSHIP
LITTLE BUCK MOUNTAIN WORKINGS SHOWN IN BLUE
SEVEN FOOT WORKINGS SHOWN IN BLACK
BUCK MOUNTAIN VEIN SHOWN IN GREEN
NO PRESENT TO BE DONE ABOVE THE PRESENT VERTICAL LIMIT OF CK 87
SCALE 1"=50'
I.D. 50-07166
REGULATOR
PERMANENT STOPPING
AIR DOOR FAN WITH TUBING
LINE BRATTICE
BLEEDER STATION (MINIMUM POINT)
PROPOSED MINING ON BUCK VEIN SHOWN IN BLUE
PROPOSED MINING ON BUCK VEIN SHOWN IN GREEN
RETURN AIR FLOW
LOCATION MAP
MOUNTAIN VIEW ROAD
MOUNTAIN VIEW
TOWNSHIP