

RED MEISTER COAL CO NO. 2 SLOPE  
 I.D. # 36-07166  
 BRANCHDALE, SCHUYLKILL COUNTY, PA.  
 LITTLE BUCK MOUNTAIN - BUCK MOUNTAIN & SEVEN FOOT VNS.


# FIVE STAGES OF FINAL PILLAR MINING

**STAGE NO. 1**  
 DATE  
 JULY 6, 1992

- STAGE 1 = START OF FINAL PILLAR MINING OUTLINED IN YELLOW.
  - STAGE 2 = OUTLINED IN PINK
  - STAGE 3 = OUTLINED IN BLUE
  - STAGE 4 = OUTLINED IN ORANGE
  - STAGE 5 = OUTLINED IN RED
- WHEN COMPLETED MINE WILL BE PERMANENTLY ABANDONED AND SEALED.

**BEP** BLEEDER EVALUATION POINT  
 KLINGER COAL CO. 4  
 8/23/91 FMN  
 7/19/91

- LEGEND**
- INTAKE AIR
  - RETURN AIR
  - == PERMANENT STOPPING
  - - - TEMPORARY STOPPING
  - ⊕ ESCAPEWAY

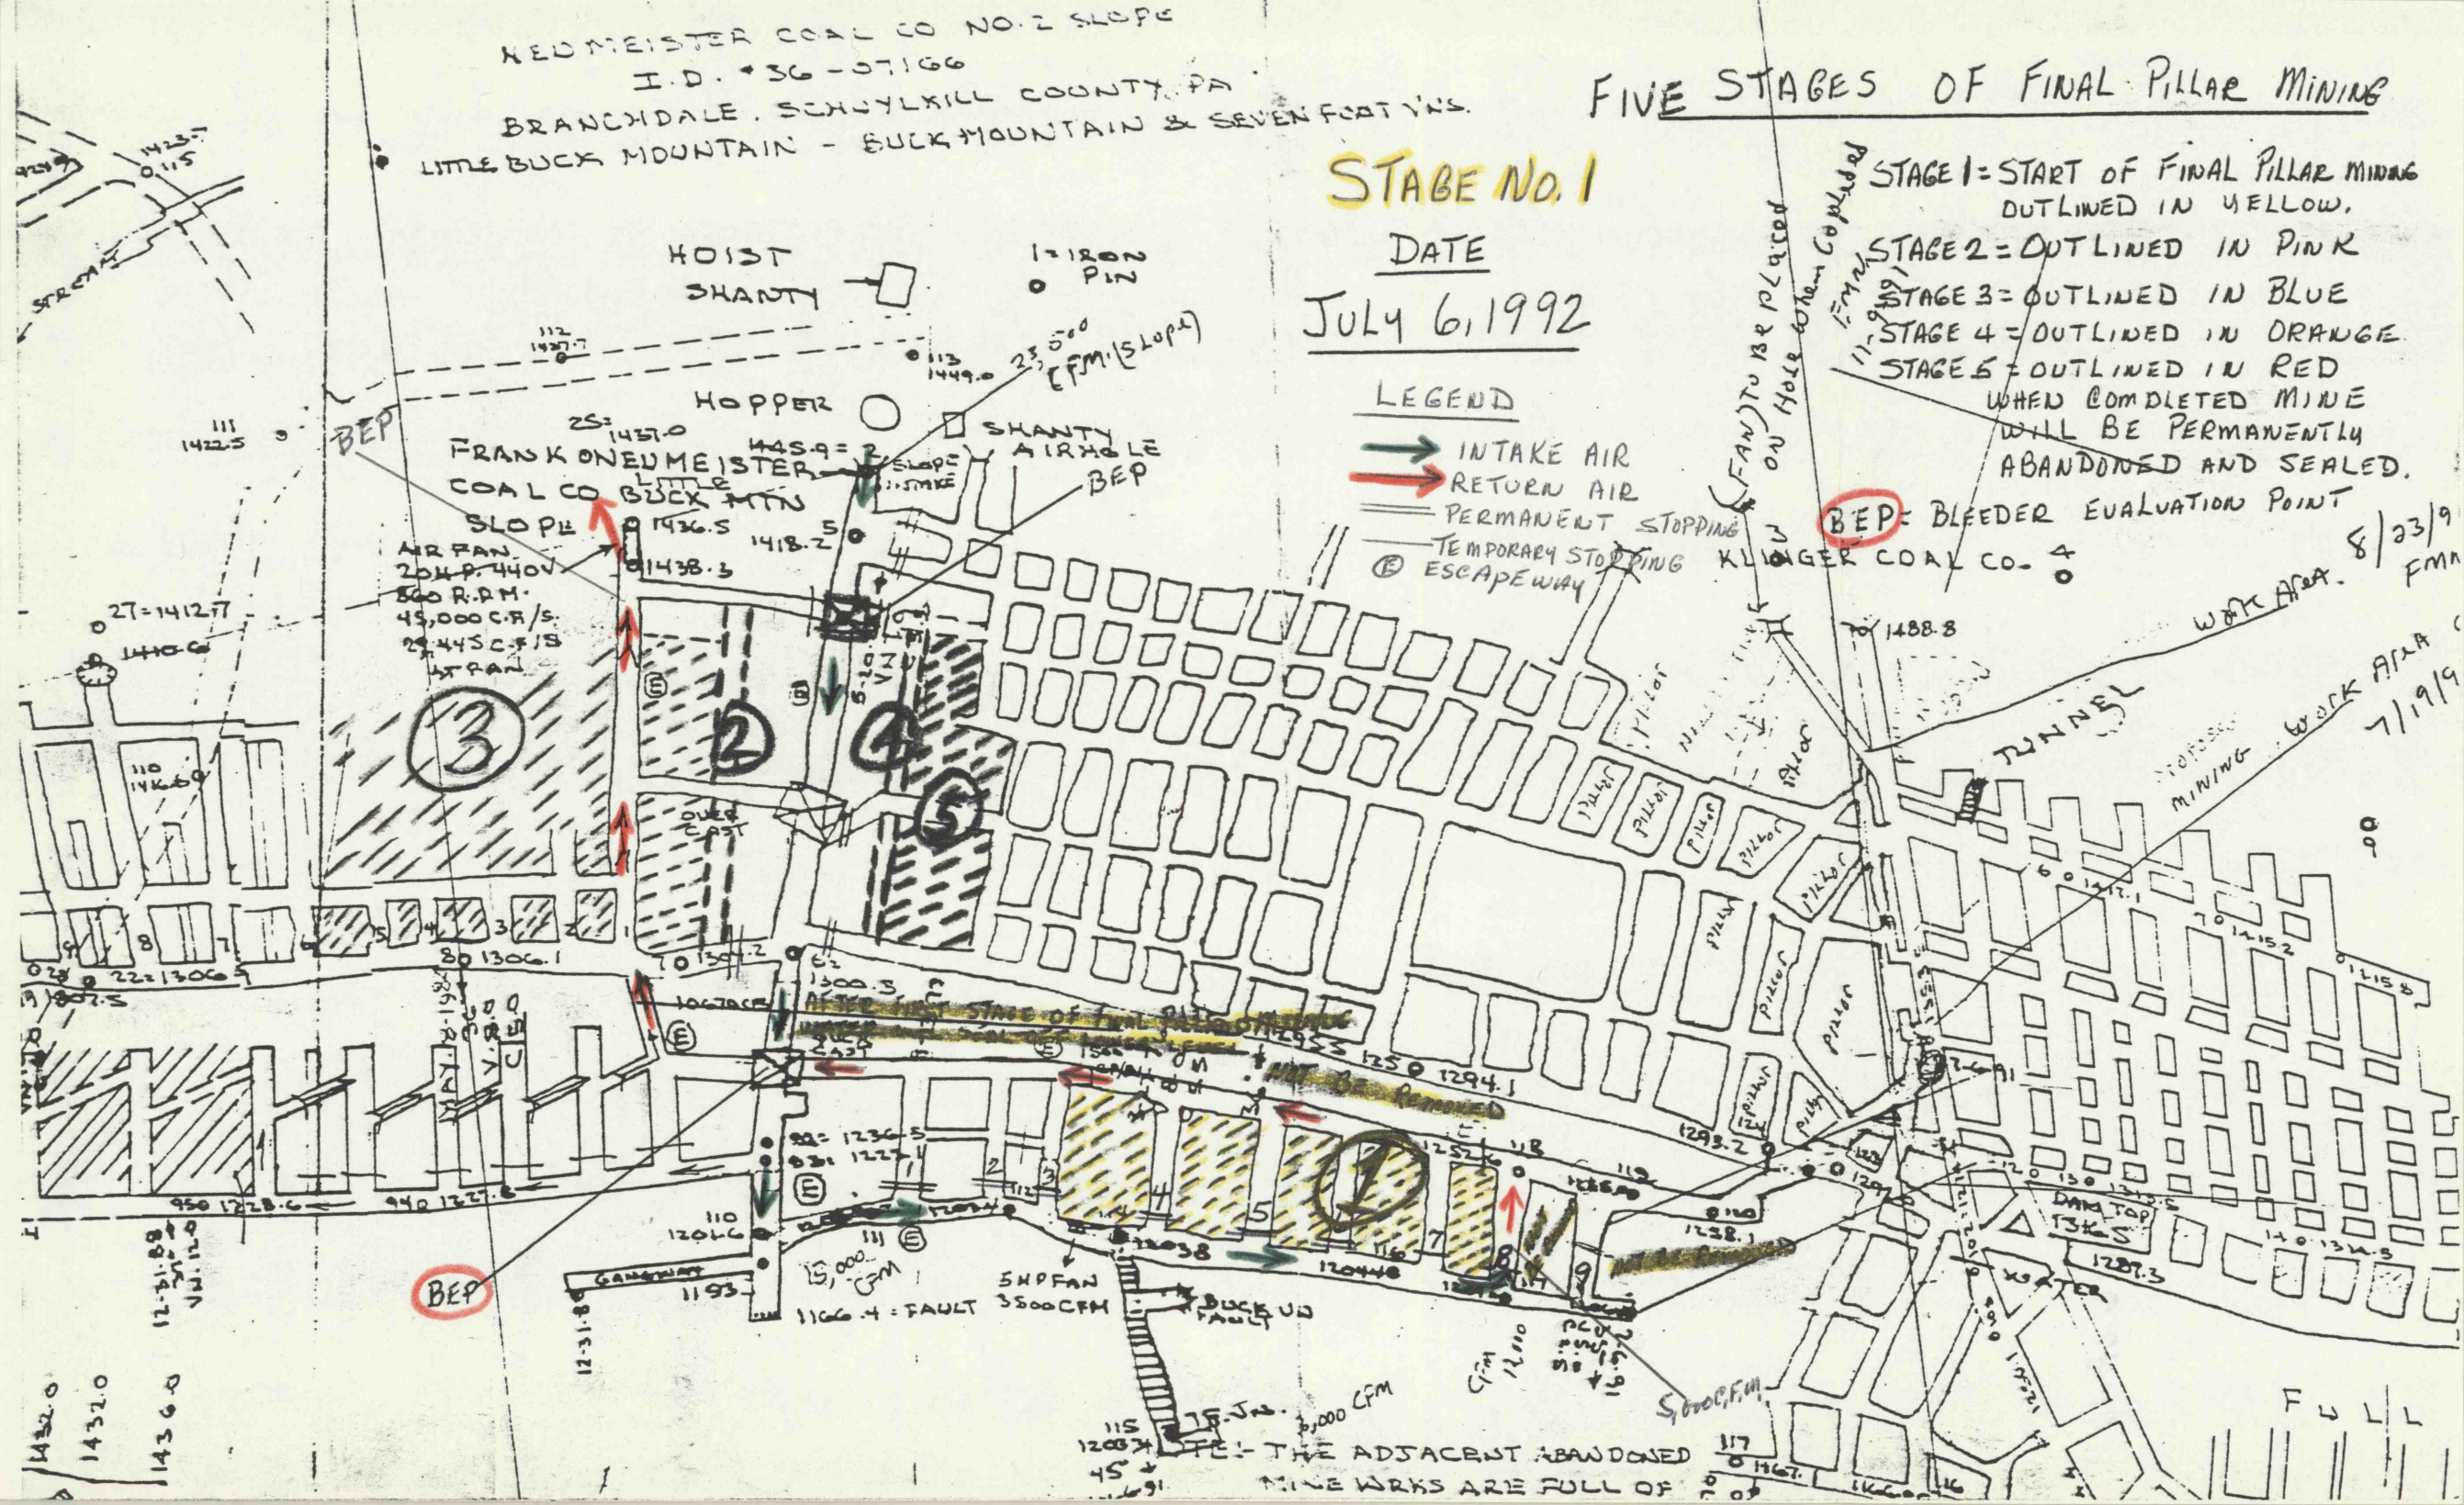

THE ADJACENT ABANDONED MINE WORKS ARE FULL OF