

KED MEISTER COAL CO NO. 2 SLOPE
 I.D. # 36-07166
 BRANCHDALE, SCHUYLKILL COUNTY, PA.
 LITTLE BUCK MOUNTAIN - BUCK MOUNTAIN & SEVEN FOOT VNS.

FIVE STAGES OF FINAL PILLAR MINING

STAGE NO. 2

DATE
 JULY 6, 1992


- STAGE 1 = START OF FINAL PILLAR MINING OUTLINED IN YELLOW.
- STAGE 2 = OUTLINED IN PINK
- STAGE 3 = OUTLINED IN BLUE
- STAGE 4 = OUTLINED IN ORANGE
- STAGE 5 = OUTLINED IN RED WHEN COMPLETED MINE WILL BE PERMANENTLY ABANDONED AND SEALED.

LEGEND

- INTAKE AIR
- RETURN AIR
- PERMANENT STOPPING
- TEMPORARY STOPPING
- ESCAPEWAY
- AIR MOVER WITH TUBING

BEP BLEEDER EVALUATION POINT

KLINGER COAL CO. 4

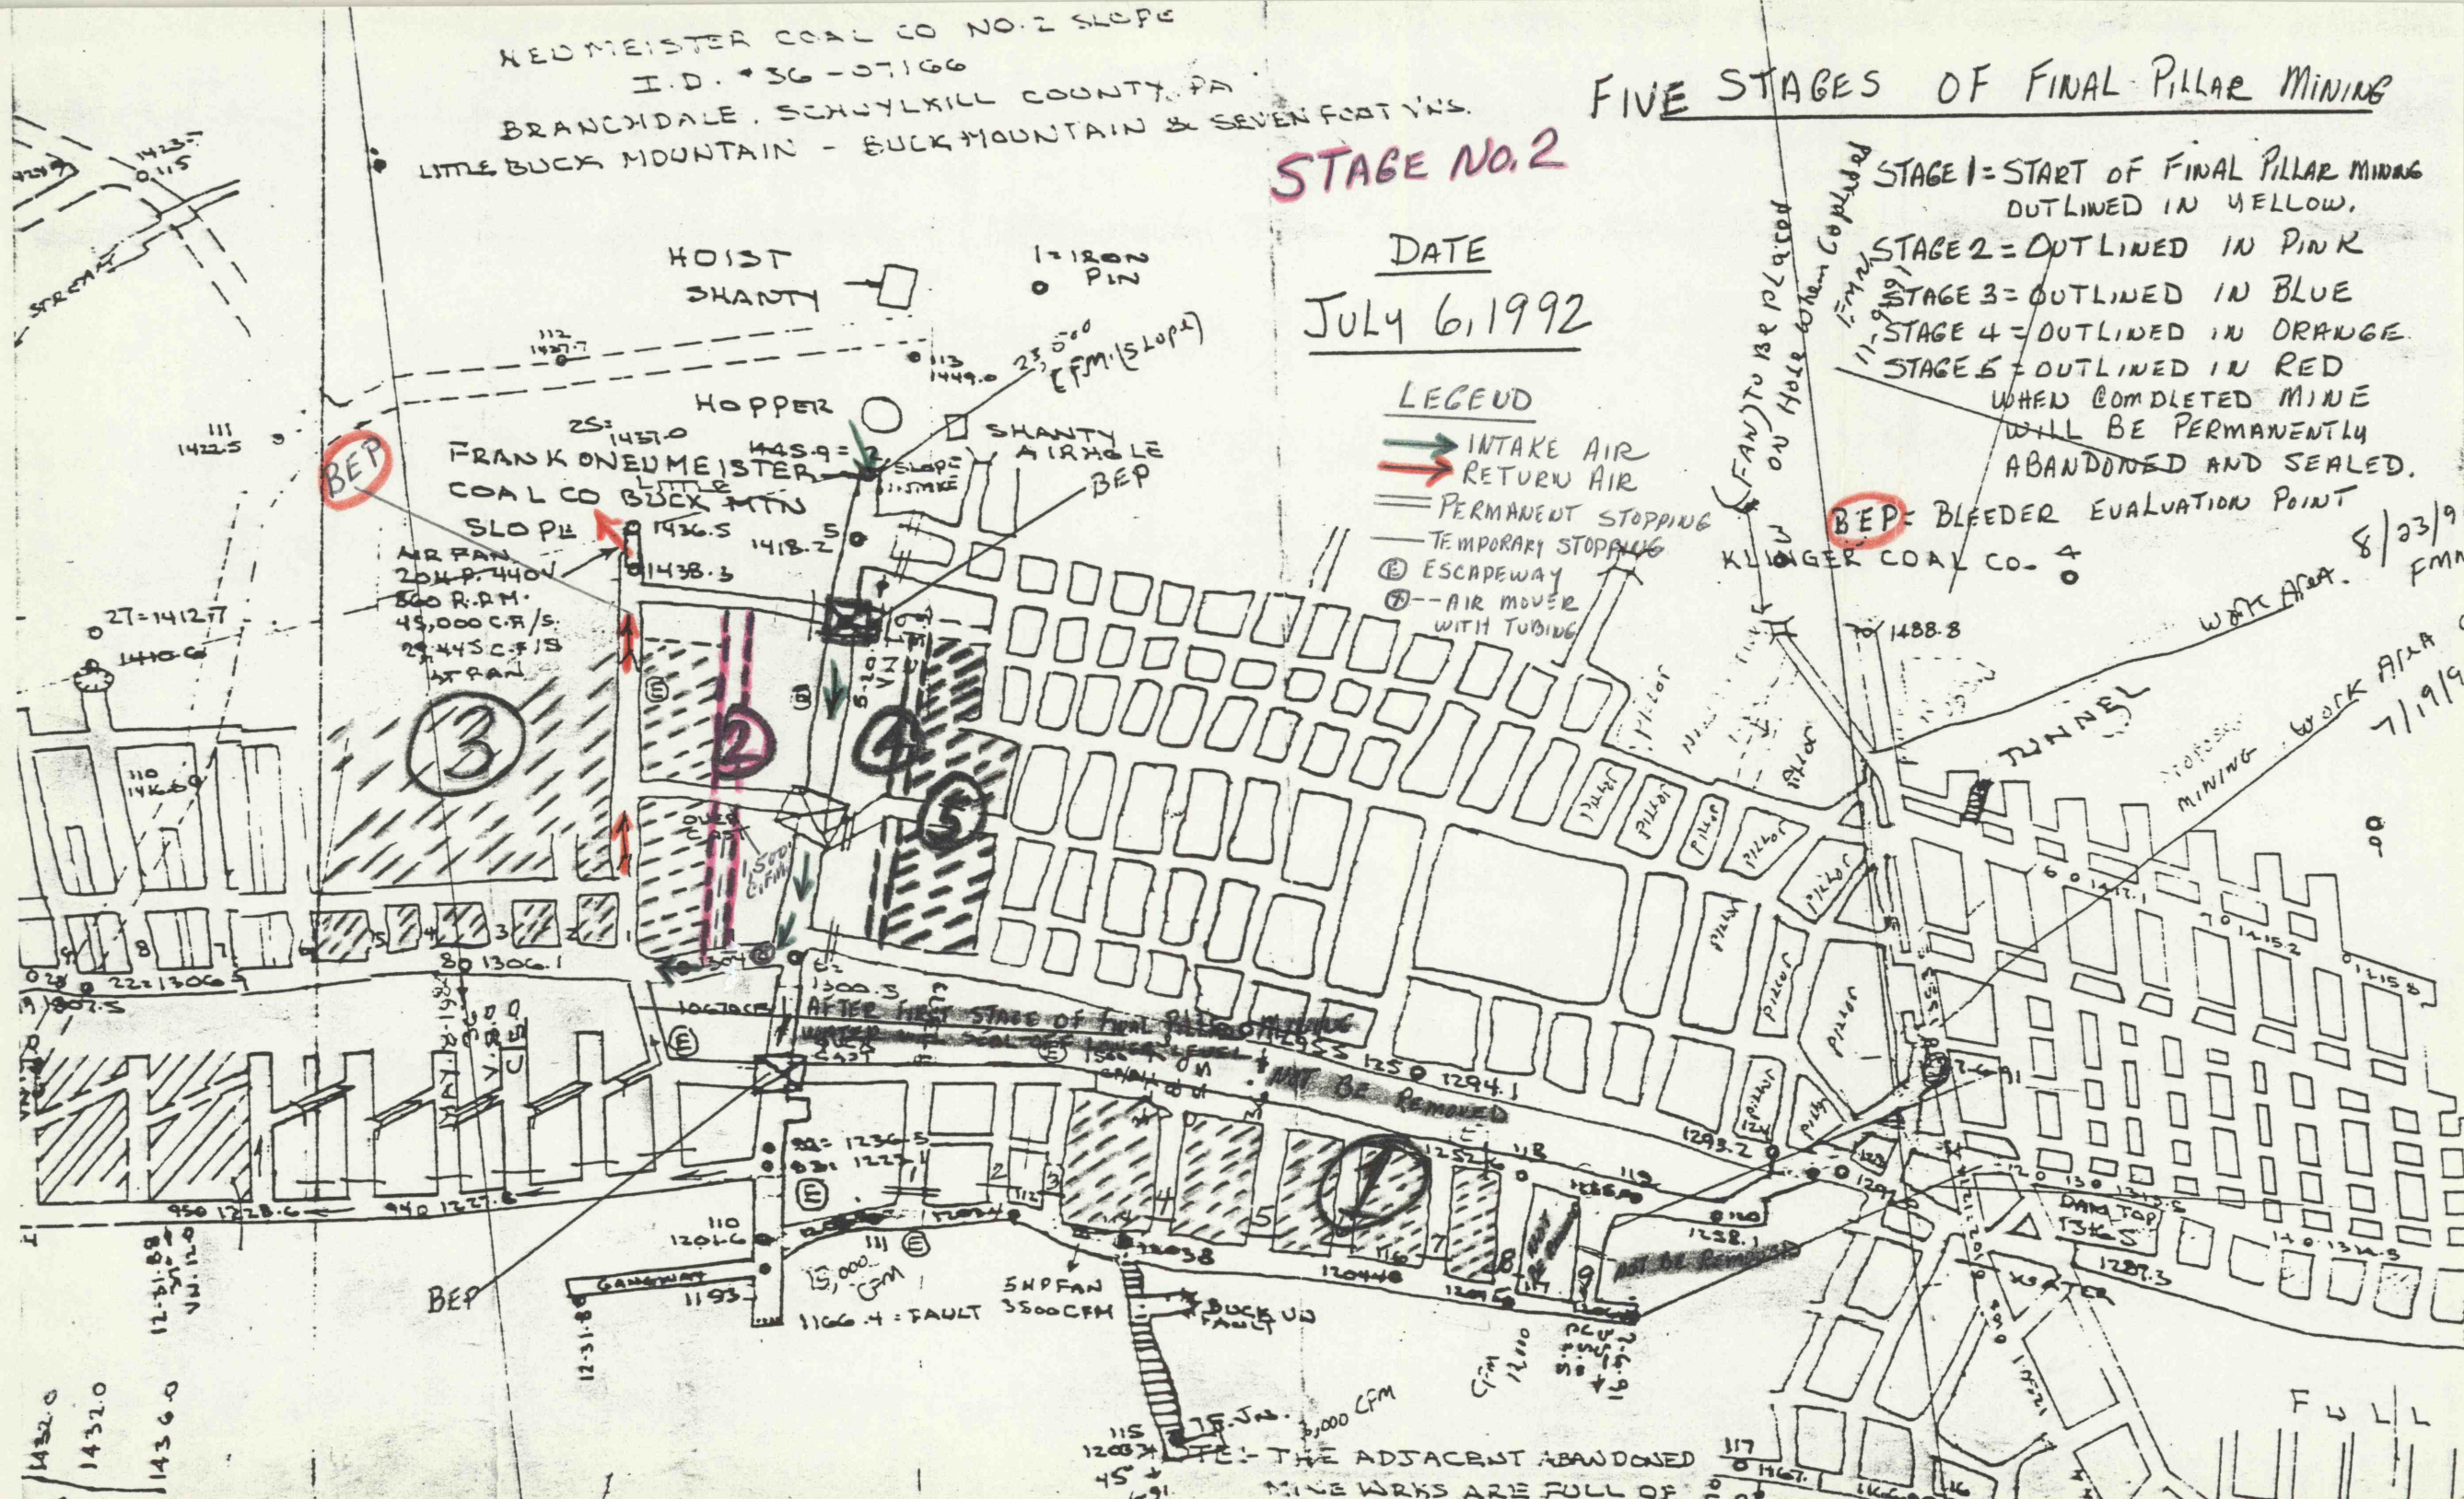

THE ADJACENT ABANDONED
 MINE WORKS ARE FULL OF