


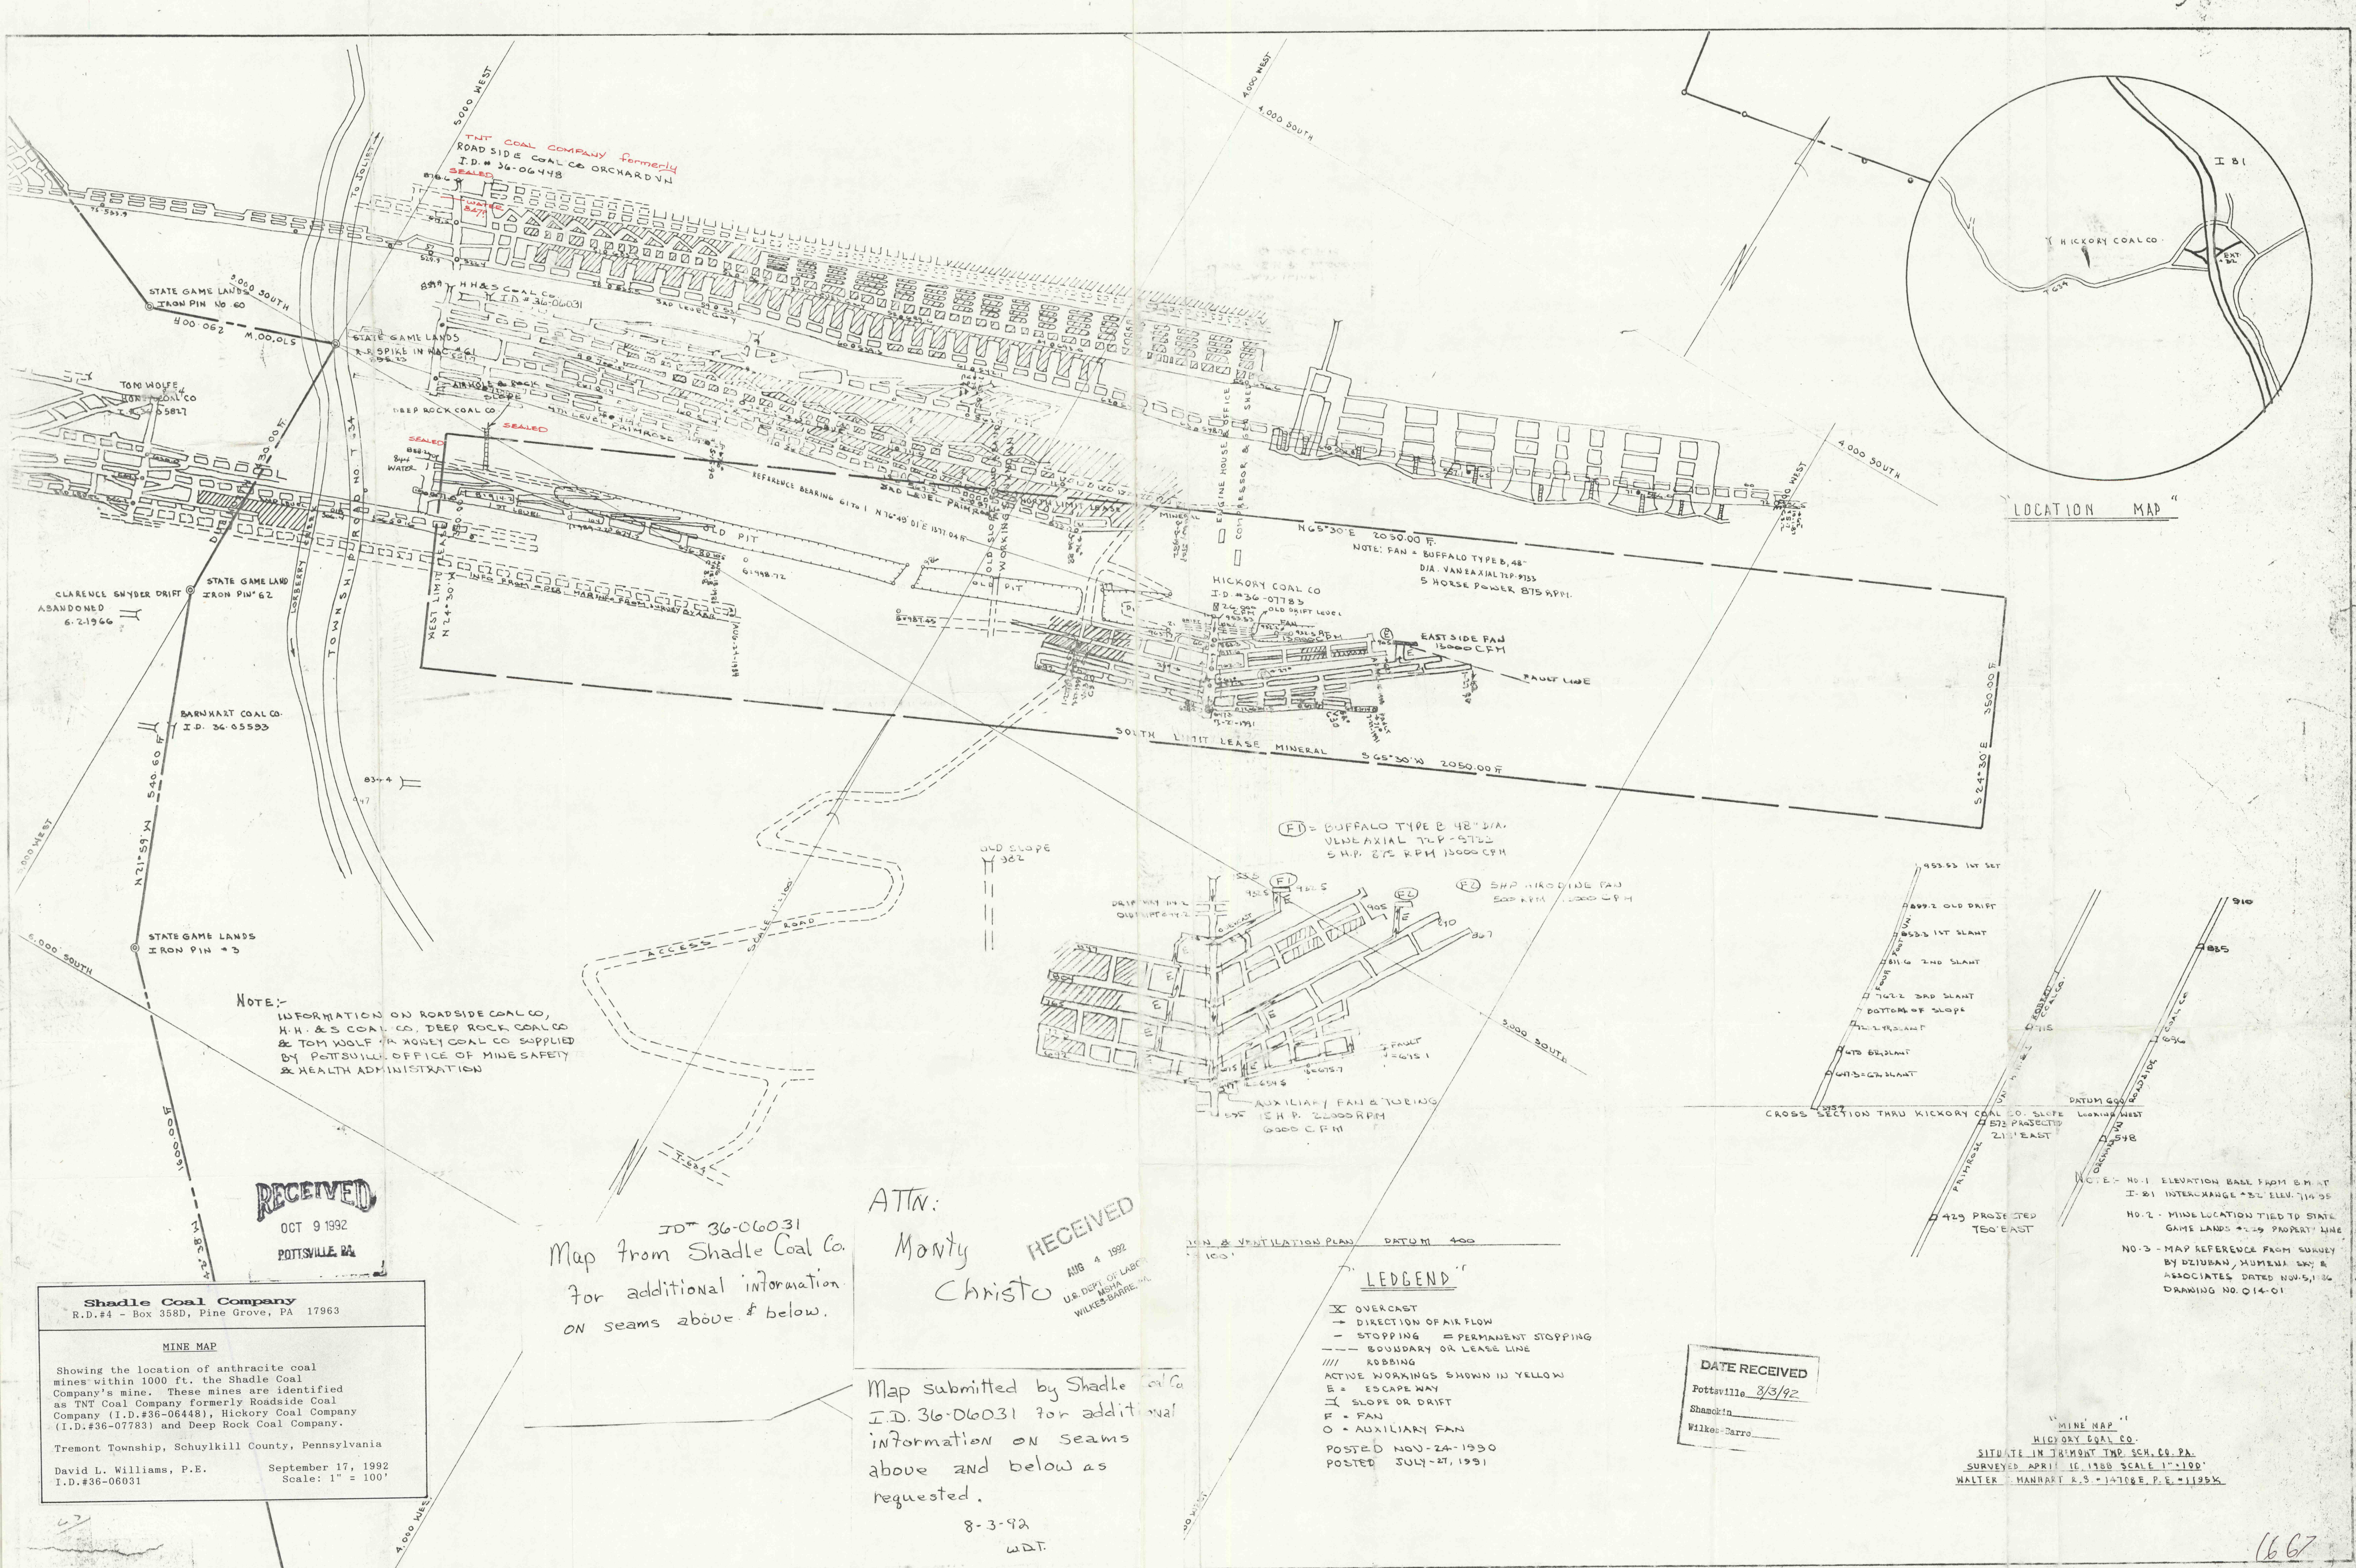

Shadle Coal Company
R.D.#4 - Box 358D, Pine Grove, PA 17963

MINE MAP

Showing the location of anthracite coal mines within 1000 ft. the Shadle Coal Company's mine. These mines are identified as TNT Coal Company formerly Roadside Coal Company (I.D.#36-06448), Hickory Coal Company (I.D.#36-07783) and Deep Rock Coal Company.

Tremont Township, Schuylkill County, Pennsylvania

David L. Williams, P.E. September 17, 1992
I.D.#36-06031 Scale: 1" = 100'

RECEIVED
OCT 9 1992
POTTSVILLE, PA

ATTN: Monty Christo
Map from Shadle Coal Co.
for additional information
on seams above & below.

RECEIVED
AUG 4 1992
U.S. DEPT. OF LABOR
MINE SAFETY & HEALTH
WILKES-BARRE, PA

Map submitted by Shadle Coal Co.
I.D. 36-06031 for additional
information on seams
above and below as
requested.

8-3-92
W.D.T.

LEGEND

- X OVERCAST
 - DIRECTION OF AIR FLOW
 - STOPPING = PERMANENT STOPPING
 - - - BOUNDARY OR LEASE LINE
 - |||| ROBBING
 - ACTIVE WORKINGS SHOWN IN YELLOW
 - E = ESCAPE WAY
 - = SLOPE OR DRIFT
 - F = FAN
 - O = AUXILIARY FAN
- POSTED NOV-24-1990
POSTED JULY-27-1991

DATE RECEIVED
Pottsville 8/3/92
Shanklin
Wilkes-Barre

MINE MAP
HICKORY COAL CO.
SITUATE IN TREMONT TWP. SCH. CO. PA.
SURVEYED APRIL 16, 1989 SCALE 1"=100'
WALTER J. MANNHART R.S. 14708 P.E. 1195K