



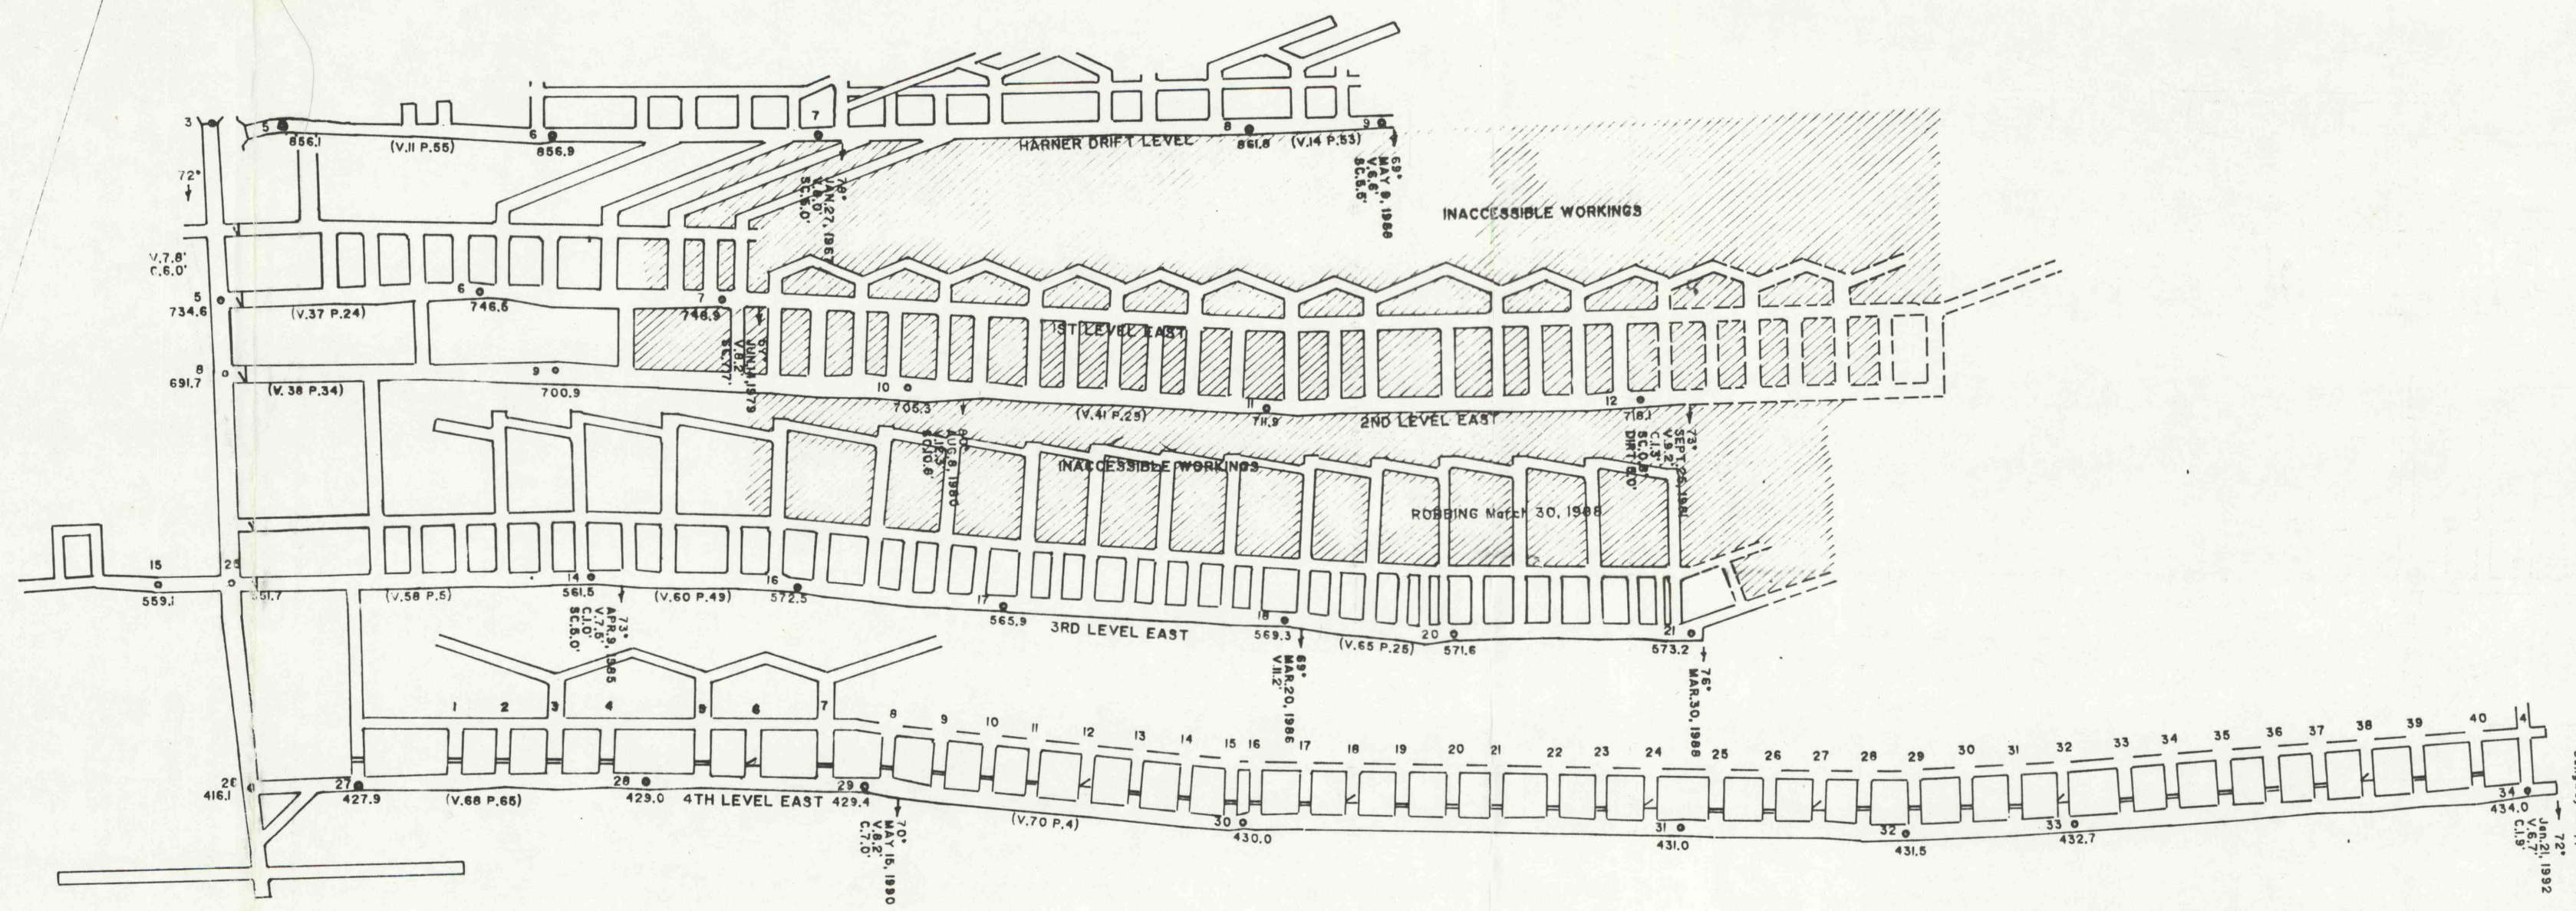

LONGITUDINAL SECTION
for the
SHADLE COAL COMPANY
situate in
Tremont Township, Schuylkill County

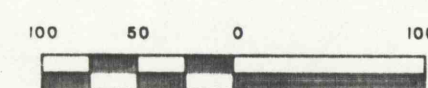

Scale 1 inch = 100 feet

I.D.#36-06031

SURVEY REFERENCE
Gerrett Vol.75 Pg.62
Riedel Vol.33 Pg.32
Vol.36 Pg.10
Vol.37 Pg.24
Vol.38 Pg.34
Vol.41 Pg.29
Vol.59 Pg.5
Vol.60 Pg.49
Vol.65 Pg.25
Vol.68 Pg.65
Vol.71 Pg.55
Vol.74 Pg.53
Vol.70 Pg.9
Vol.71 Pg.19