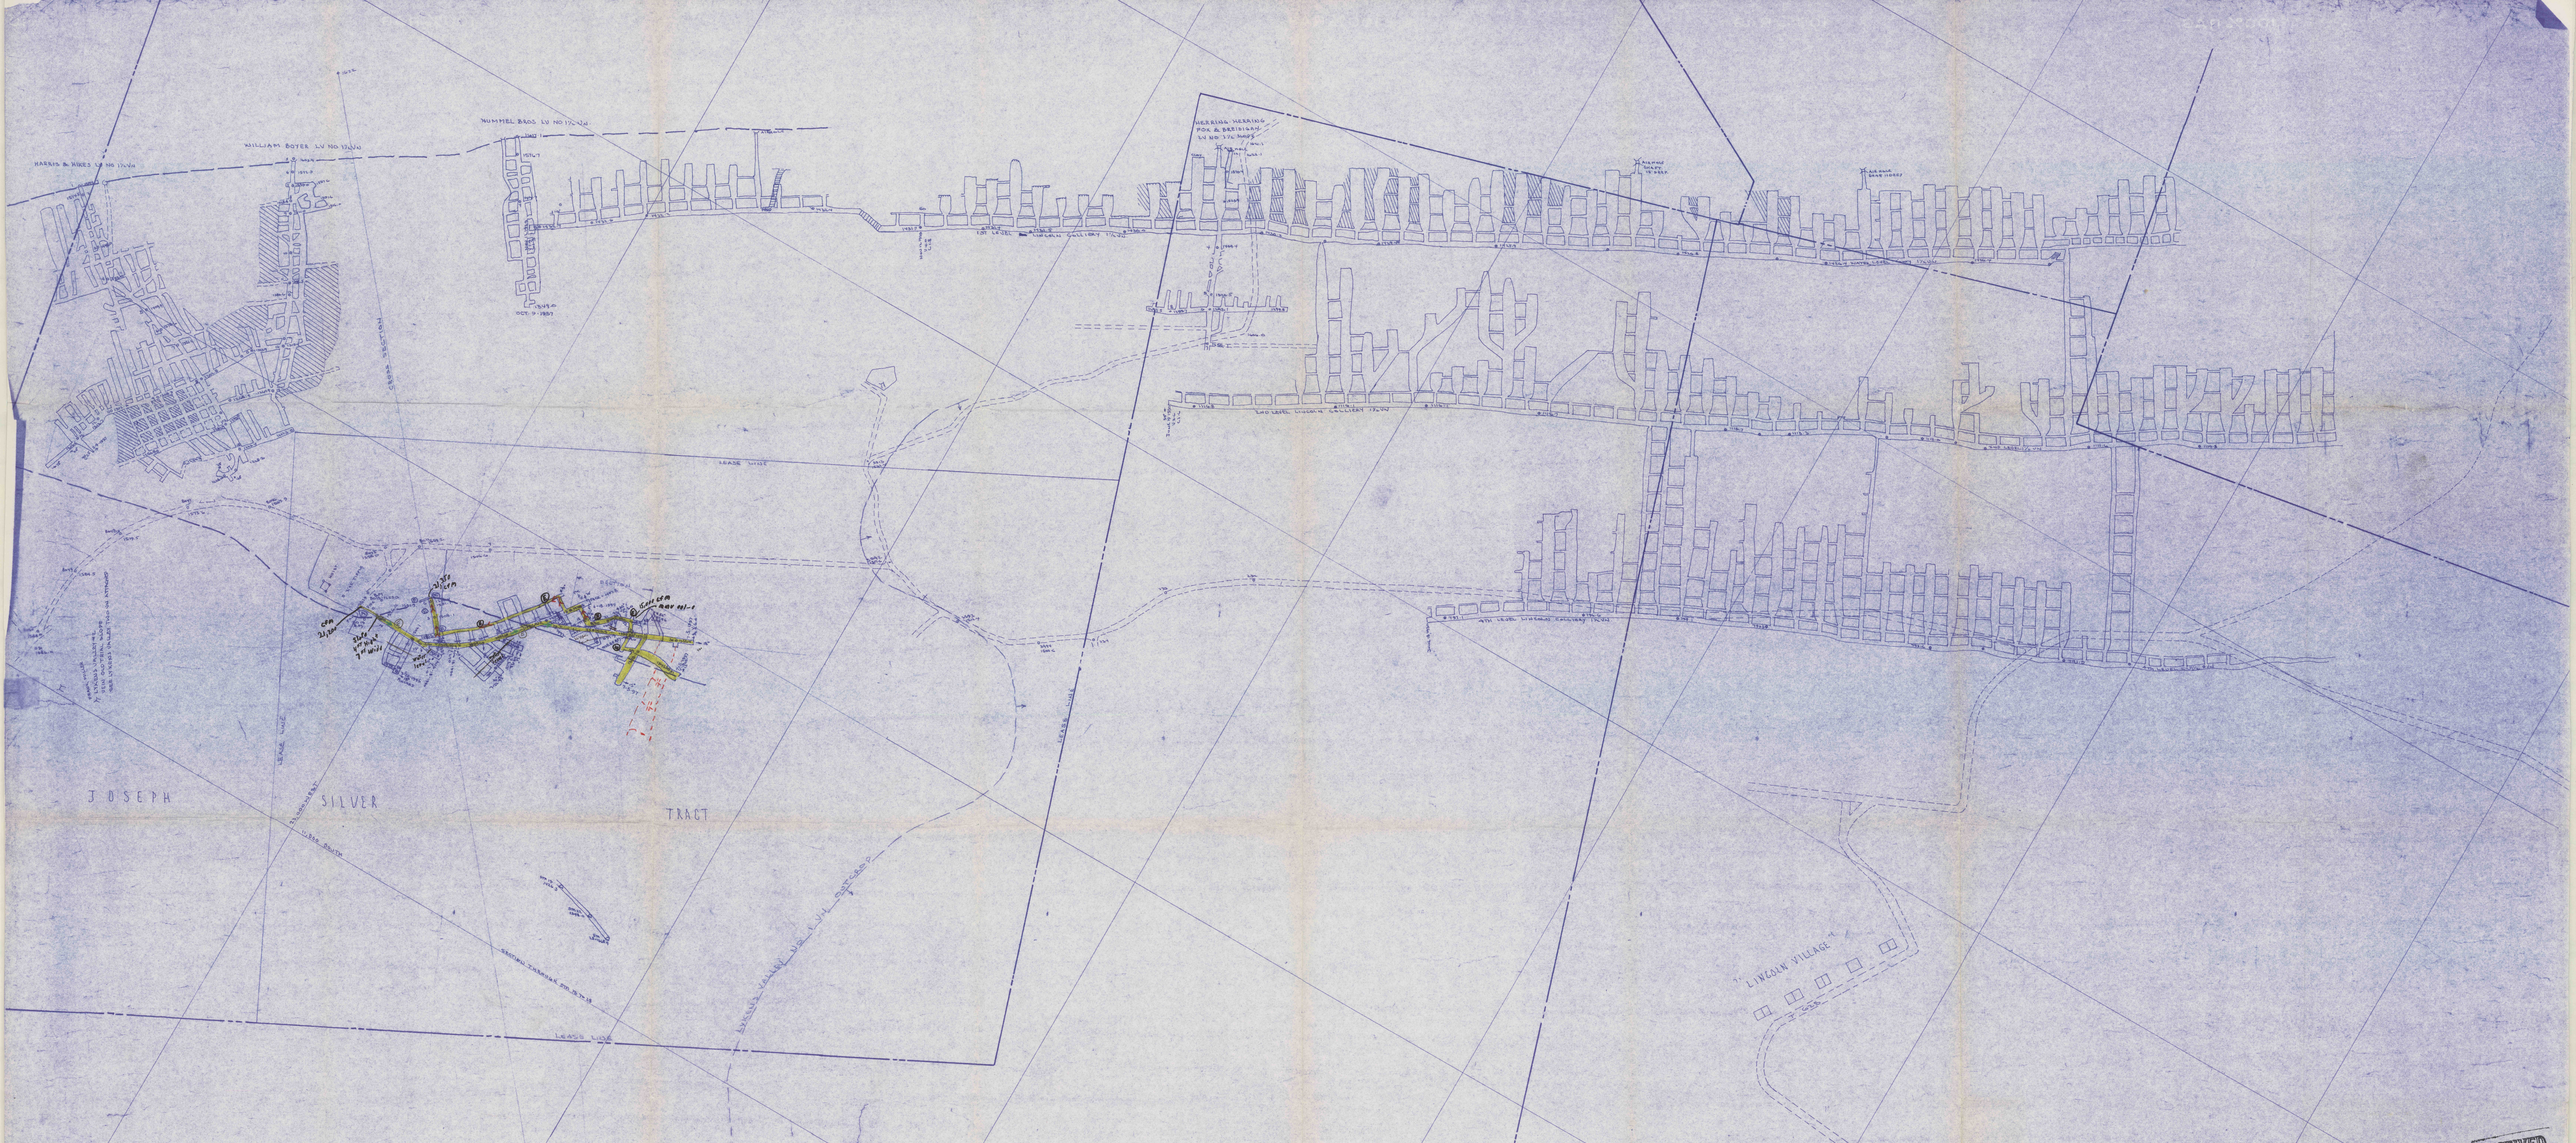JOSEPH SILVER TRACT
"LINCOLN VILLAGE"
B.M.
8014 - D/HOLE STONE 10,433.92 SOUTH - 23,110.58 WEST
8013 - D/HOLE STONE 10,356.00 SOUTH - 23,098.00 WEST
AIR READINGS
THE AIR READINGS SHOWN ON THIS MAP WHERE NOT TAKEN BY ME, THEREFORE I AM NOT RESPONSIBLE FOR THEIR ACCURACY.
Ⓐ = SLOPE
Ⓑ = LAST CROSS CUT
Ⓒ = AIRHOLE FAN
FAN INFORMATION
FAN SIZE = 4 FOOT DIA
MAKE = NO NAME PLATE
TYPE = FIXED BLADE
CAPACITY = 30,000 C.F.M
POWERED BY = INTERNAL COMBUSTION - 130 HP.
RPM - VARIABLE SPEED
WATER GAGE = 1"
Buffalo Type B Vane axial
BELT DRIVEN
ENGINE 250 cubic inches
"LEDGEND"
DOOR = D
STOPPING = ═ ‖
OVERCAST = ⊠
BRATTIC = —
DIRECTION OF AIR INTAKE → EXHAUST ↣
REGULATOR - R
CURTAIN OR CHECK = C
FAN = Ⓕ
F = 30,000
ESCAPEWAY Ⓔ
PROPOSED NEW WORKINGS - - -
BENCH MARK BM
UNLIMITED LEASE
BONDED AREA OUTLINED IN RED
MINE POOL ELEV. 960
OVERFLOWS OUT OF ROWE TUNNEL
POSTED AUG. 18, 1990
POSTED JUNE 29, 1991
POSTED JULY 18, 1992
POSTED JUNE 29. 1993
POSTED JUNE 18. 1994
POSTED JULY 22. 1995
POSTED JULY 27, 1996
POSTED JULY 5. 1997
"MINE MAP"
TREMONT TWP. SCH. CO. PA.
SHOWING L. V. NO. 1½ VN. SLOPE OF
GIBSON HARNER & MADENFORD
SURVEYED JULY 8, 1989 SCALE 1" = 100'
WALTER J. MANHART R. S. #14708E
NOW
WEST END COAL CO. DEEP MINE
ID # 36-07859
LAST CHANCE SLOPE
COMMONWEALTH OF PENNSYLVANIA REGISTERED WALTER J. MANHART SURVEYOR No. 14708-E
RECEIVED AUG 0 6 1997 POTTSVILLE, PA.
Received AUG 1 3 1997 U.S. DEPT. OF LABOR MSHA WILKES-BARRE, PA
683