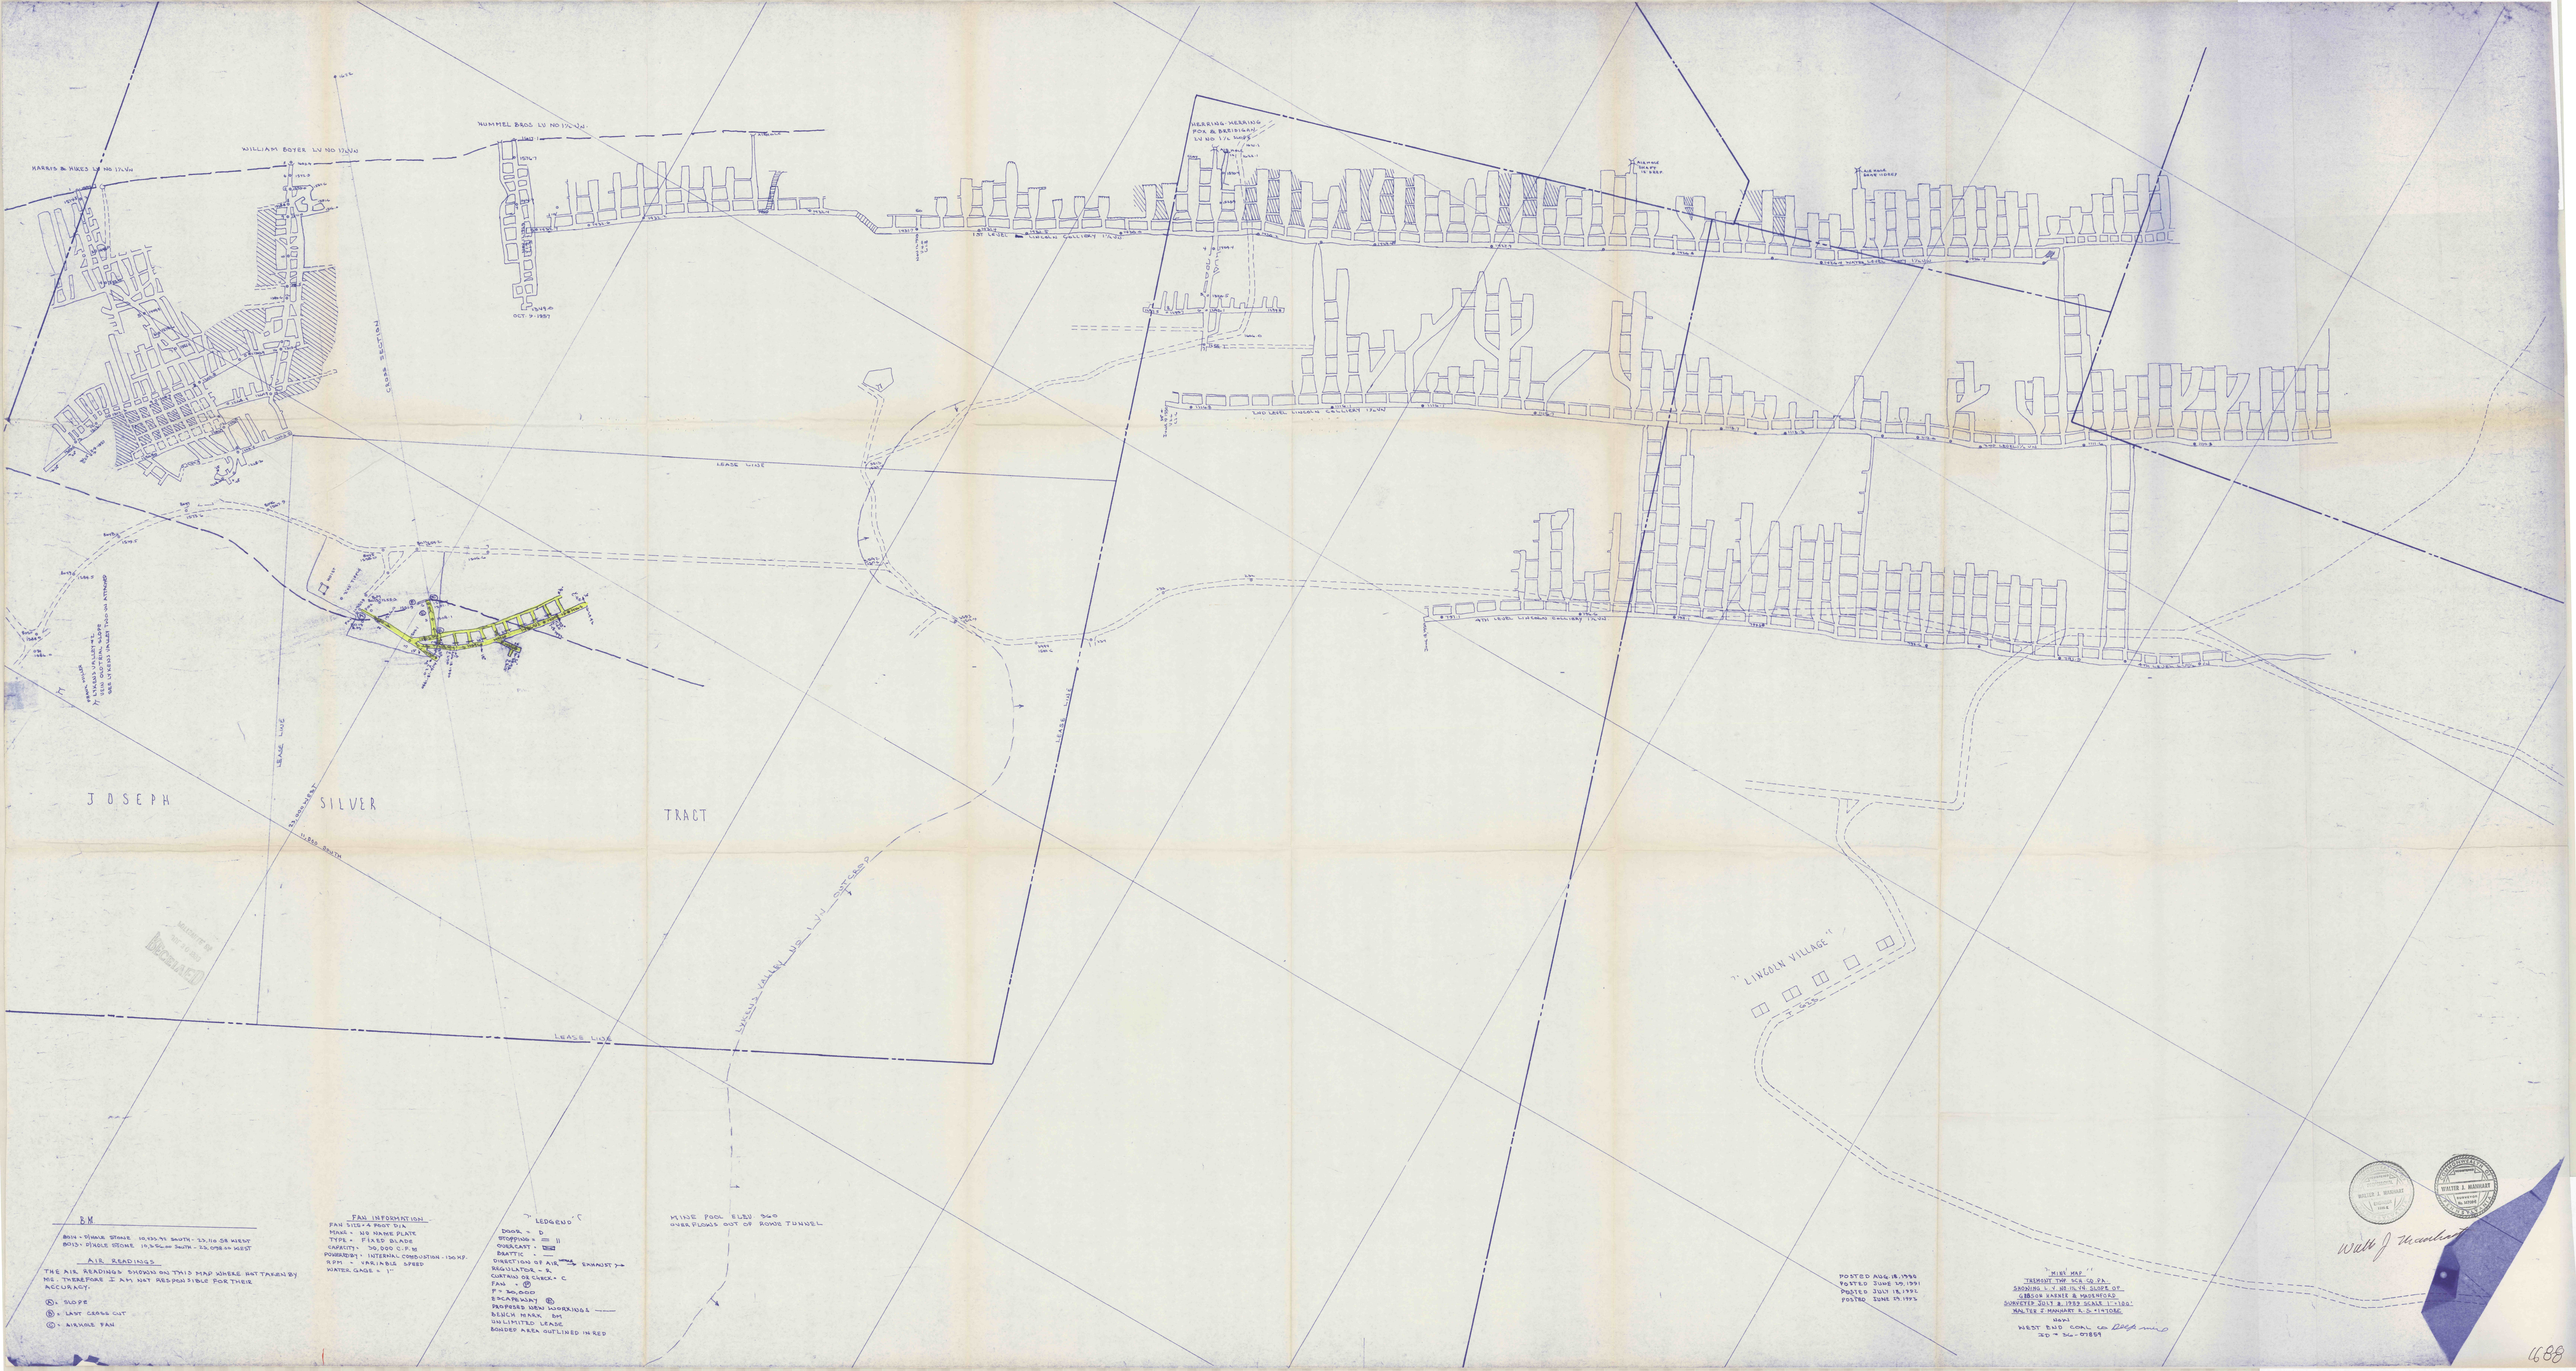
HARRIS & MIKES LV NO 17.W
WILLIAM BOYER LV NO 17.W
HUMMEL BROS LV NO 17.W
HERRING HERRING FOX & BRESIGAN LV NO 17.W
OCT 9-1957
LEASE LINE
JOSEPH SILVER TRACT
LINCOLN VILLAGE
LINCOLN VALLEY
LEASE LINE
BM
BRIN - HIMME STONE 10,935.99 SOUTH - 23,116.08 WEST
BOIS - PIADLE STONE 19,956.00 SOUTH - 23,058.00 WEST
AIR READINGS
THE AIR READINGS SHOWN ON THIS MAP WHERE NOT TAKEN BY ME, THEREFORE I AM NOT RESPONSIBLE FOR THEIR ACCURACY.
Ⓢ - SLOPE
Ⓛ - LAST CROSS CUT
Ⓐ - AIRHOLE FAN
FAN INFORMATION
FAN SITE - 4 FOOT DIA.
MAKE - NO NAME PLATE
TYPE - FIXED BLADE
CAPACITY - 30,000 C.F.M.
POWERED - INTERNAL COMBUSTION - 150 HP.
R.P.M. - VARIABLE SPEED
WATER GAGE - 1"
LEGEND
DOOR - D
STOPPING - ||
OVERCAST - OC
BRATTICE - —
DIRECTION OF AIR - EXHAUST
REGULATOR - R
CURTAIN OR CHECK - C
FAN - Ⓕ
F - 30,000
EXCAVATION
PROPOSED NEW WORKINGS
BLOCK MAP BM
UNLIMITED LEASE
BORDER AREA OUTLINED IN RED
MINE POOL ELEV 360
OVERFLOWS OUT OF ROMOE TUNNEL
POSTED AUG 18, 1990
POSTED JUNE 30, 1991
POSTED JULY 18, 1992
POSTED JUNE 19, 1993
"MINE MAP"
TRESKOW THE BCB CO. PA.
SHOWING L.V. NO 16, 19, SLOPE OF
GIBBON BARNES & MATSKOVICH
SURVEYED JULY 8, 1959 SCALE 1"=100'
WALTER E. MAGRARY R.S. 1-13106
MINE
WEST END COAL CO. Delp mine
ID # 36-07859
WALTER E. MAGRARY
REGISTERED PROFESSIONAL ENGINEER
No. 13106
Walter E. Magrary
4688