


J A C O B C H R I S T T R A C T

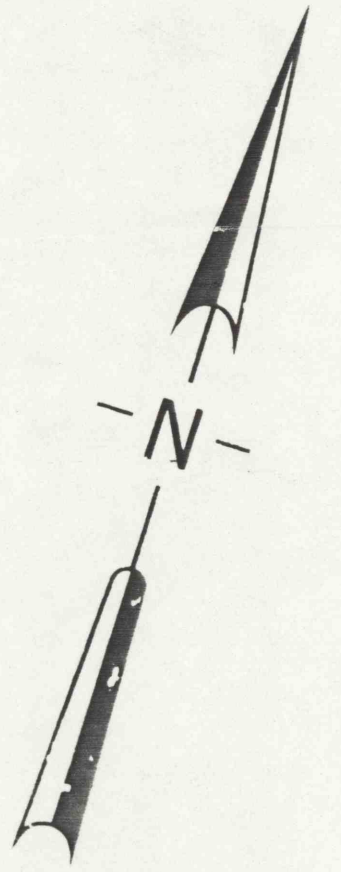

H E N R Y W E A V E R



- VENTILATION SYMBOLS**
- (F) = Main Fan
 - (A) = Auxiliary Fan
 - = Air Flow - Intake
 - ← = Air Flow - Exhaust
 - = Permanent Stopping
 - - - = Temporary Stopping
 - ⊗ = Air Bridge
 - R = Regulator
 - ∇ = Man Door
 - V = Velocity, fpm
 - Q = Quantity, cfm
 - WG = Water Gauge
 - (E) = Escapeway
 - BEP = Bleeder Evaluation Point

K I L L I A N M I N E

R A C T

H E N R Y S H A F F E R

MINE MAP
 Showing the location and extent of development of the Mountain View Coal Company slope mine. Situate on the south dip Lykens Valley #6 vein, Barry Township, Schuylkill County.
 A.B. Riedel, P.E. October 14, 1991
 Scale 1"=100'

Robert B. Riedel