


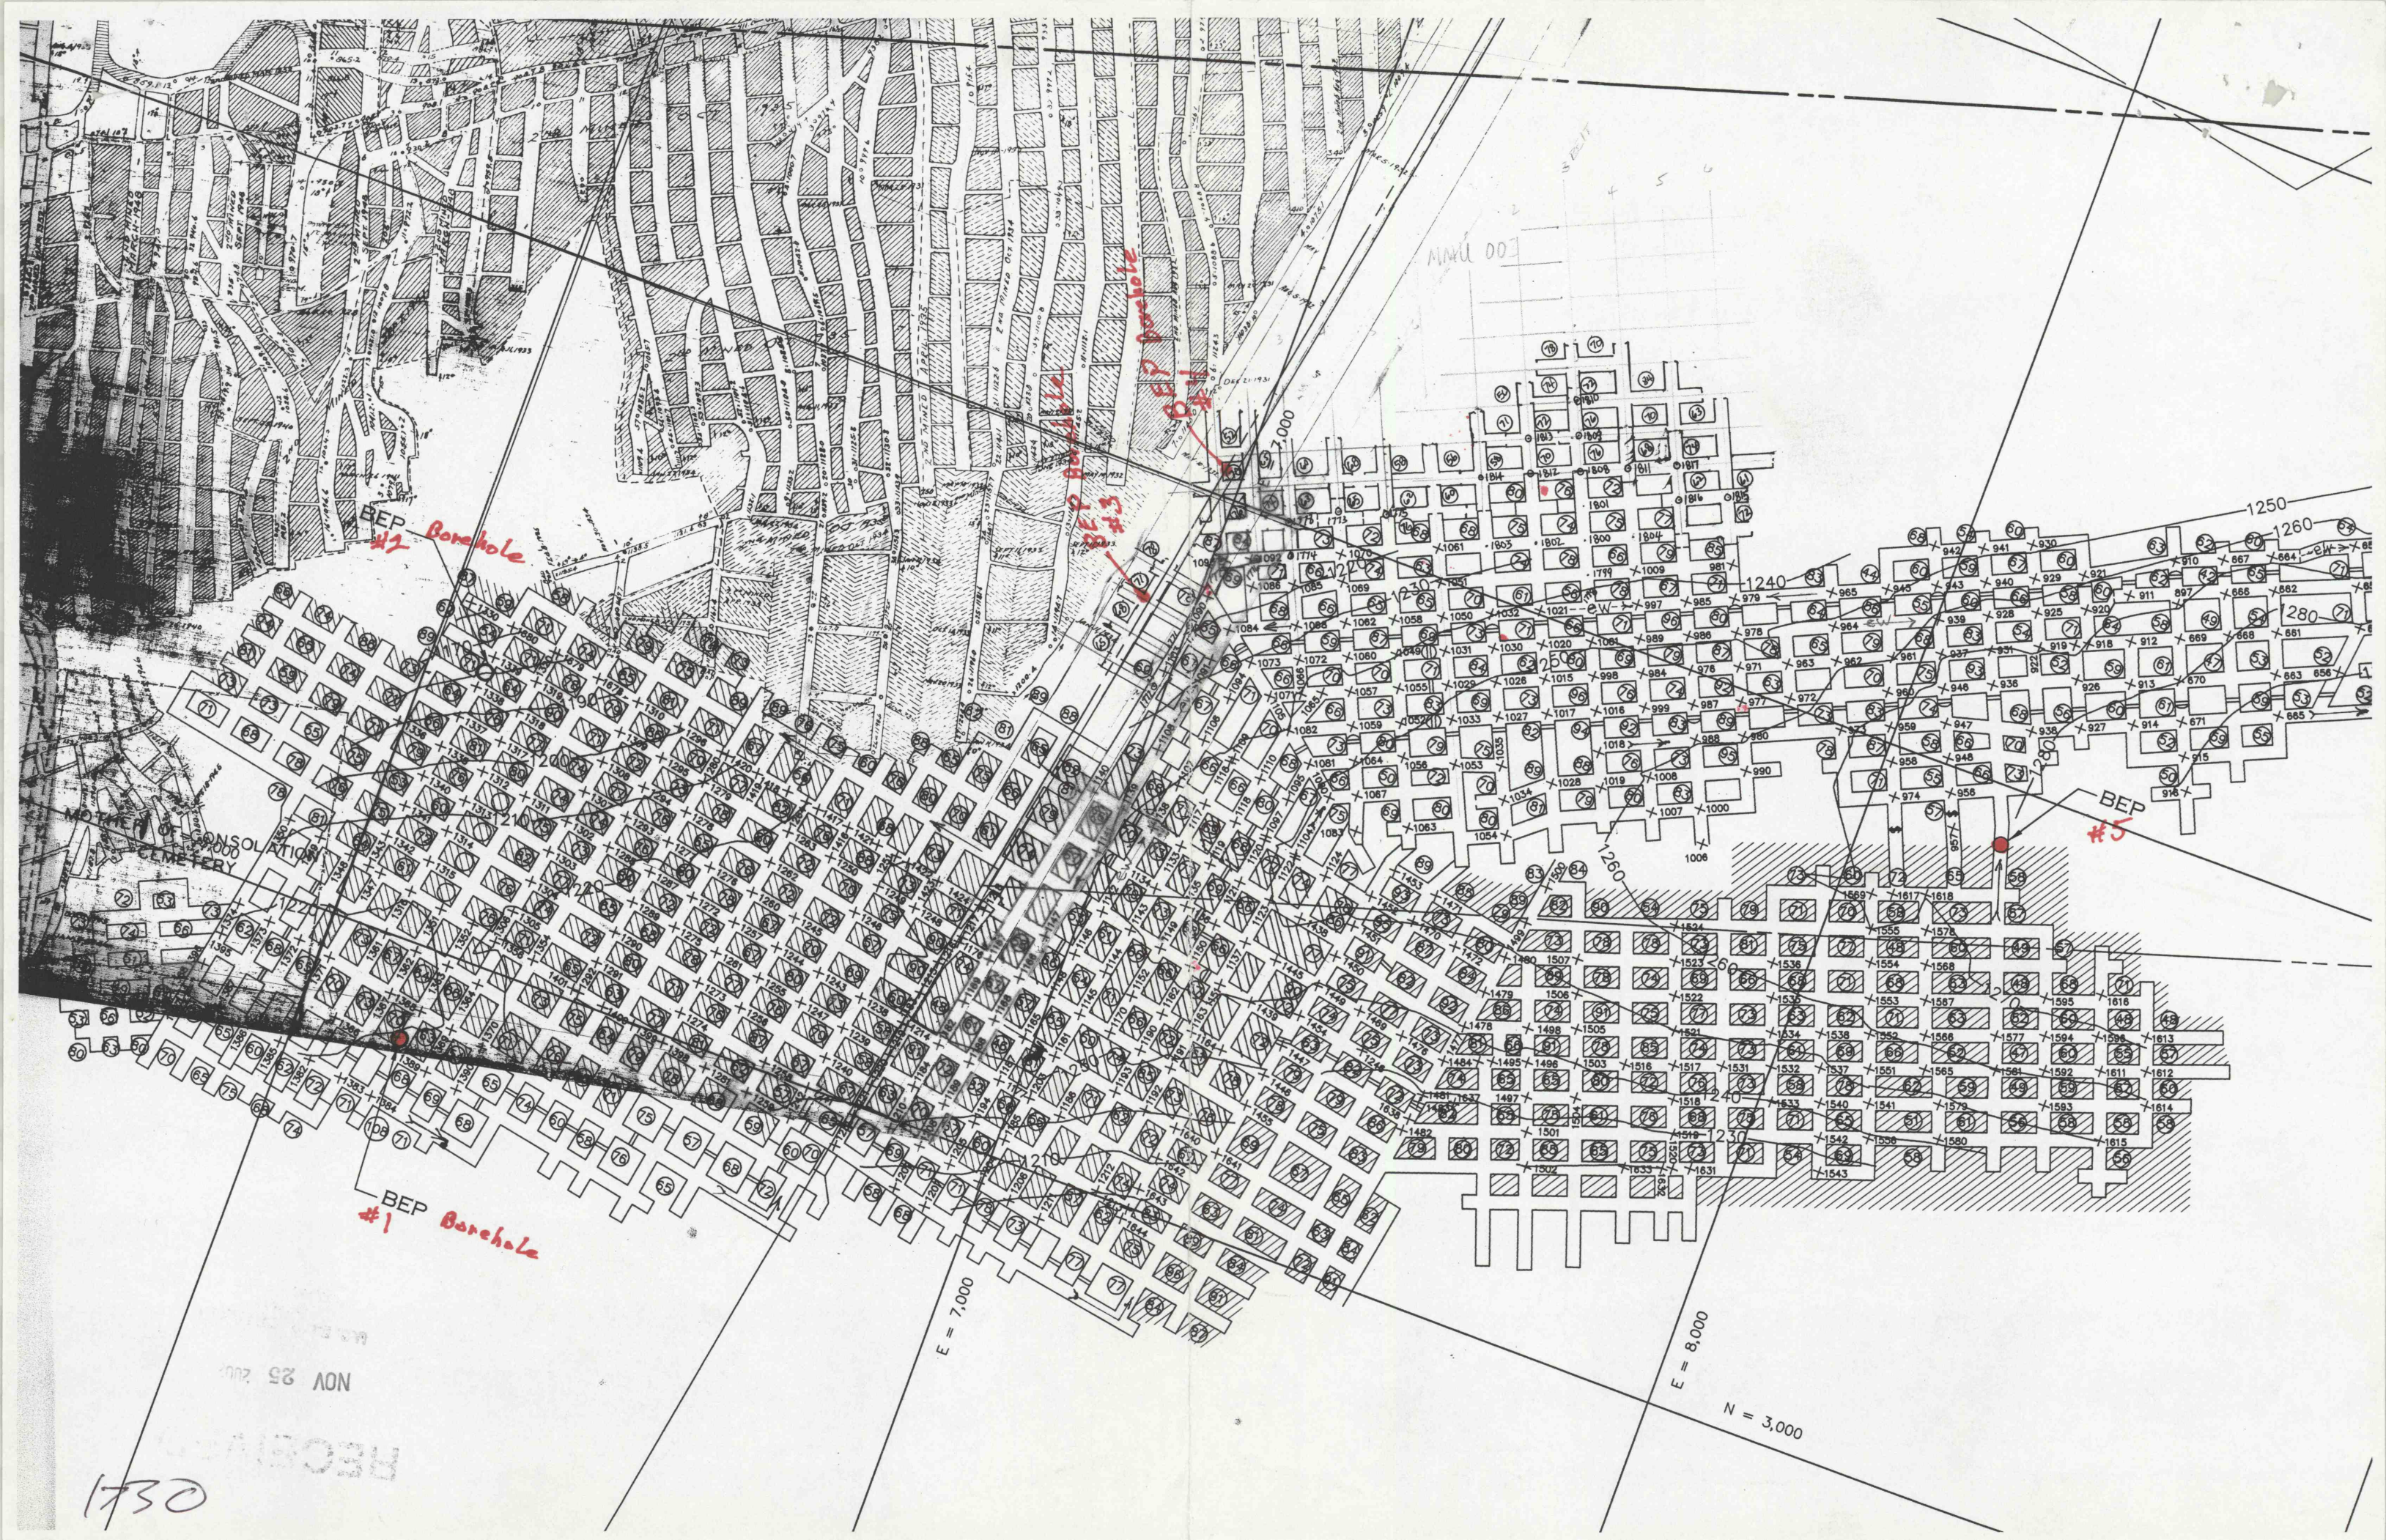

1730


