


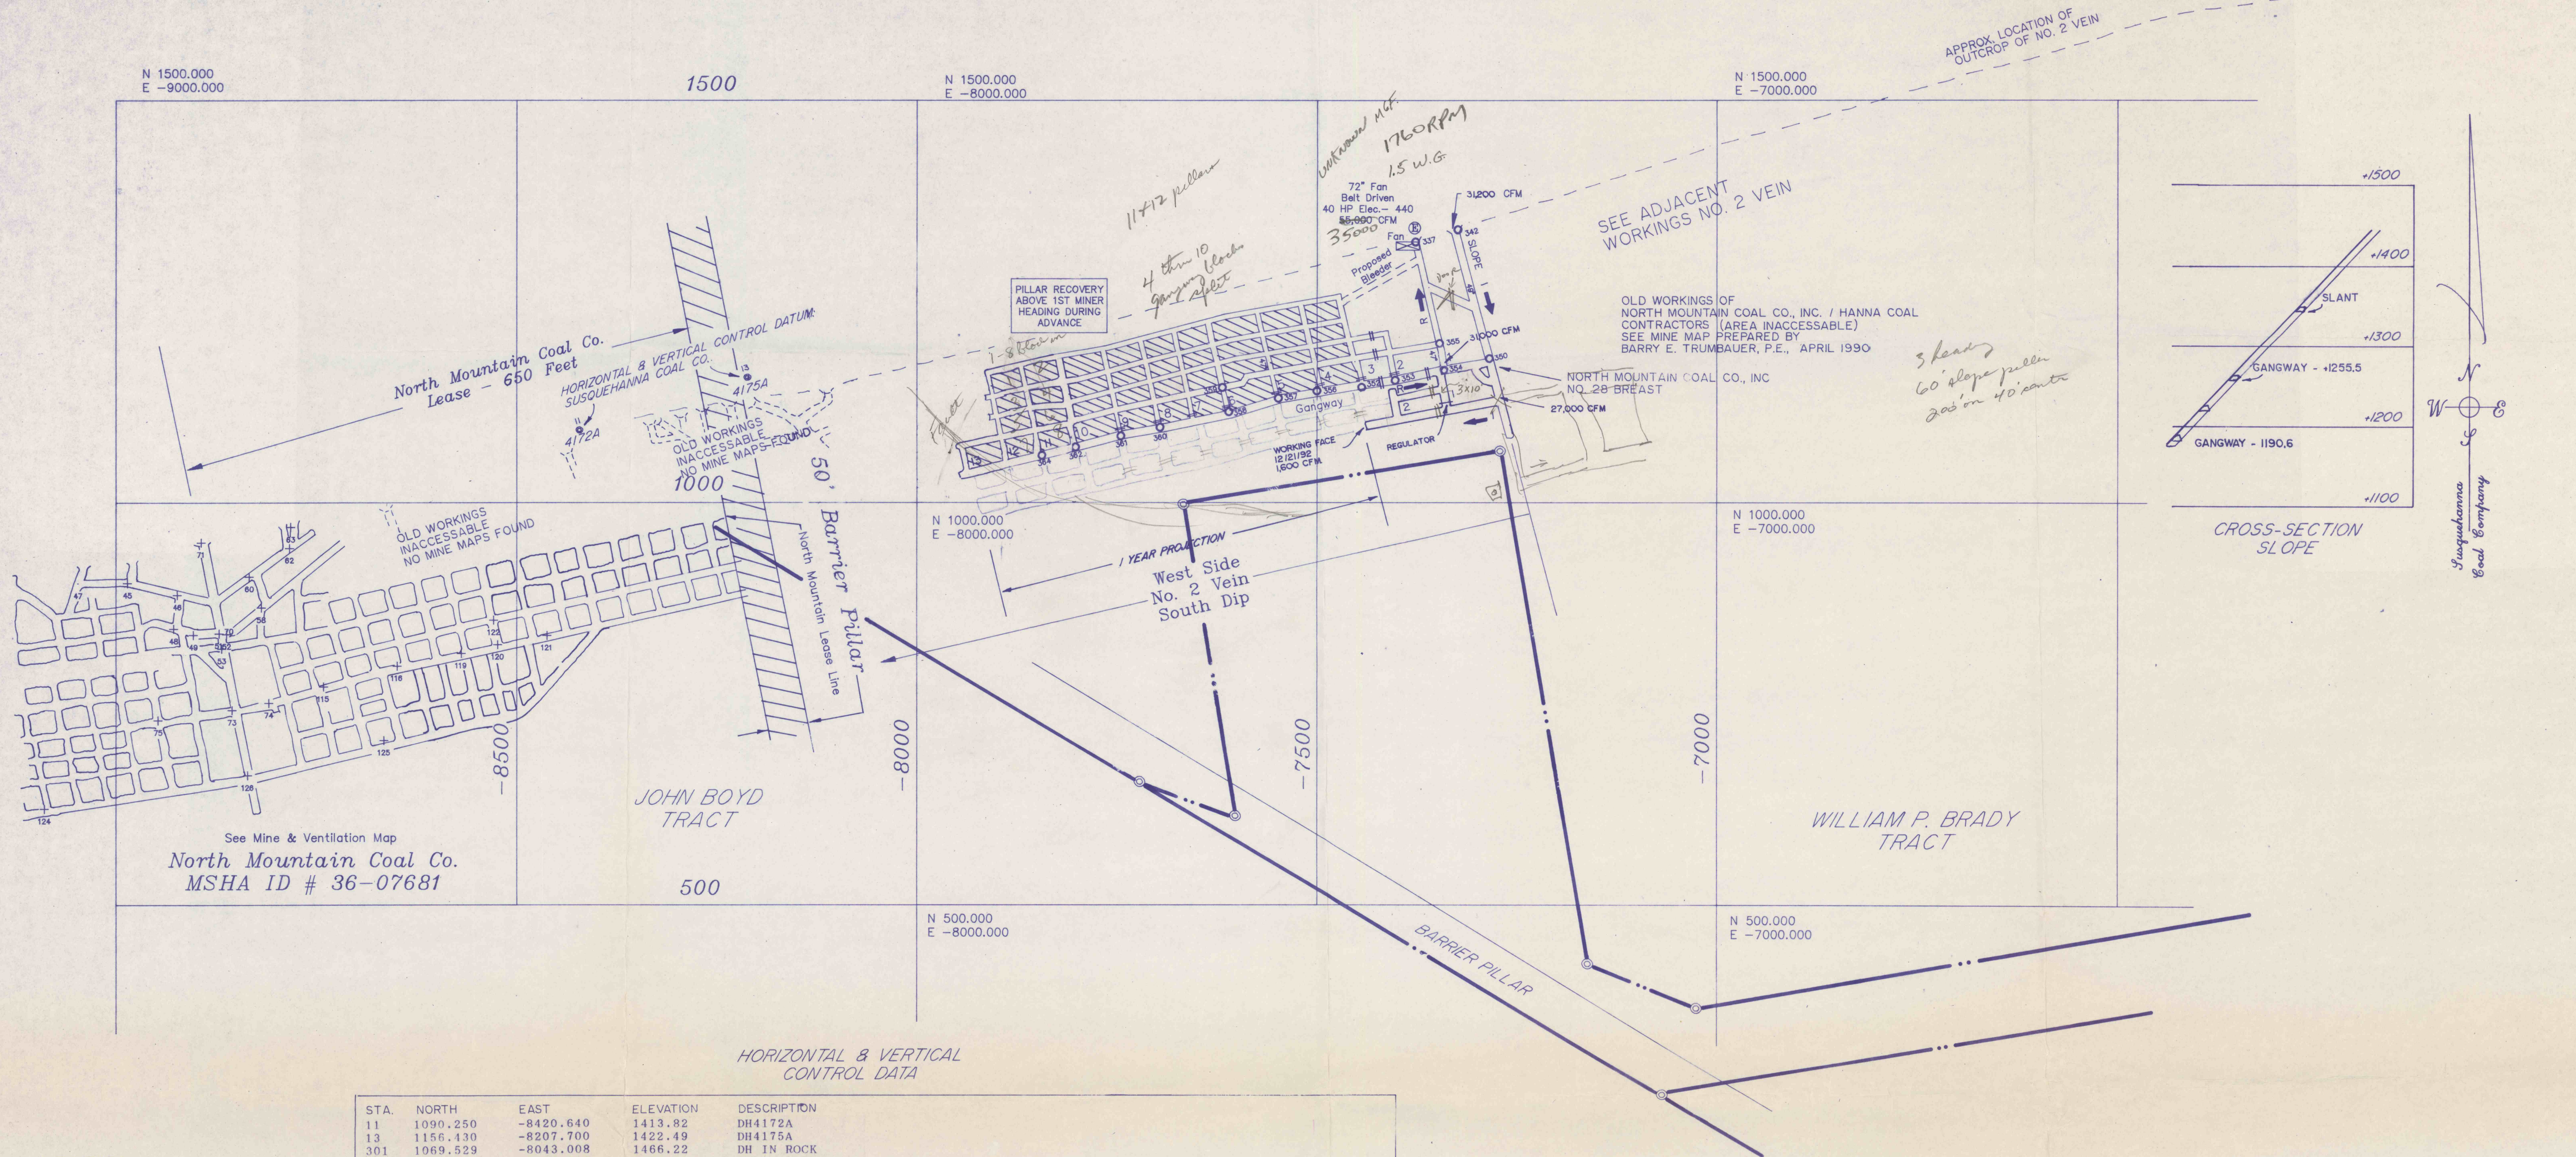

HORIZONTAL & VERTICAL CONTROL DATA

STA.	NORTH	EAST	ELEVATION	DESCRIPTION
11	1090.250	-8420.640	1413.82	DH4172A
13	1156.130	-8207.700	1422.49	DH4175A
301	1069.529	-8043.008	1466.22	DH IN ROCK
303	1061.805	-7873.207	1473.06	DH IN ROCK
306	1144.736	-7478.844	1494.23	*5R/B(SET)
313	1091.080	-7567.471	1486.13	SPK
337	1325.287	-7376.716	1445.38	*5R/B(SET)
342	1340.450	-7323.496	1444.37	*5R/B(SET)
350	1179.233	-7283.924	1261.98	SPAD
354	1164.755	-7340.841	1255.68	SPK IN FLOOR
355	1198.818	-7346.440	1294.19	MONKEY
353	1151.876	-7401.822	1256.27	CHUTE #2
352	1143.165	-7443.575	1256.47	SPK IN FLOOR
356	1138.754	-7500.144	1256.94	SPK IN FLOOR
357	1129.655	-7548.190	1257.44	CHUTE #5
358	1112.609	-7610.612	1257.60	SPK IN FLOOR
359	1143.420	-7618.065	1294.15	MONKEY
360	1092.912	-7695.918	1259.08	CL TRACK
361	1082.586	-7744.333	1259.53	S RAIL CHUTE #9
362	1068.660	-7801.220	1259.91	CL TRK CHUTE #10
363	1057.506	-7848.627	1260.26	CHUTE #11
364	1058.862	-7843.490	1260.18	PK CL TRACK

LEGEND:

- ⊙ ESCAPWAY
- ➔ RETURN AIR
- ➔ INTAKE AIR
- PERMANENT STOPPING
- TEMPORARY STOPPING
- ⊙ BEP BLEEDER EVALUATION POINT
- ▨ ROBBED

NOTES:

1. VENTILATION INFORMATION PROVIDED BY MINE OPERATOR
2. HORIZONTAL & VERTICAL CONTROL DATUM: SUSQUEHANNA COAL CO.

MINE AND VENTILATION MAP FOR
C & B MINING COMPANY
 NO. 2 VEIN - SOUTH DIP - WEST SIDE
 MSHA ID #36-07813

LOCATED IN
 COAL TOWNSHIP
 NORTHUMBERLAND COUNTY
 PENNSYLVANIA

SCALE: 1 INCH = 100 FEET, OCTOBER 10, 1991
 DECEMBER 31, 1992



TAYLOR-DOBECK ASSOCIATES
 PROFESSIONAL LAND SURVEYORS
 RD #1, BOX 659
 SHAMOKIN, PA. 17872