


NOTES:

- HORIZONTAL AND VERTICAL DATUM - SUSQUEHANNA COAL CO.
- VENTILATION INFORMATION PROVIDED BY MINE OPERATOR
- COAL VEIN INFORMATION PROVIDED BY MINE OPERATOR
- ONE YEAR PROJECTION ESTIMATED BY MINE OPERATOR AND SUBJECT TO CHANGE AS CONDITIONS CHANGE.

THERE MAY BE OLD MINE WORKINGS IN THIS AREA!

- OLD MINE WORKINGS SHOWN ARE TAKEN FROM OLD AVAILABLE MINE MAPS.
- AS ADDITIONAL INFORMATION AND/OR MINE MAPS BECOME AVAILABLE MAPPING SHALL BE UPDATED.
- NO CERTIFICATION IS EXPRESSED OR IMPLIED AS TO EXISTENCE, NON-EXISTENCE, ACCURACY OR LOCATIONS OF OLD MINE WORKINGS.
- THE MINE OPERATOR SHALL BE RESPONSIBLE FOR THE VERIFICATION OF THE LOCATIONS OF ALL OLD MINE WORKINGS.

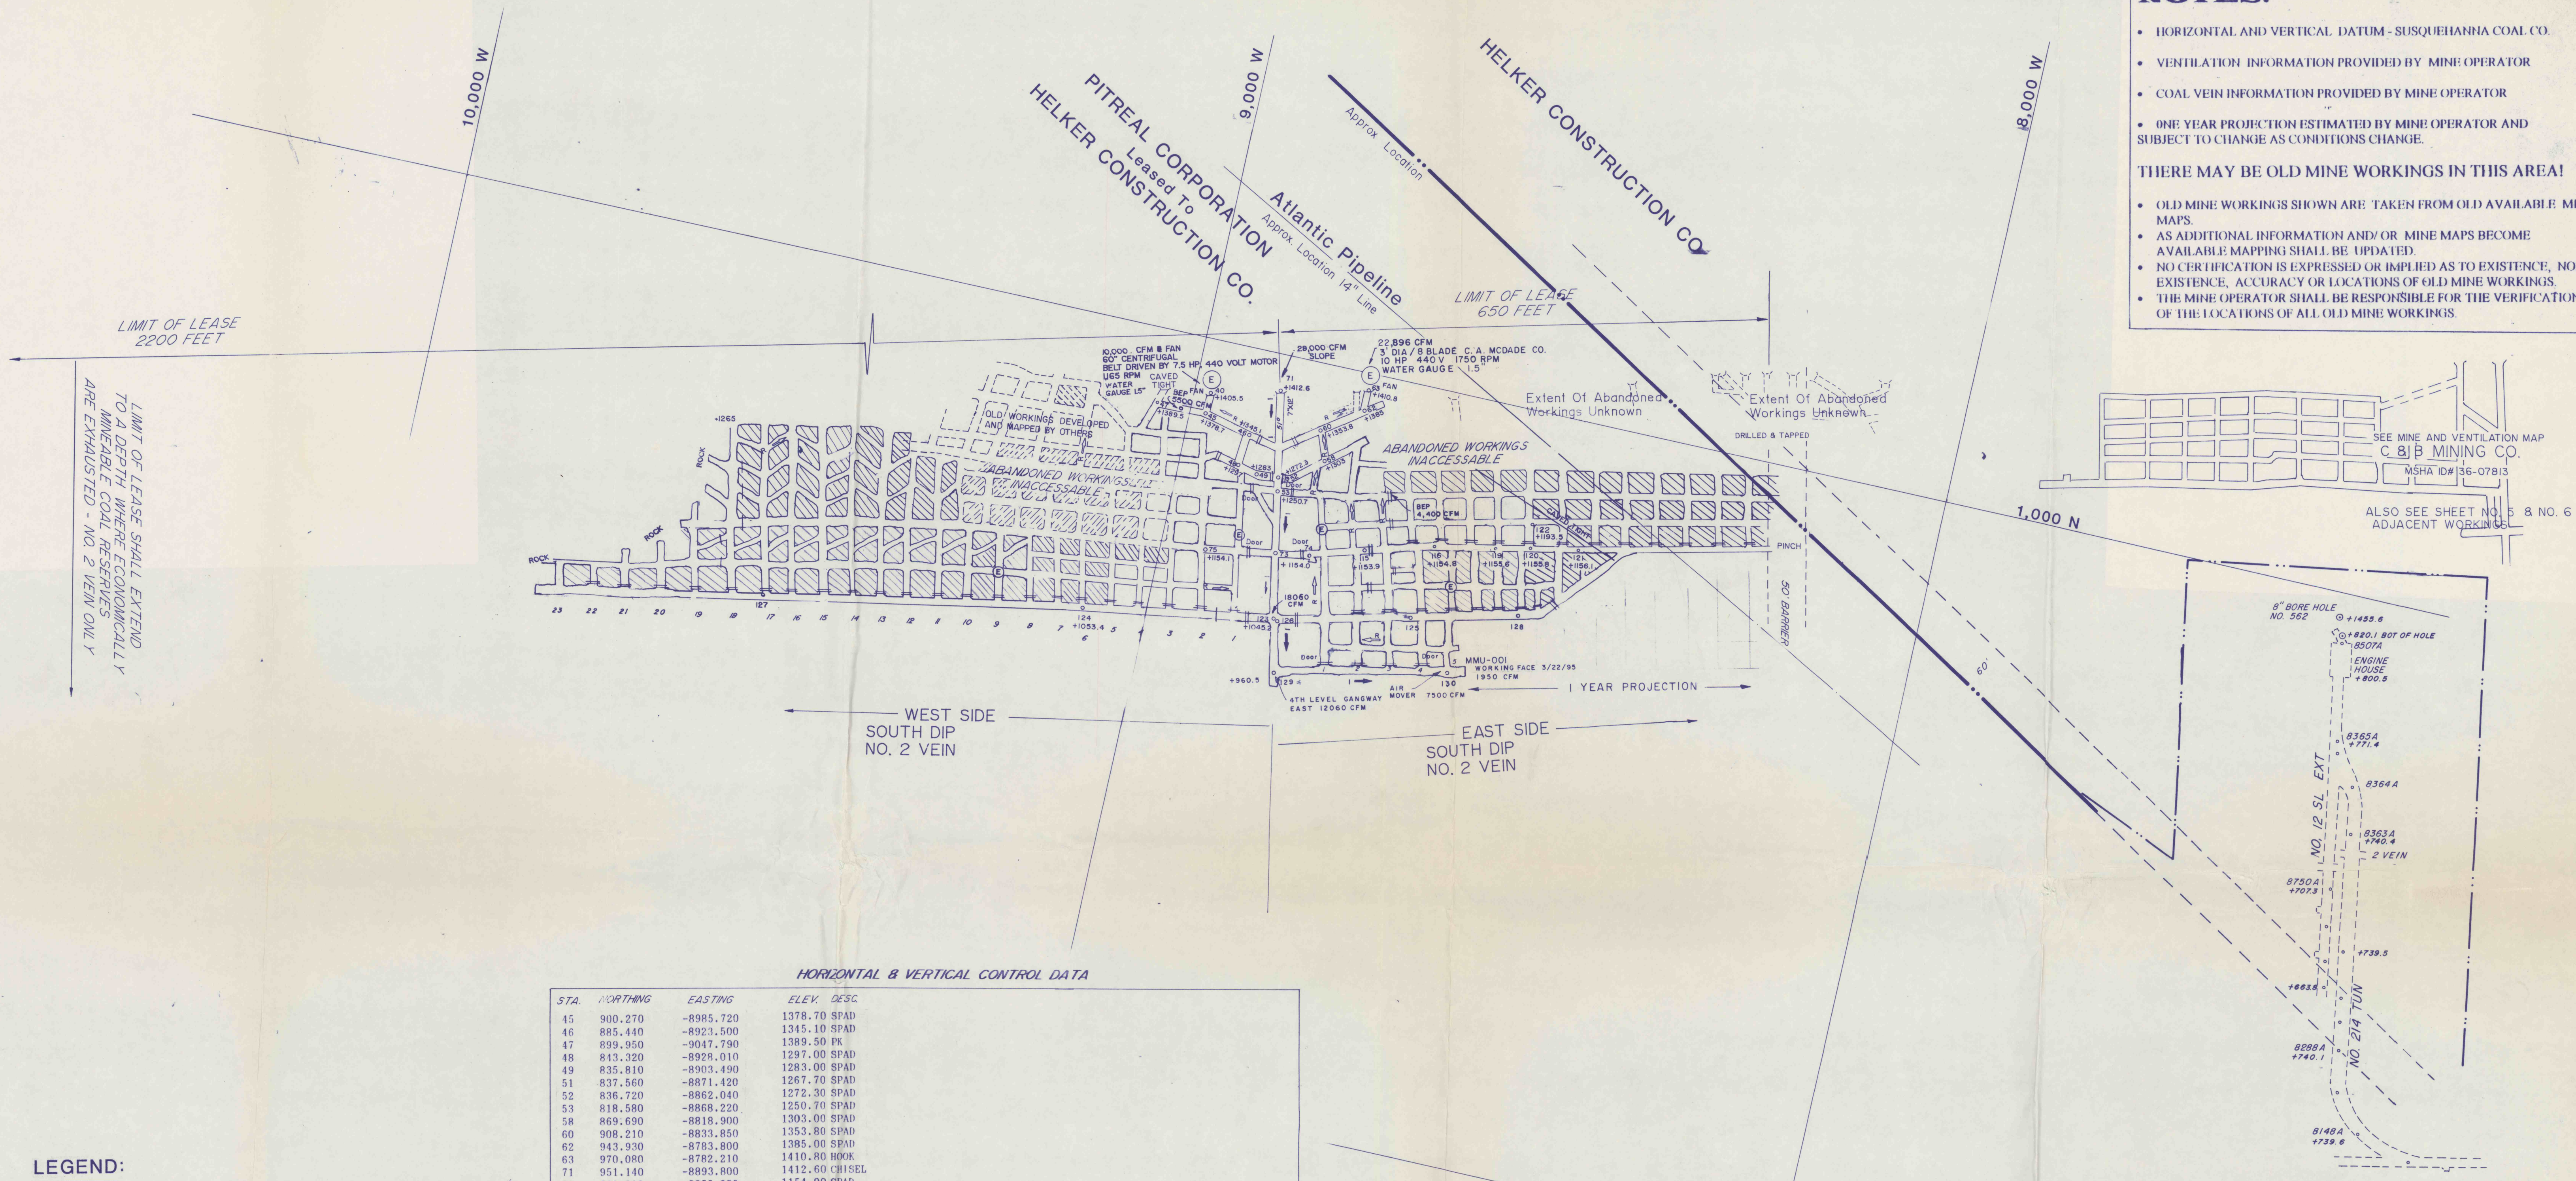

HORIZONTAL & VERTICAL CONTROL DATA

STA.	NORTHING	EASTING	ELEV. DESC.
15	900.270	-8985.720	1378.70 SPAD
16	885.440	-8923.500	1345.10 SPAD
17	899.950	-9047.790	1389.50 PK
18	843.320	-8928.010	1297.00 SPAD
19	835.810	-8903.490	1283.00 SPAD
20	837.560	-8871.420	1267.70 SPAD
21	836.720	-8862.040	1272.30 SPAD
22	818.580	-8868.220	1250.70 SPAD
23	869.690	-8818.900	1303.00 SPAD
24	908.210	-8833.850	1353.80 SPAD
25	943.930	-8783.800	1385.00 SPAD
26	970.080	-8782.210	1410.80 HOOK
27	951.140	-8893.800	1412.60 CHISEL
28	742.200	-8855.280	1154.00 SPAD
29	751.140	-8809.640	1155.36 SPAD
30	729.380	-8947.620	1154.10 SPAD
31	771.290	-8741.230	1154.80 SPAD
32	797.150	-8649.300	1154.84 SPAD
33	812.760	-8569.110	1155.55 SPAD
34	823.680	-8523.600	1155.80 SPAD
35	834.990	-8461.730	1156.07 SPAD
36	854.200	-8528.630	1193.45 SPAD
37	662.720	-8839.100	1045.20 BK
38	619.620	-9089.780	1053.42 SPAD
39	704.430	-8665.930	SPAD
40	661.010	-8835.900	1051.09 SPAD
41	537.731	-9505.688	1054.16 SPAD
42	595.005	-8821.119	965.300 SPAD
43	644.963	-8596.805	972.380 SPAD

LEGEND:

- ESCAPEWAY (E)
- ROBBED (hatched box)
- SURVEY STATION (o) (TAYLOR-DOBERK ASSOC.) (41674) (SUSQUEHANNA COAL CO.)
- ELEVATION (+1382) (SUSQUEHANNA COAL CO. DATUM)
- STOPPING (PERMANENT and TEMPORARY symbols)
- INTAKE AIR (I)
- RETURN AIR (R)
- OLD ABANDONED WORKINGS (dashed line)
- NEW WORKINGS OF NORTH MOUNTAIN COAL CO. (solid line)
- PROPERTY LINE (dotted line)
- OUTCROP LINE (dashed line)
- PITCH OF VEIN (DEGREES) (50°)
- BLEEDER EVALUATION POINT (BEP)

MINE AND VENTILATION MAP

No. 2 Vein - South Dip

JORDAN COAL CO.

COAL TOWNSHIP, NORTHUMBERLAND COUNTY
PENNSYLVANIA

SCALE: 1 INCH = 100 FEET, MAY 15, 1995

M.S.H.A. I.D.# 36-07681



Taylor-Doberk Associates
PROFESSIONAL LAND SURVEYORS
RD#1 BOX 659
SHAMOKIN, PA. 17872

Howard D. Taylor

Sub-Surface
SHEET NO. 2