





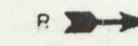
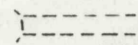
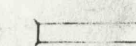
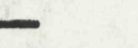
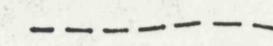
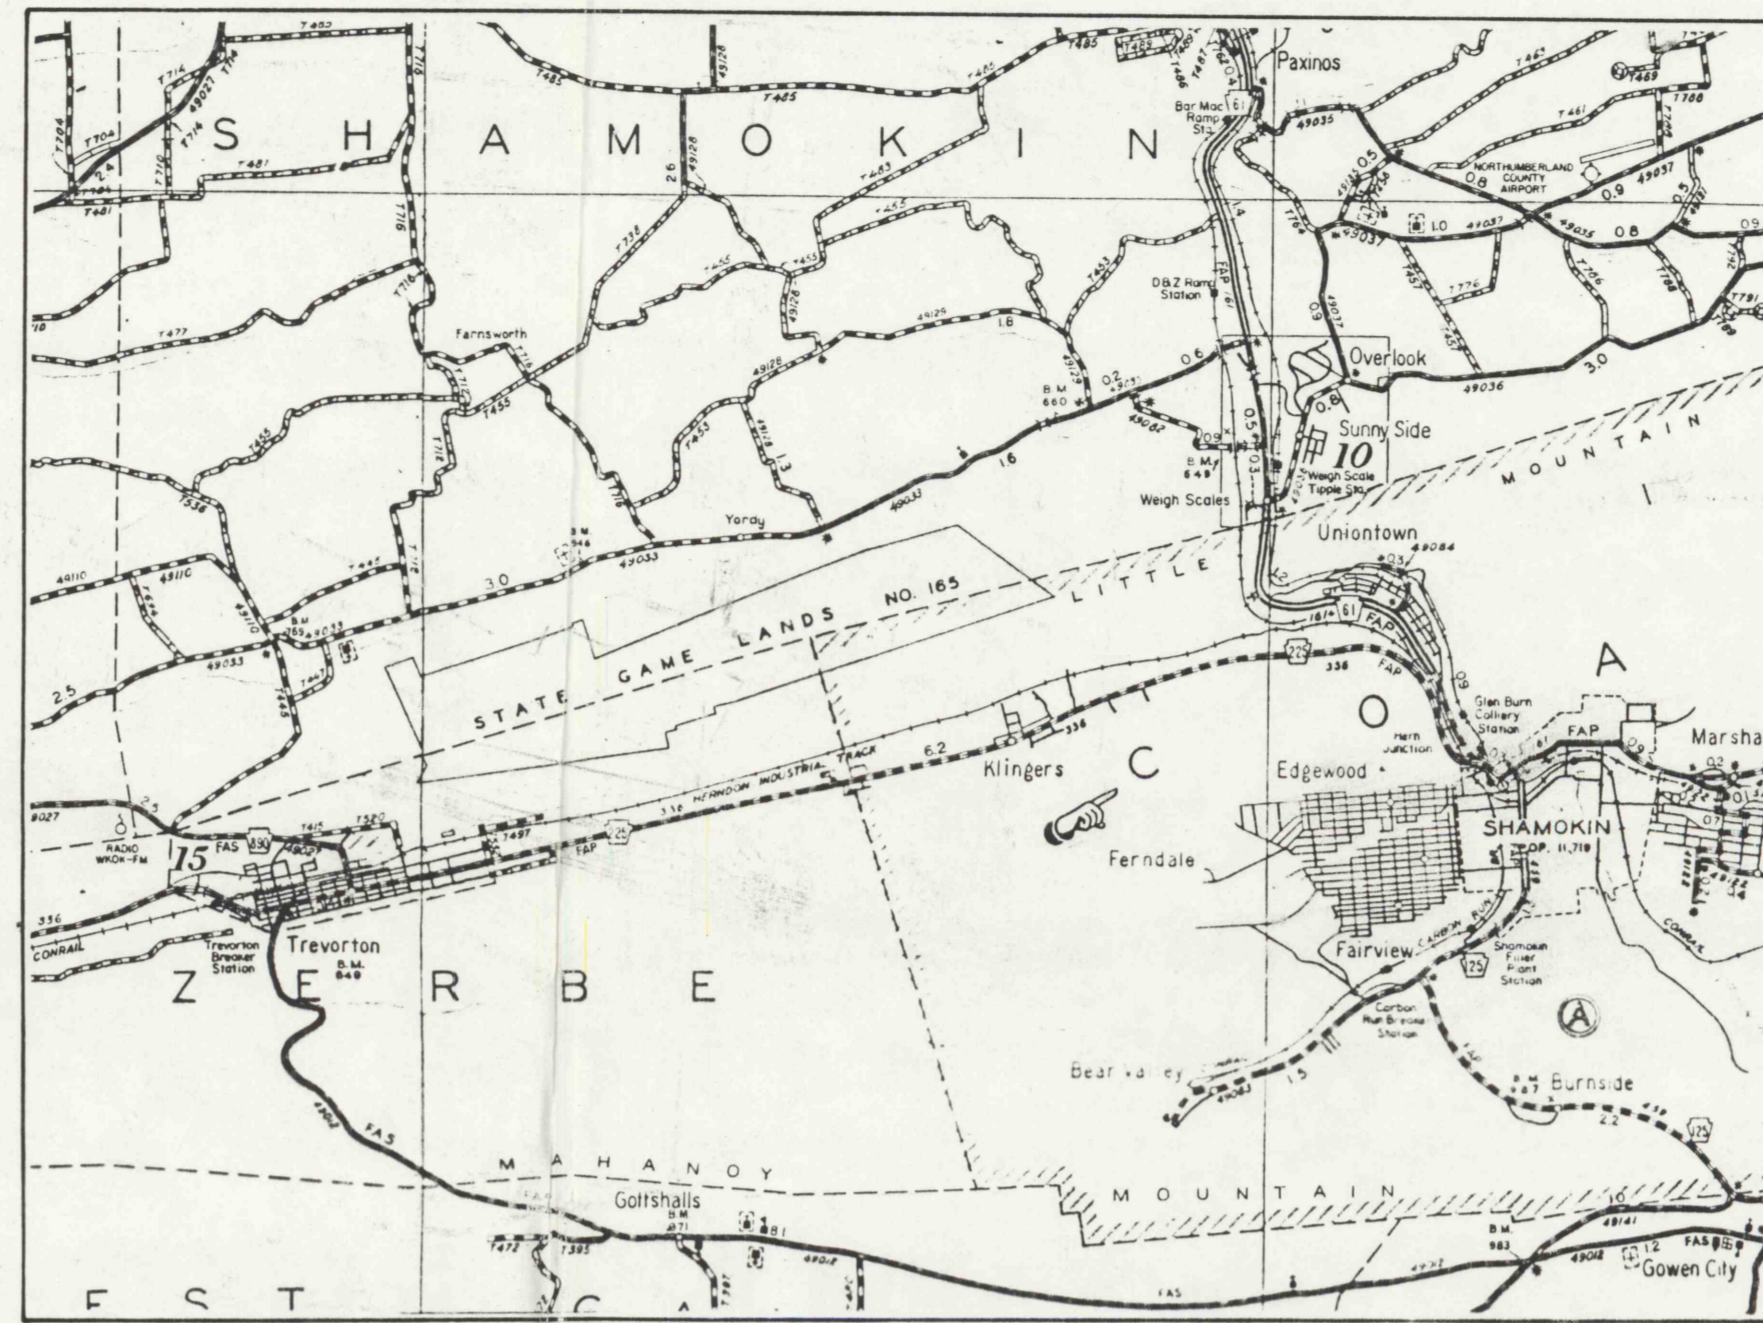
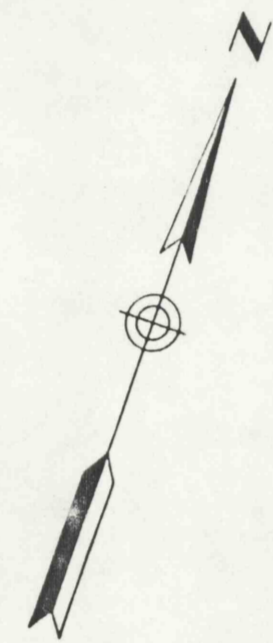


**LEGEND**

- ESCAPEWAY 
- ROBBED 
- SURVEY STATION  (TAYLOR-DOBECK ASSOC.)  4167A (SUSQUEHANNA COAL CO.)
- ELEVATION +1382 (SUSQUEHANNA COAL CO. DATUM)
- STOPPING 
- INTAKE AIR 
- RETURN AIR 
- OLD ABANDONED WORKINGS 
- NEW WORKINGS OF NORTH MOUNTAIN COAL CO. 
- PROPERTY LINE 
- OUTCROP LINE 

**Horizontal Control Data Surface**


- Station No. 11 Drill Hole In Rock  
N = 1,090.25 (N)  
E = -8,420.64 (W)
- Station No. 13 Drill Hole In Rock  
N = 1,156.43 (N)  
E = -8,207.70 (W)
- Station No. 71 Chisel Mark On Angle Iron On Tipple  
N = 951.14 (N)  
E = -8,893.80 (W)
- Station No. 76 Drill Hole In Rock  
N = 1,063.27 (N)  
E = -8,642.35 (W)
- Station No. 77 Spike In Road  
N = 873.53 (N)  
E = -8,772.80 (W)
- Station No. 78 Spike On Southerly Side Of Road  
N = 801.89 (N)  
E = -8,668.98 (W)
- Station No. 79 Spike On Northerly Side Of Road  
N = 810.58 (N)  
E = -8,417.18 (W)

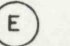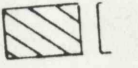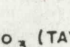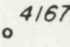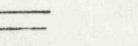

**Location Map**  
1 Inch = 1 Mile

Pennsylvania State Highway Traffic Route No. 225  
To Trevorton To Shamokin

Pennsylvania Power & Light Co. Right-Of-Way

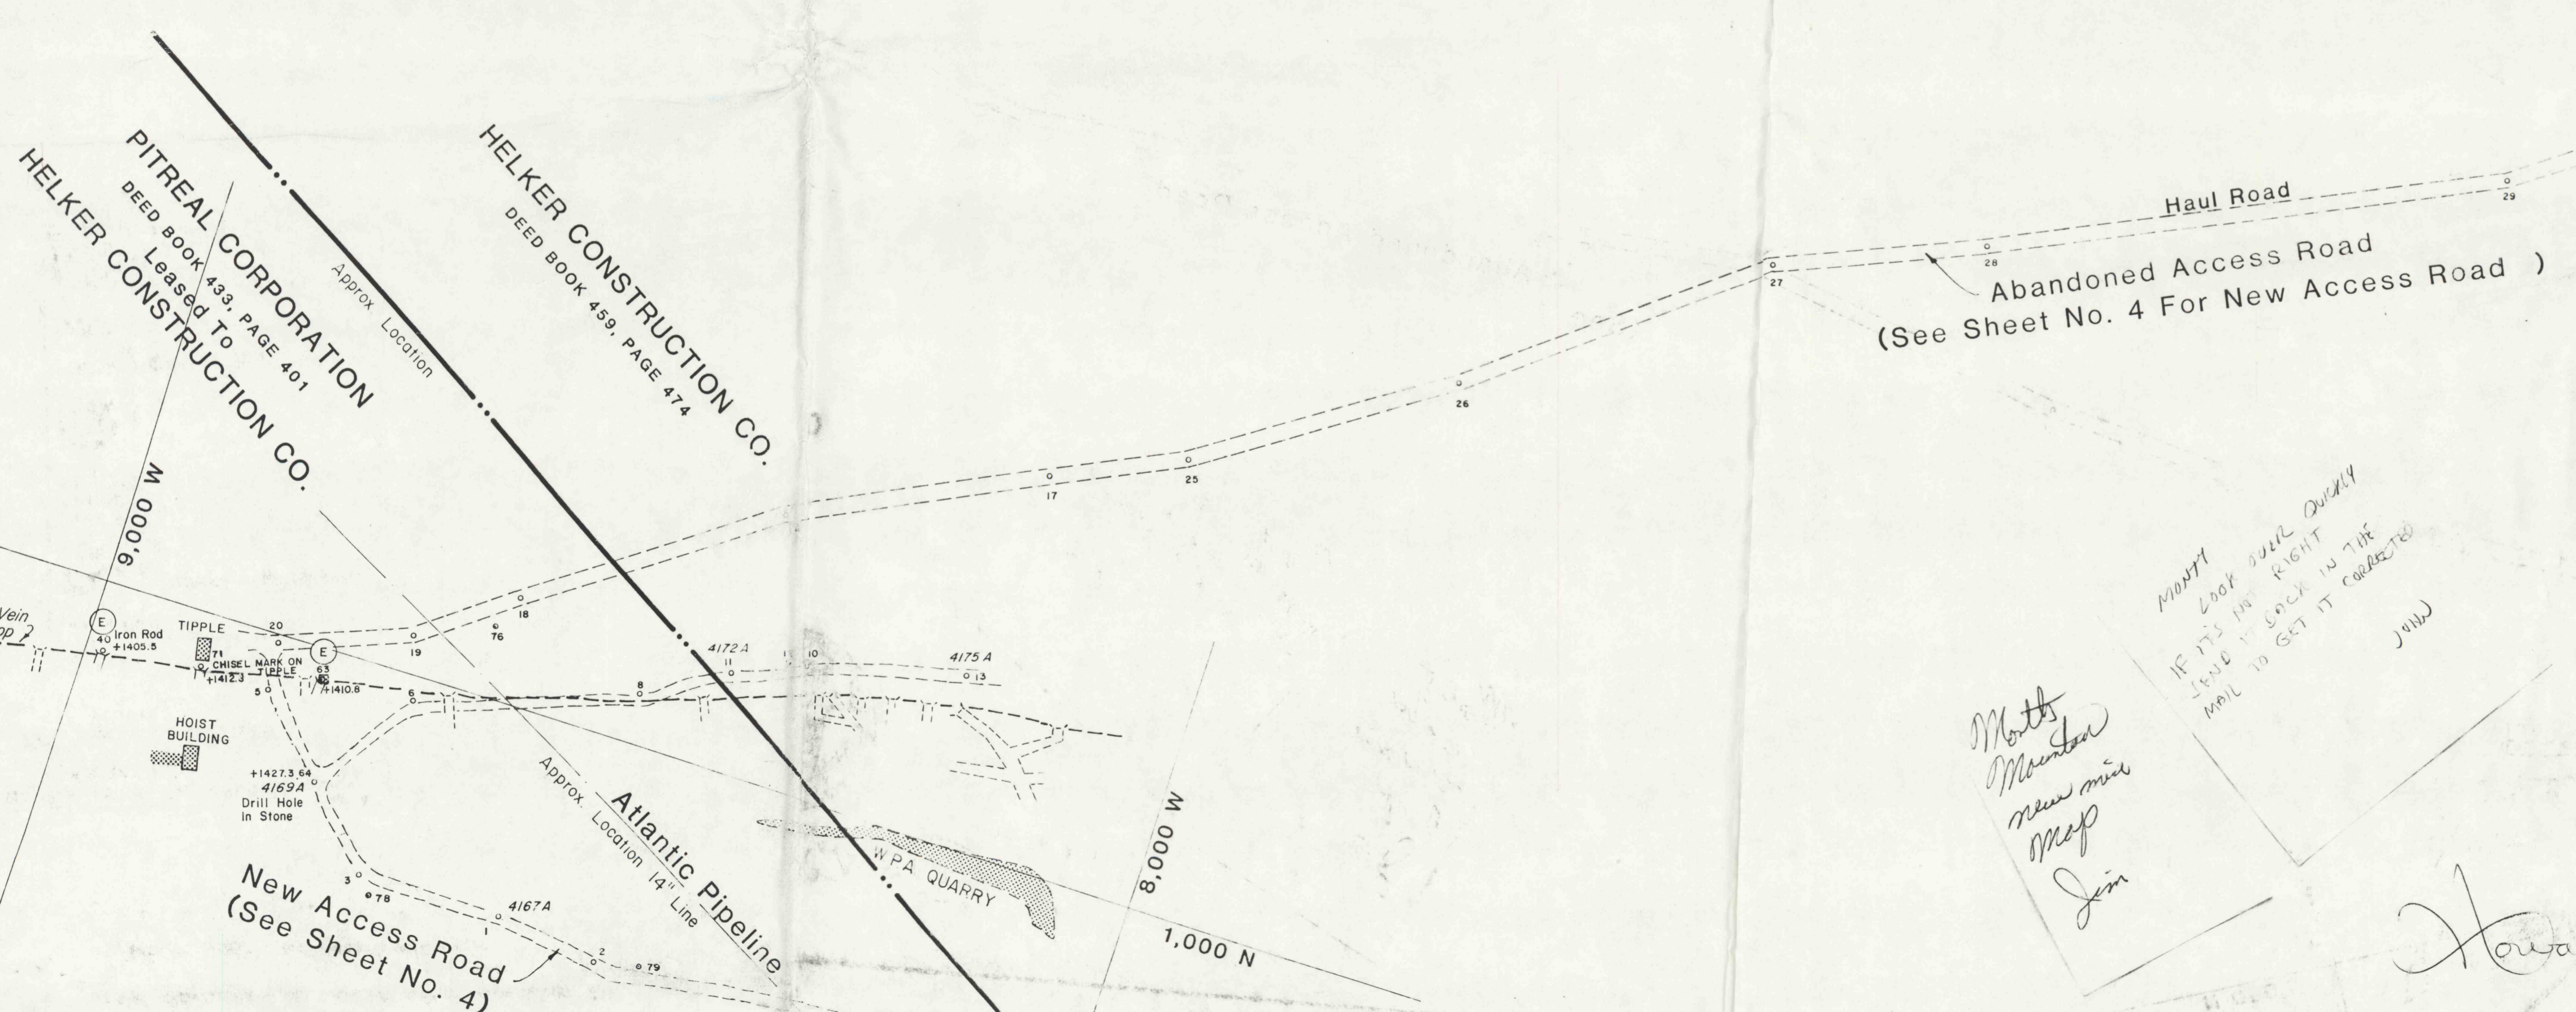


No. 2 Vein - South Dip

MINE SURVEY FOR  
**NORTH MOUNTAIN COAL CO.**  
COAL TOWNSHIP, NORTHUMBERLAND COUNTY  
PENNSYLVANIA

SCALE: 1 INCH = 100 FEET, OCTOBER 16, 1985  
REVISED: NOV. 6, 1987 MAY 2, 1988  
M.S.H.A. I.D.# 36-C7681 JAN. 20, 1989

*North Mountain new mine map Jim*  
*MONTH LOOK OVER QUICKLY IF ITS IN RIGHT PLACE TO GET IT CORRECTED JHW*

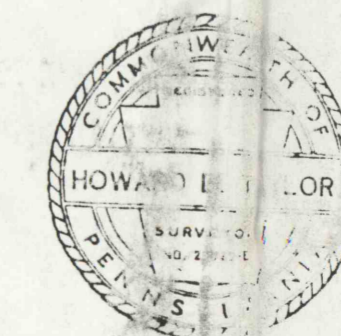

**Taylor-Dobek Associates**  
PROFESSIONAL LAND SURVEYORS  
RD#1 BOX 659  
SHAMOKIN, PA. 17872

*Howard D. Taylor*