


5961

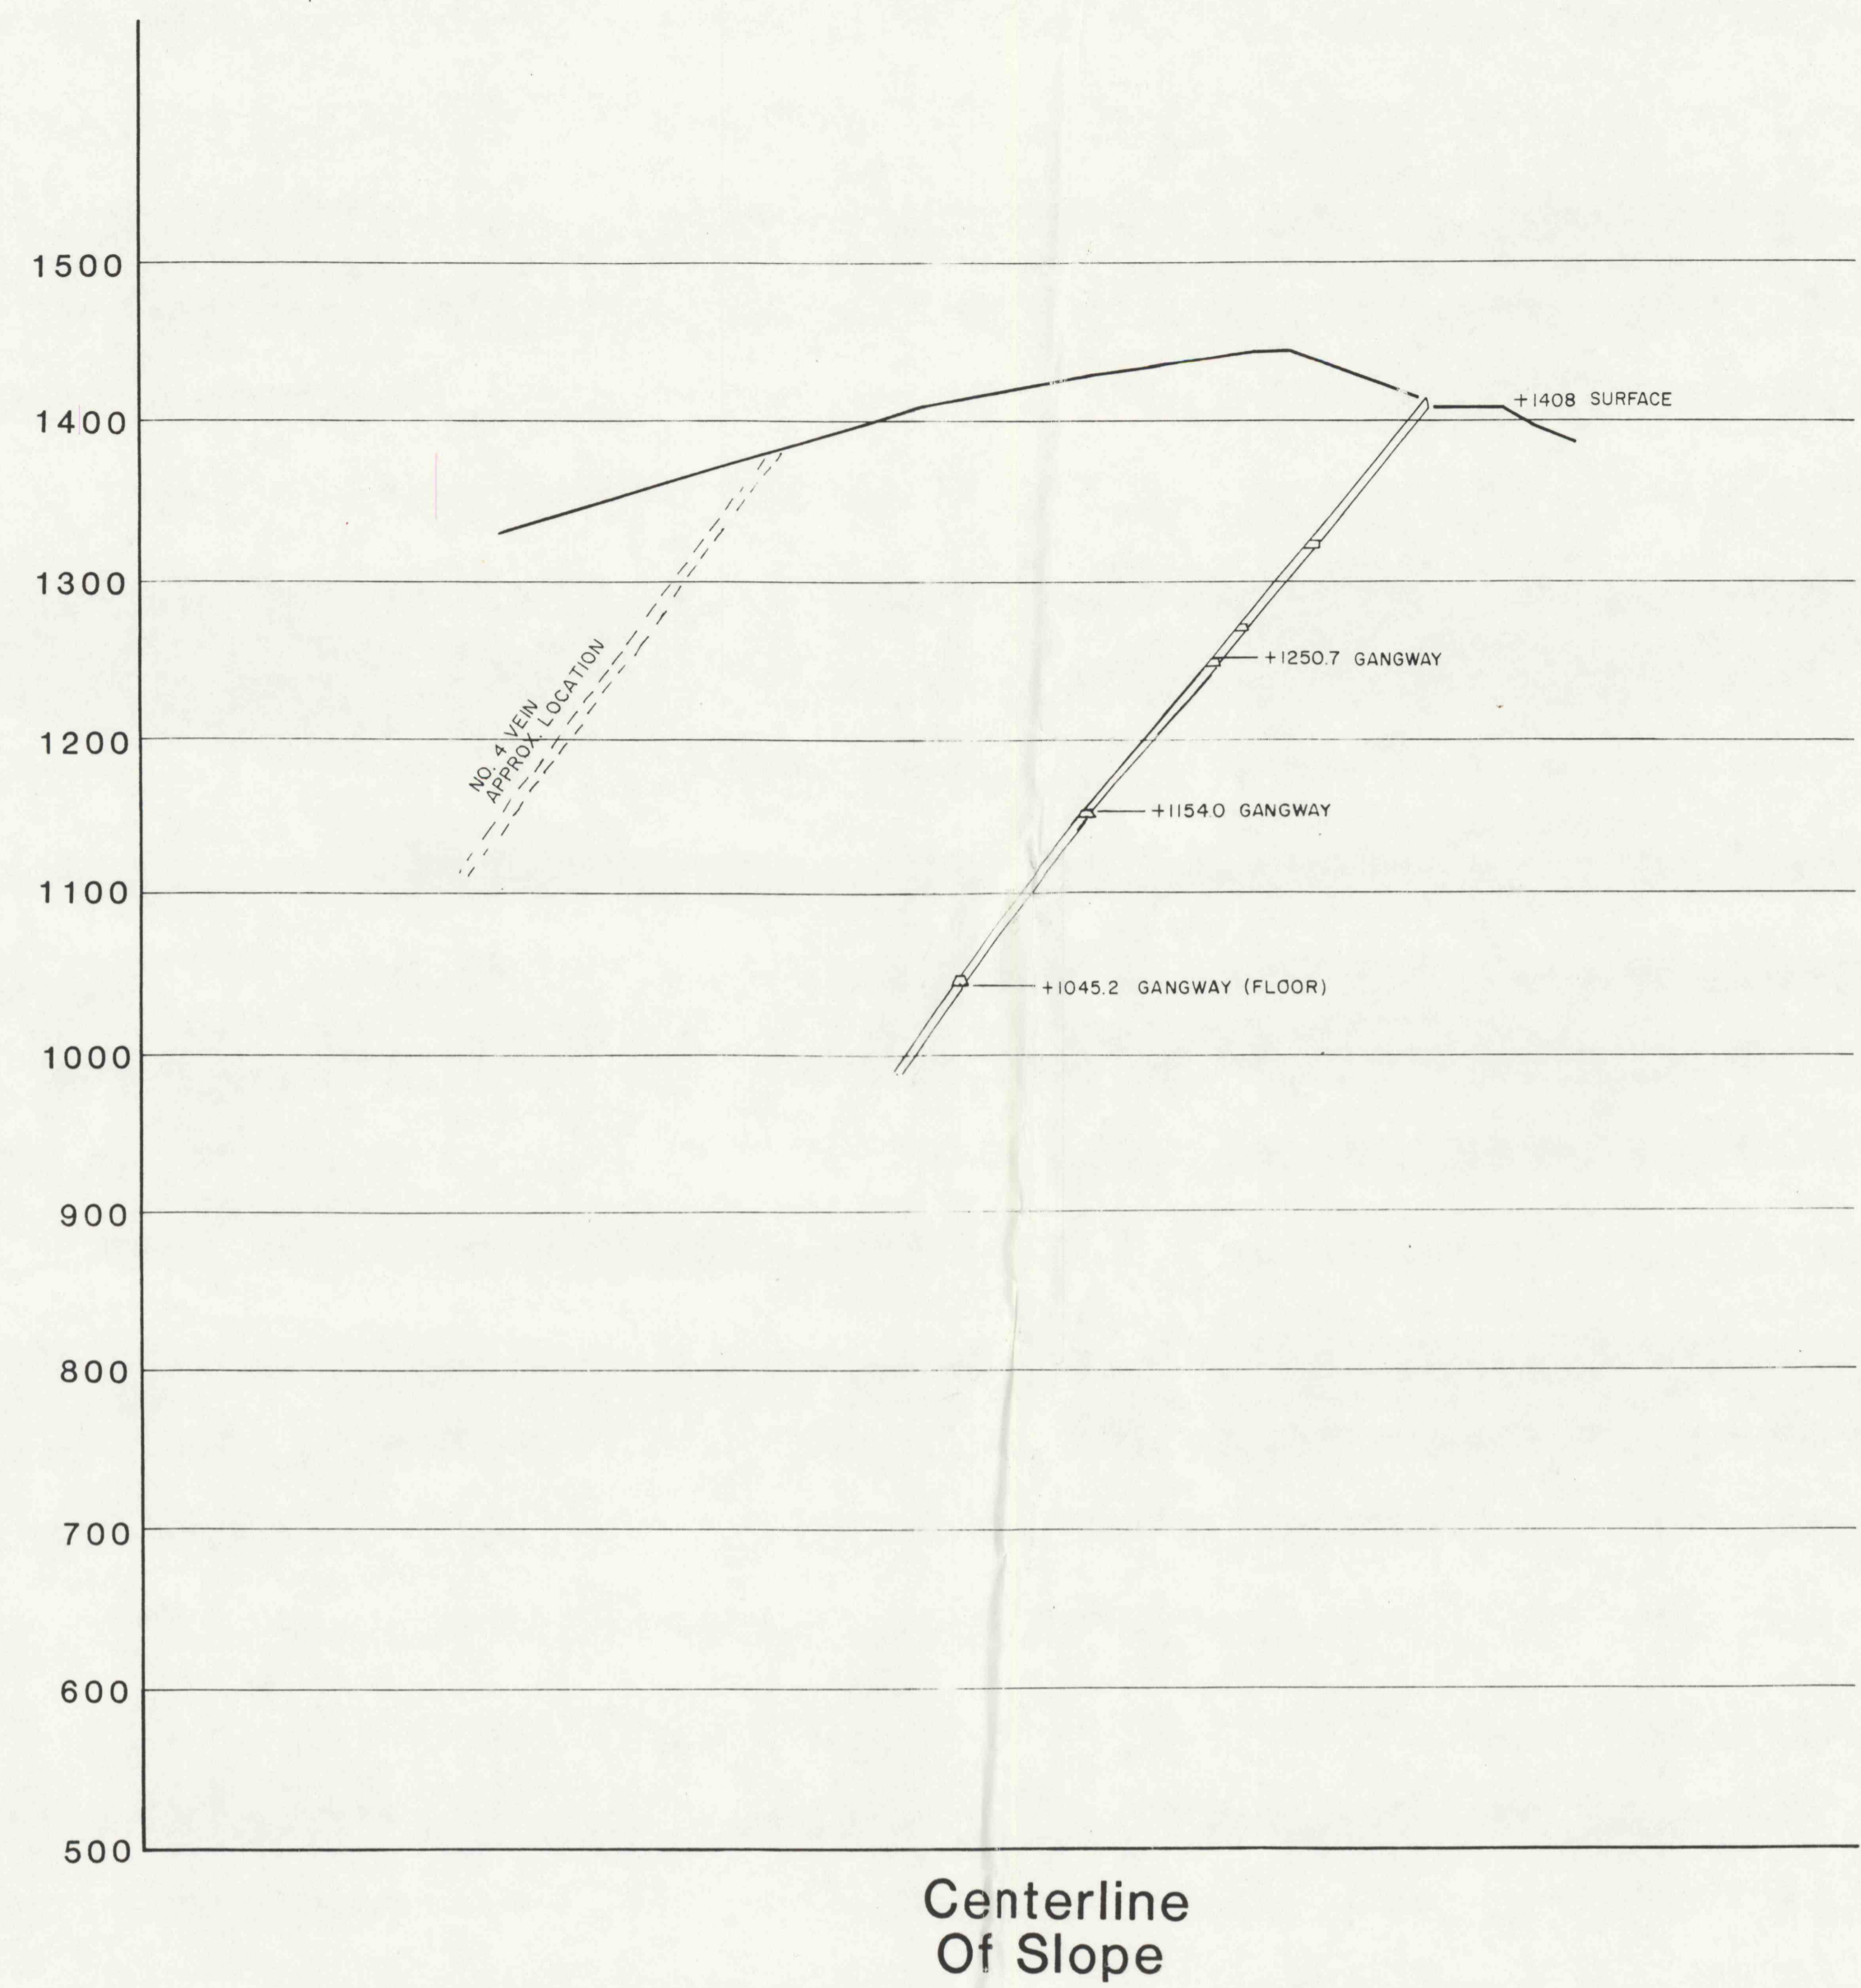


No. 2 Vein - South Dip

MINE SURVEY FOR
NORTH MOUNTAIN COAL CO.
COAL TOWNSHIP, NORTHUMBERLAND COUNTY
PENNSYLVANIA

SCALE: VERTICAL - 1 INCH = 100 FEET
HORIZONTAL - 1 INCH = 100 FEET

M.S.H.A. I.D. #36- 07681

OCTOBER 16, 1985
REVISED: NOV. 6, 1987
MAY 15, 1990
MAY 22, 1991

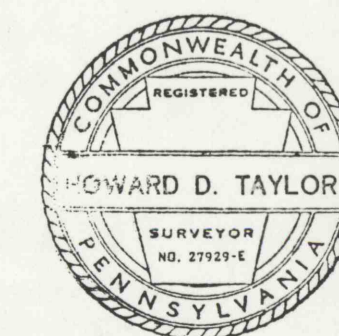

Taylor-Dobeck Associates
PROFESSIONAL LAND SURVEYORS
RD # 1 BOX 659
SHAMOKIN, PA. 17872

Howard D. Taylor