

99L1




No. 2 Vein - South Dip
NORTH MOUNTAIN COAL CO.
COAL TOWNSHIP, NORTHUMBERLAND COUNTY
PENNSYLVANIA
M.S.H.A. I.D.# 36-07681
Taylor-Doberk Associates
PROFESSIONAL LAND SURVEYORS
RD#1 BOX 659
SHAMOKIN, PA. 17872

TRACED FROM
CAMERON COLLERY

No. 4 Vein

1 Inch = 100 Feet

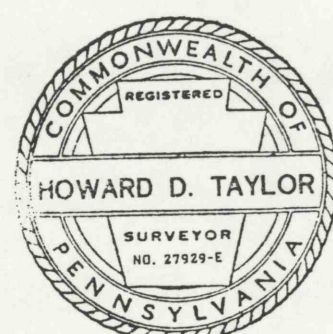

Howard D. Taylor

Adjacent Workings
CAMERON COLLERY
NO. 4 VEIN

SHEET NO. 6