

ESCAPEWAY (E)

ROBBED

SURVEY STATION $\odot_3$ (TAYLOR-DORBECK ASSOC.) $\odot$ 3167A (SUSQUEHANNA COAL CO.)

ELEVATION +1382 (SUSQUEHANNA COAL CO. DATUM)

STOPPING

INTAKE AIR I

RETURN AIR R

OLD ABANDONED WORKINGS

NEW WORKINGS OF NORTH MOUNTAIN COAL CO.

PROPERTY LINE

OUTCROP LINE

Station No. 11 Drill Hole In Rock
N = 1,090.25 (N)
E = -8,420.64 (W)

Station No. 13 Drill Hole In Rock
N = 1,156.43 (N)
E = -8,207.70 (W)


Station No. 71 Chisel Mark On Angle Iron On Tipple
N = 951.14 (N)
E = -8,893.80 (W)

Station No. 76 Drill Hole In Rock
N = 1,063.27 (N)
E = -8,642.35 (W)


Station No. 77 Spike In Road
N = 873.53 (N)
E = -8,772.80 (W)

Station No. 78 Spike On Southerly Side Of Road
N = 801.89 (N)
E = -8,668.98 (W)

Station No. 79 Spike On Northerly Side Of Road
N = 810.58 (N)
E = -8,417.18 (W)

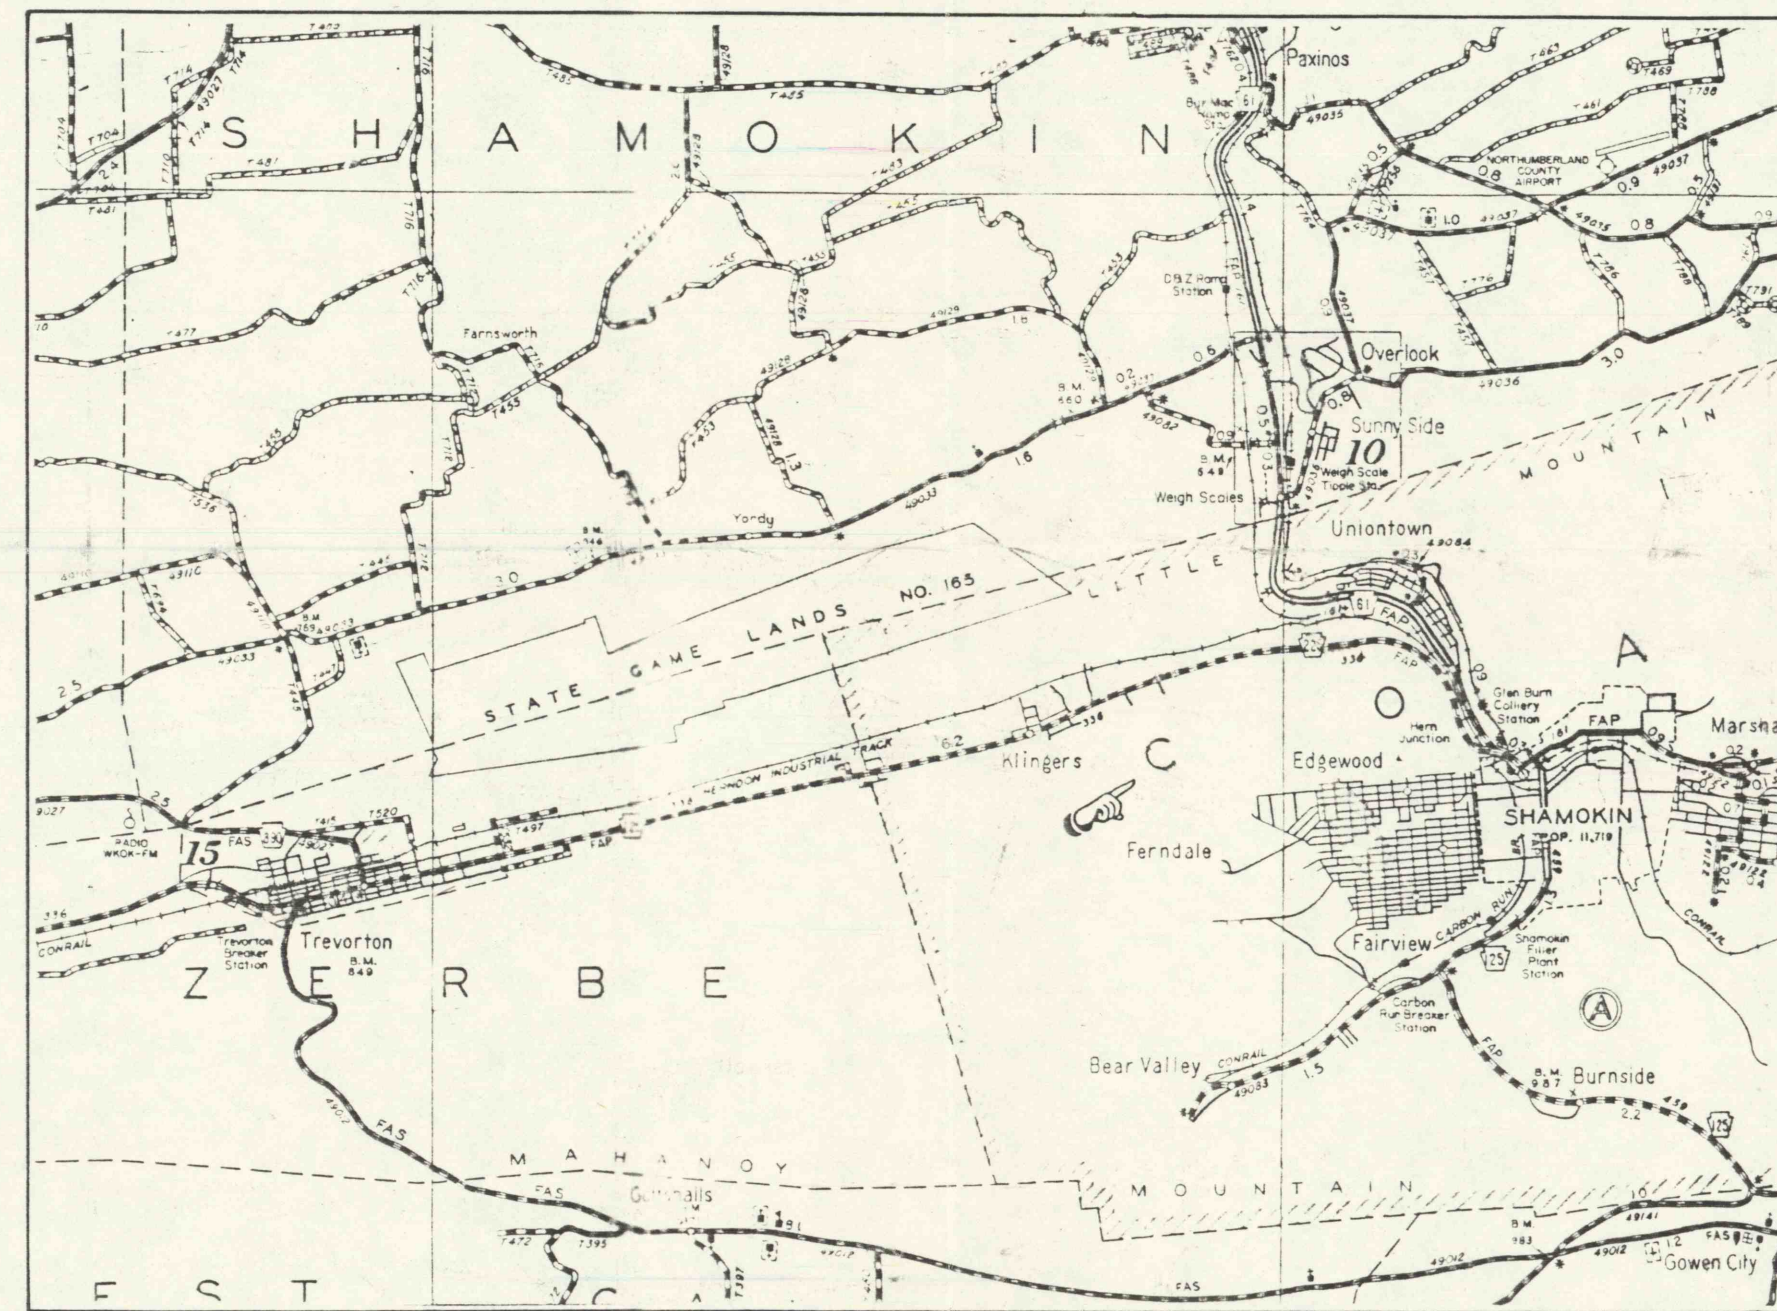

Location Map
1 Inch = 1 Mile

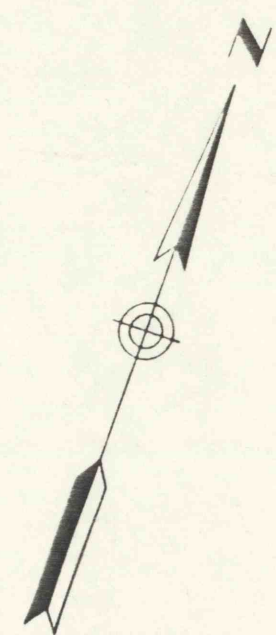

HELKER CONSTRUCTION CO.
DEED BOOK 459, PAGE 474

Approx. Location

PITREAL CORPORATION
Leased To
DEED BOOK 433, PAGE 401

HELKER CONSTRUCTION CO.

Haul Road

Abandoned Access Road


(See Sheet No. 4 For New Access Road)

No. 2 Vein - South Dip

MINE SURVEY FOR
NORTH MOUNTAIN COAL CO.
COAL TOWNSHIP, NORTHUMBERLAND COUNTY
PENNSYLVANIA

SCALE: 1 INCH = 100 FEET, OCTOBER 16, 1985
REVISED: NOV. 6, 1987 MAY 2, 1988
M.S.H.A. I.D.# 36- 07681 JAN. 20, 1989

Taylor-Doberck Associates
PROFESSIONAL LAND SURVEYORS
RD #1 BOX 659
SHAMOKIN, PA. 17872

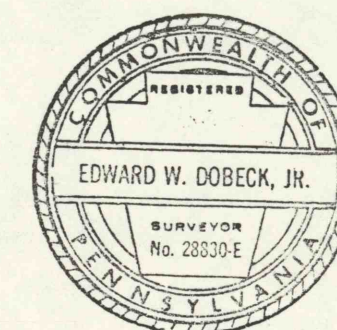

Surface
SHEET NO. 1 OF 4

1727