



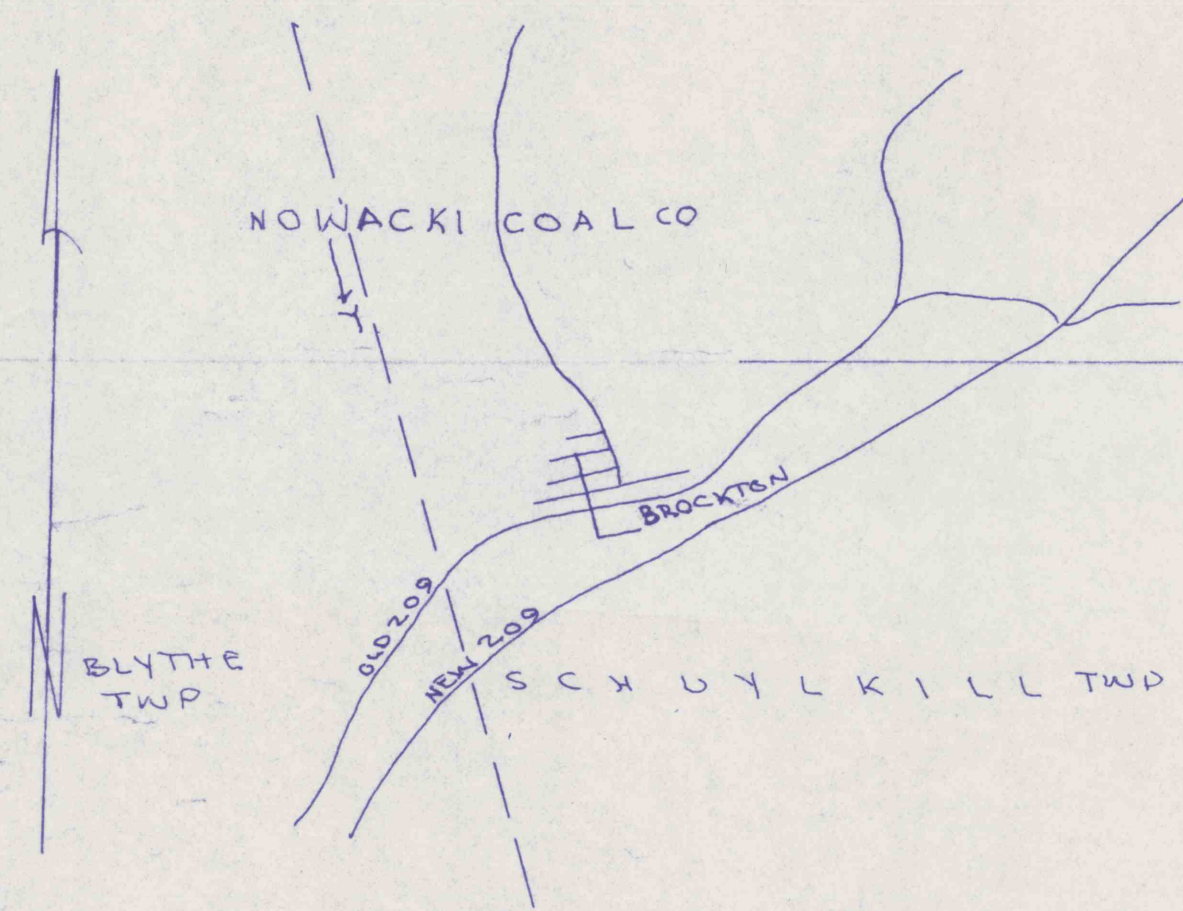

LOCATION MAP
SCALE 1" = 2000'

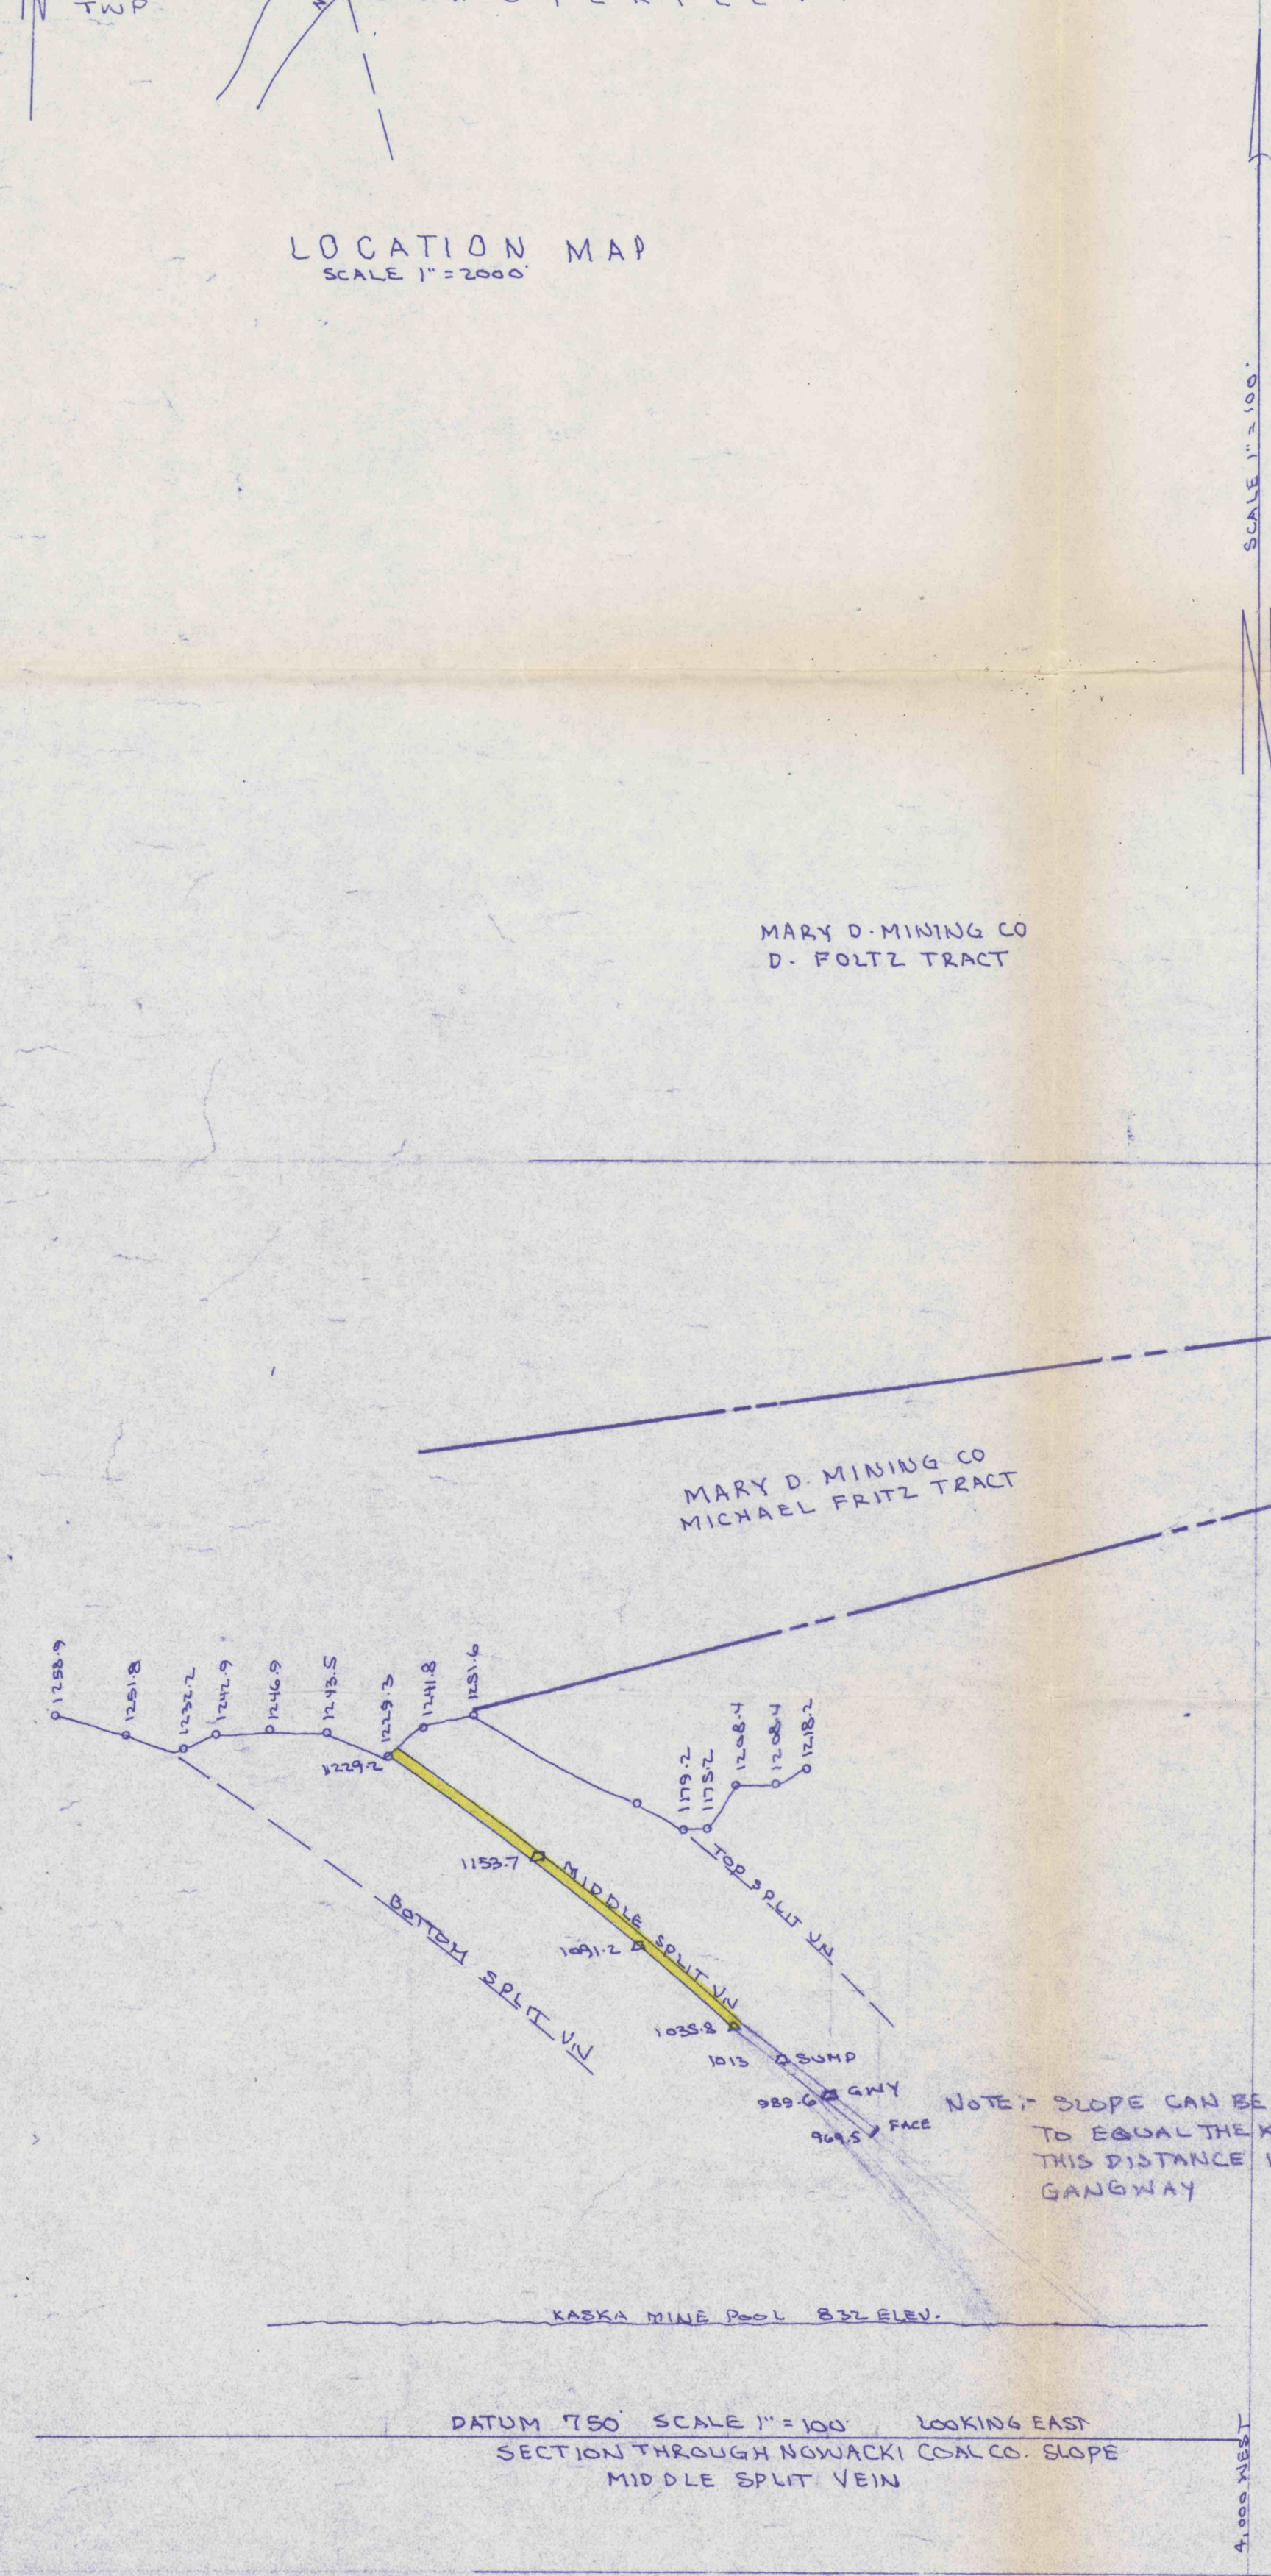

MARY D. MINING CO.
D. FOLTZ TRACT

MARY D. MINING CO.
MICHAEL FRITZ TRACT

MARY D. MINING CO.
JOHN SELTZER TRACT

MARY D. MINING CO.
MARY METZ TRACT

NOTE: MINE WATER IS PUMPED FROM THE SLOPE SUMP
TO THE MONKEY AND ALONG MONKEY TO NO. 10 BREAST.
UP NO. 10 BREAST TO NO. 1 TEST BORE HOLE.

Nowacki Coal Co. SLOPE
NOWACKI COAL COMPANY ID #36-07582
SCHUYLKILL & BLYTHE TWP. SCHUYLKILL CO.

NOTE: THERE IS NO KNOWN POOLED WATER ON THE SURFACE WITHIN THE MAPPED AREA.
THE SUB-SURFACE LEVELS ARE AT LOCATIONS & ELEVATIONS SHOWN
ON THE MAP. THERE ARE NO R.R. OR PAVED ROADS LEADING TO THE MINE ACCESS
IS FROM A DIRT ROAD SHOWN ON THE MAP. PERMANENT BUILDINGS ON THE SITE
CONSIST OF THE NO. 10 HOUSE AND SURFACE FAN, AS SHOWN ON THE MAP.
SURFACE SURVEY TIE IN POINTS ARE SHOWN ON THE MAP.

AIR VOLUME

Q1	= 15,300
Q2	= 5,725
Q3	= 15,000
Q4	= 5,000
Q5	= 7,500
Q6	= 15,100
Q7	= 5,000
Q8	= 5,000

INTAKE VENT AT PORTAL
FURNISHING VENT IN GANGWAY
(FACES)
LAST OPEN X-CUT 187
OVERCAST
FAN EXHAUSTING
FACE EAST G.W.Y.
FACE SLOPE

MARY D. MINING CO.
MARY METZ TRACT

FAN - AMERICAN STANDARD
SINOCO FAN, DIE 270
SERIAL #270-1 DIRECT DRIVE
INTERNAL COMBUSTION ENGINE 100 H.P.
1" H.G.

MARY D. MINING CO.
MARY METZ TRACT

NOTE: APPROXIMATE LOCATION SILLIMAN
SLOPE IN THE BOTTOM SPLIT VEIN
NO MINING INFO. AVAILABLE ON
100' TO 1" MAP. THE INFORMATION
ON THE 300' TO 1" MAP SUBMITTED
NOVEMBER 5, 1991 IS THE ONLY INFORMATION
I CAN FIND AND ONLY SHOWS WORKINGS
ON THE BOTTOM SPLIT VEIN.

LEGEND

DOOR = D
STOPPING = ||
OVERCAST =
BRATTIC =
DIRECTION OF AIR =
REGULATOR = R
CURTAIN OR CHECK = C
FAN = 27 CENTRIFUGAL SINOCO FAN
F = 22,000 CFM
ESCAPE WAY = E
BONDED SURFACE AREA
PROPOSED NEW WORKINGS
SEAL =
EP = EVALUATION POINT
BEP = BLEEDER EVALUATION POINT

Received

JUL 07 1997

U.S. DEPT. OF LABOR
MSHA
WILKES-BARRE, PA.

COUNTY LEASE NO. 7A
NOWACKI COAL COMPANY
SITUATE IN SCHUYLKILL & BLYTHE TWP.
SCHUYLKILL CO., PA.
SURVEYED MARCH 30, 1991 SCALE 1" = 100'
HALTER J. MINNIX R. SMITH TO BE 1190K
MINE I.D. # 36-07592
POSTED JAN. 24, 1993
POSTED JAN. 15, 1994
POSTED JAN. 21, 1995
POSTED MAY 4, 1996
POSTED JAN. 22, 1997
POSTED MAY 6, 1997

MIDDLE SPLIT VEIN WORKINGS OF NOWACKI SHOWN IN
PROPOSED NEW WORKINGS SHOWN IN BROWN
ELEVATION BASE FROM SET STONE BY HUDSON
COAL CO. SITUATE AT THE SOUTHWEST CORNER
OF THE ADAM STAHL TRACT.

W. J. Minnix