


MINE MAP
of the
New Lincoln Coal Company Workings
allude
Tremont & Frailey Townships, Schuylkill County,
ID. #36-07629

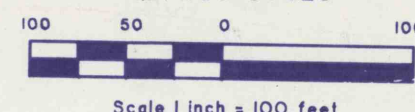

Scale 1 inch = 100 feet
Survey: June 8, 1994
Survey: April 26, 1995
Survey: June 19, 1996

Surveyor's Certification

I hereby certify that to the best of my knowledge that the areas that I have surveyed are true and correct as to the requirements of 30 CFR Part 75.1200. All other information shown has been derived from the best available information but can not be field checked. Therefore, surveyor makes no certification to their accuracy.

David L. Williams
David L. Williams, P.E.

Mine Operator's Certification

I depose and say that the mine ventilation information shown on this map meets the requirement of 30 CFR Part 75.372 and was prepared by me or under my direction for which I accept full responsibility.

John Kreh
John Kreh

VENTILATION SYMBOLS
(where appropriate)

- Main Fan
- Auxiliary Fan
- Air Flow (Main)
- Air Flow (Return)
- I Stopping
- ⊠ Air Bridge
- P Regulator
- ⊥ Main Door
- V Velocity, fpm
- Q Quantity, cfm
- WS Water Surface, ft
- Chokepoint
- ⊠ Bleeder Evacuation Point
- ⊠ Pillar Removal or Rooking
- ⊠ Mine Seal
- ⊠ Active Workings (Yellow)
- ⊠ Carbon or Bitulite
- ⊠ Workings Not Surveyed
- ⊠ Contour Ground

