


MINE MAP
of the
New Lincoln Coal Company Workings
situate
Tremont & Frailey Townships, Schuylkill County,

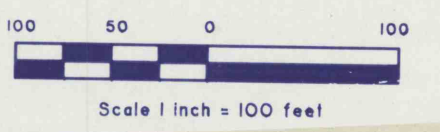


MINE MAP

Showing the location and extent of
development of the New Lincoln Coal
Company, situate on the east dip of the
Lykens Valley #1 vein, Frailey and Tremont
Townships, Schuylkill County.

A.B. Riedel, P.E.

June 8, 1993
Scale 1"=100'

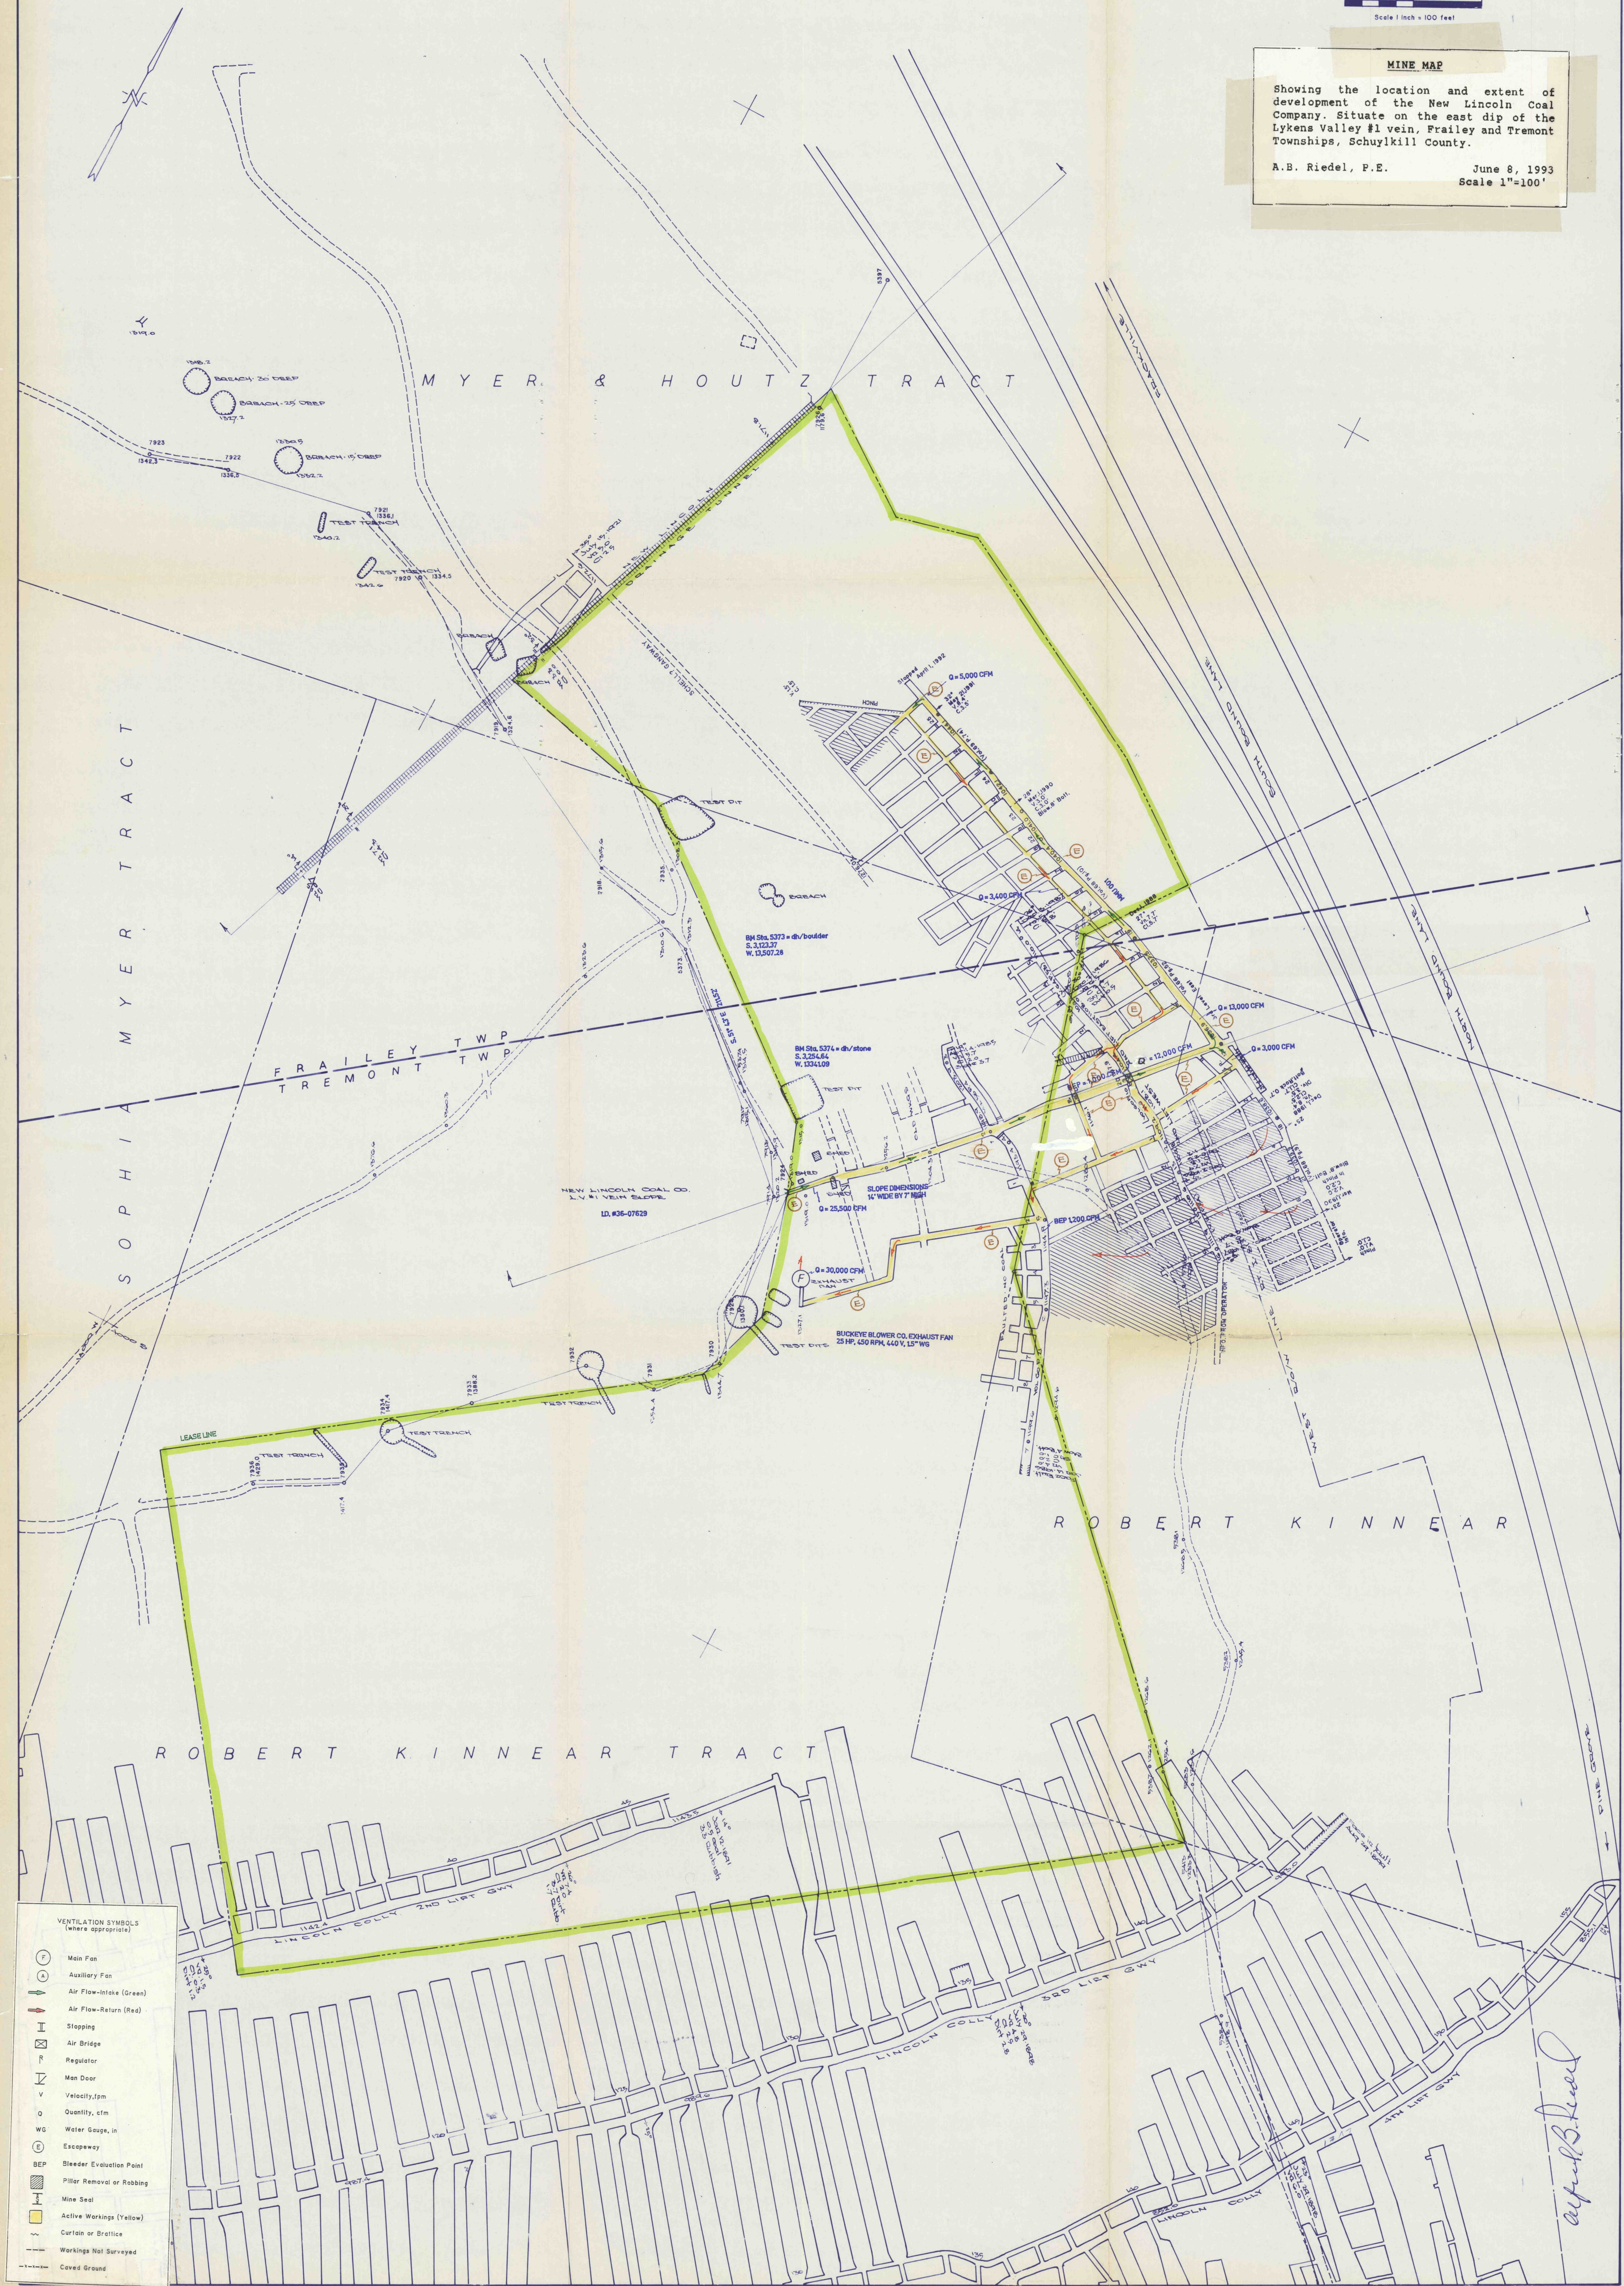

- VENTILATION SYMBOLS
(where appropriate)
- Main Fan
 - Auxiliary Fan
 - Air Flow-Intake (Green)
 - Air Flow-Return (Red)
 - Stopping
 - Air Bridge
 - Regulator
 - Man Door
 - Velocity, fpm
 - Quantity, cfm
 - Water Gauge, in
 - Escapeway
 - BEP
 - Bleeder Evaluation Point
 - Pillar Removal or Robbing
 - Mine Seal
 - Active Workings (Yellow)
 - Curtain or Brattice
 - Workings Not Surveyed
 - Caved Ground

april B. Riedel