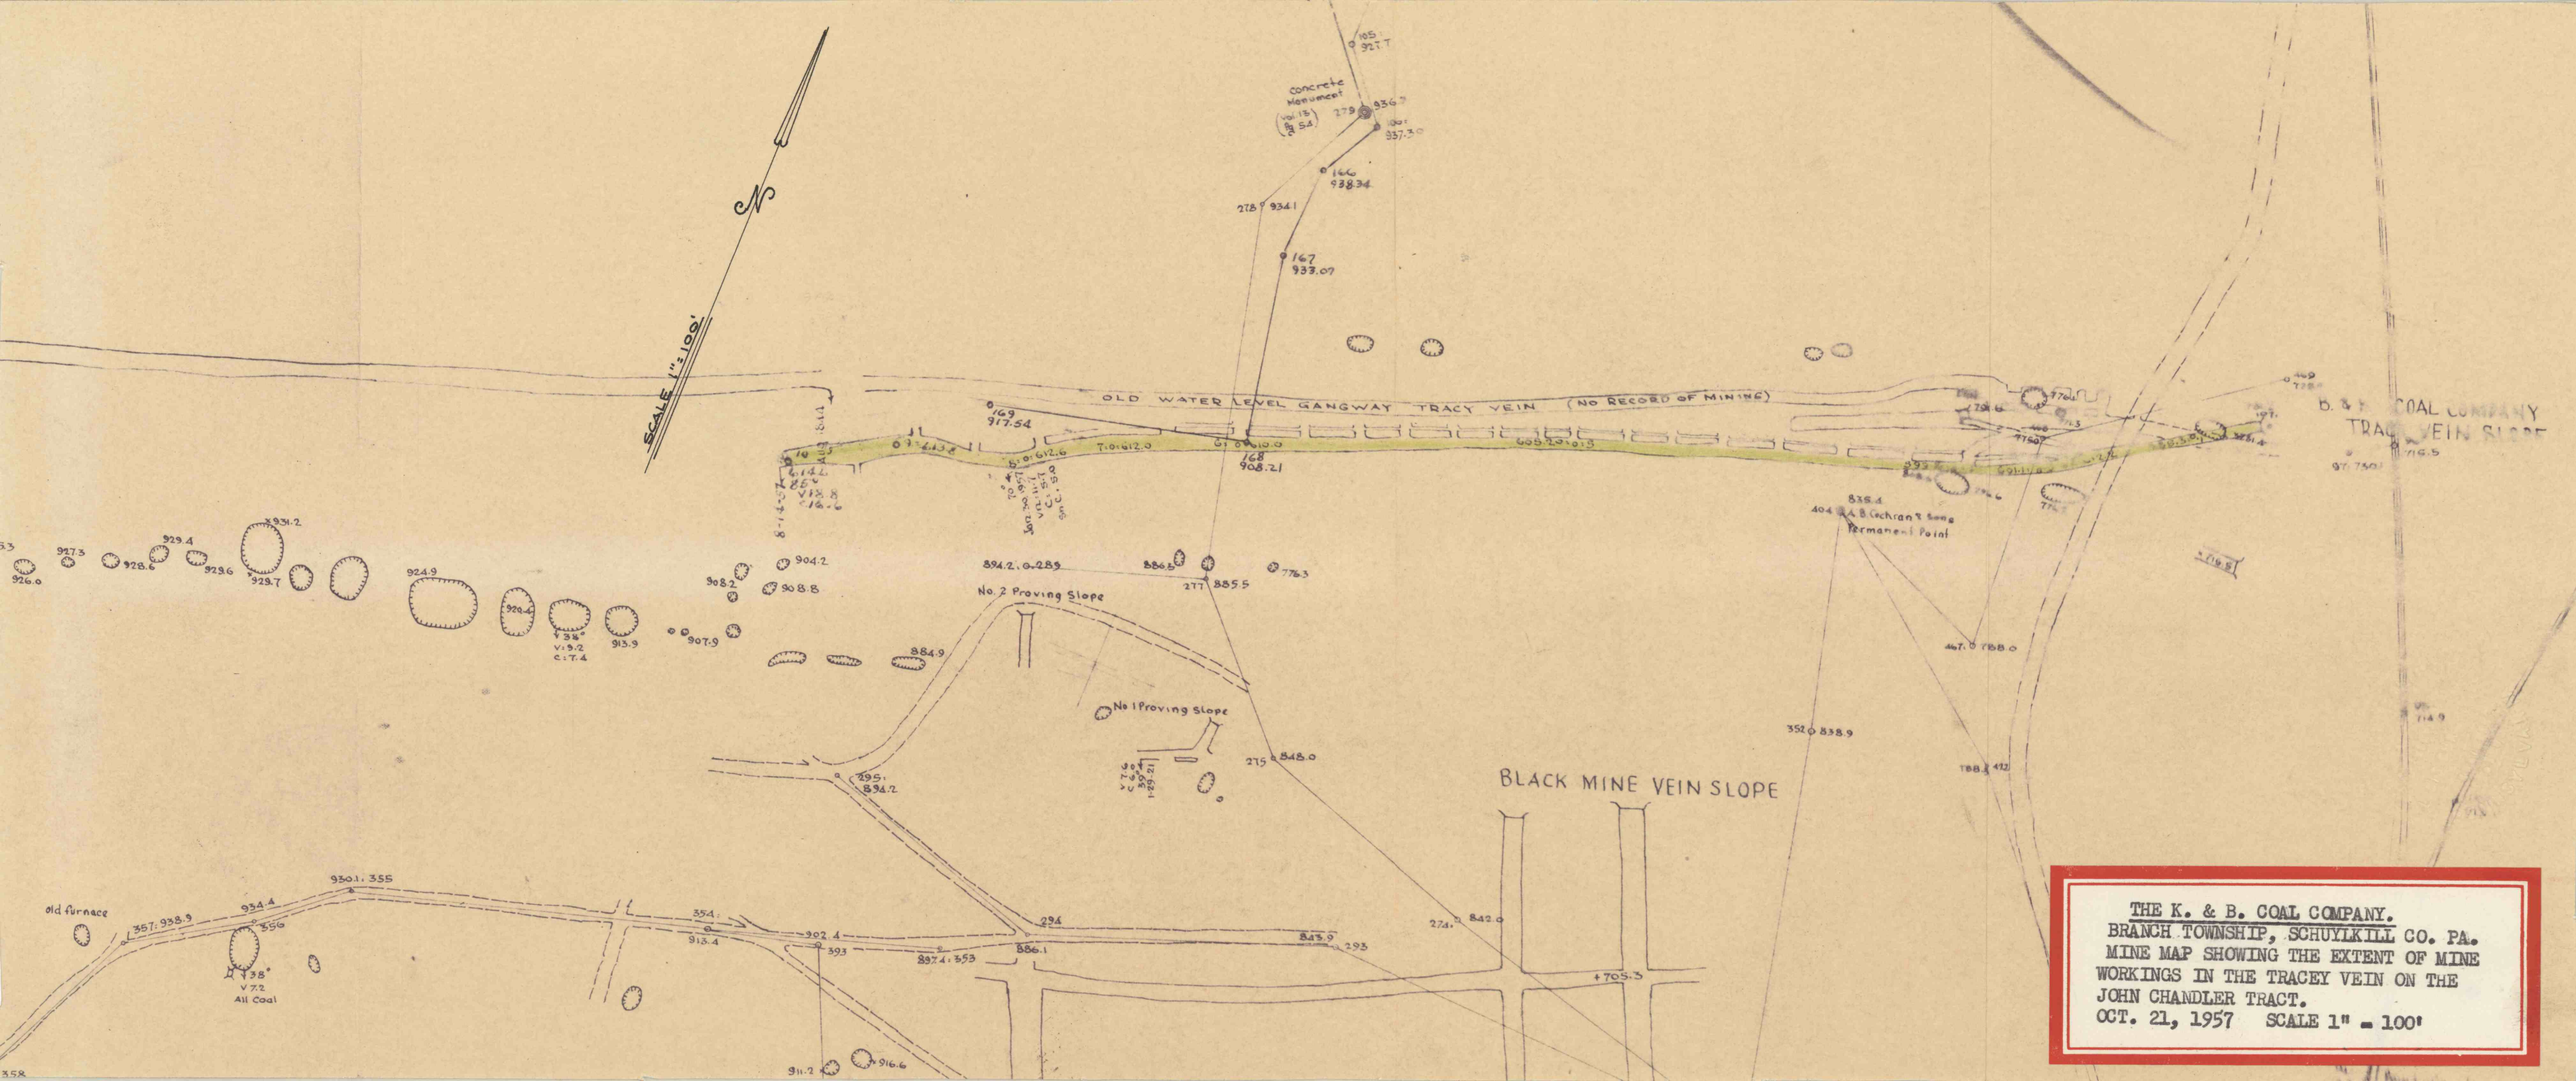

THE K. & B. COAL COMPANY.
BRANCH TOWNSHIP, SCHUYLKILL CO. PA.
MINE MAP SHOWING THE EXTENT OF MINE WORKINGS IN THE TRACEY VEIN ON THE JOHN CHANDLER TRACT.
OCT. 21, 1957 SCALE 1" = 100'