


MAP TO ACCOMPANY APPLICATION FOR PERMIT
FROM THE SANITARY WATER BOARD
FOR VARIOUS OPERATORS, IN FOSTER TWP, SCHUYLKILL CO., PA.

Scale 1"=1500'

June, 1956

R.F. Schenck, Engr.

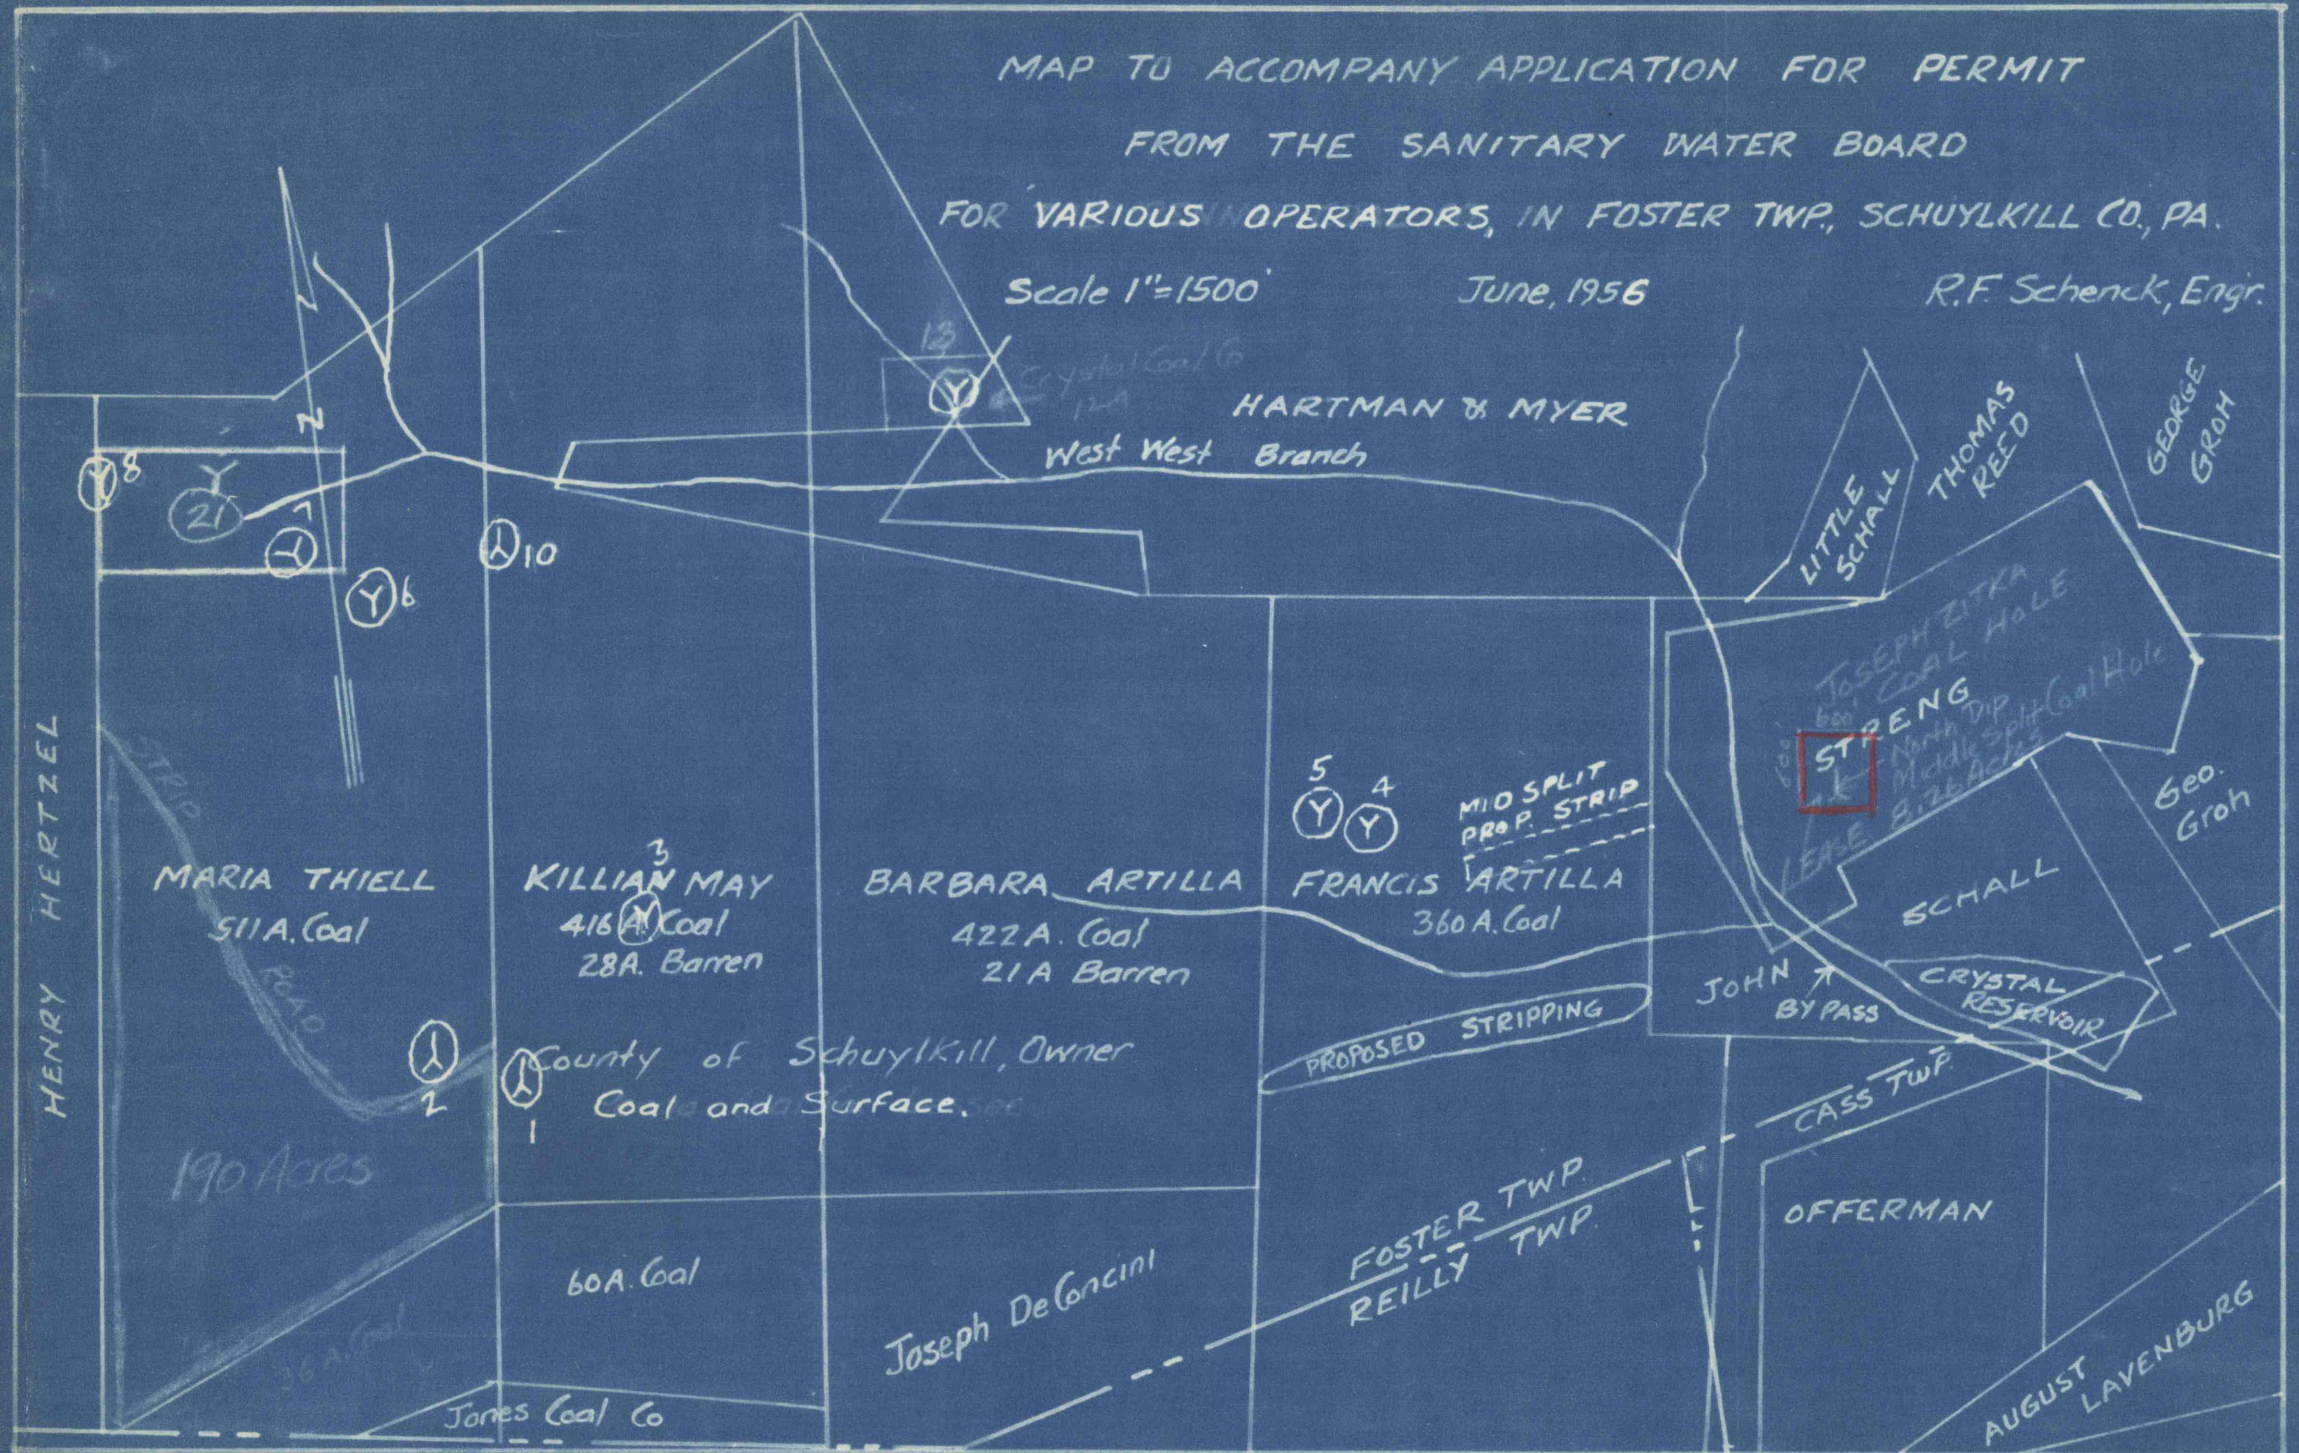

18/5