
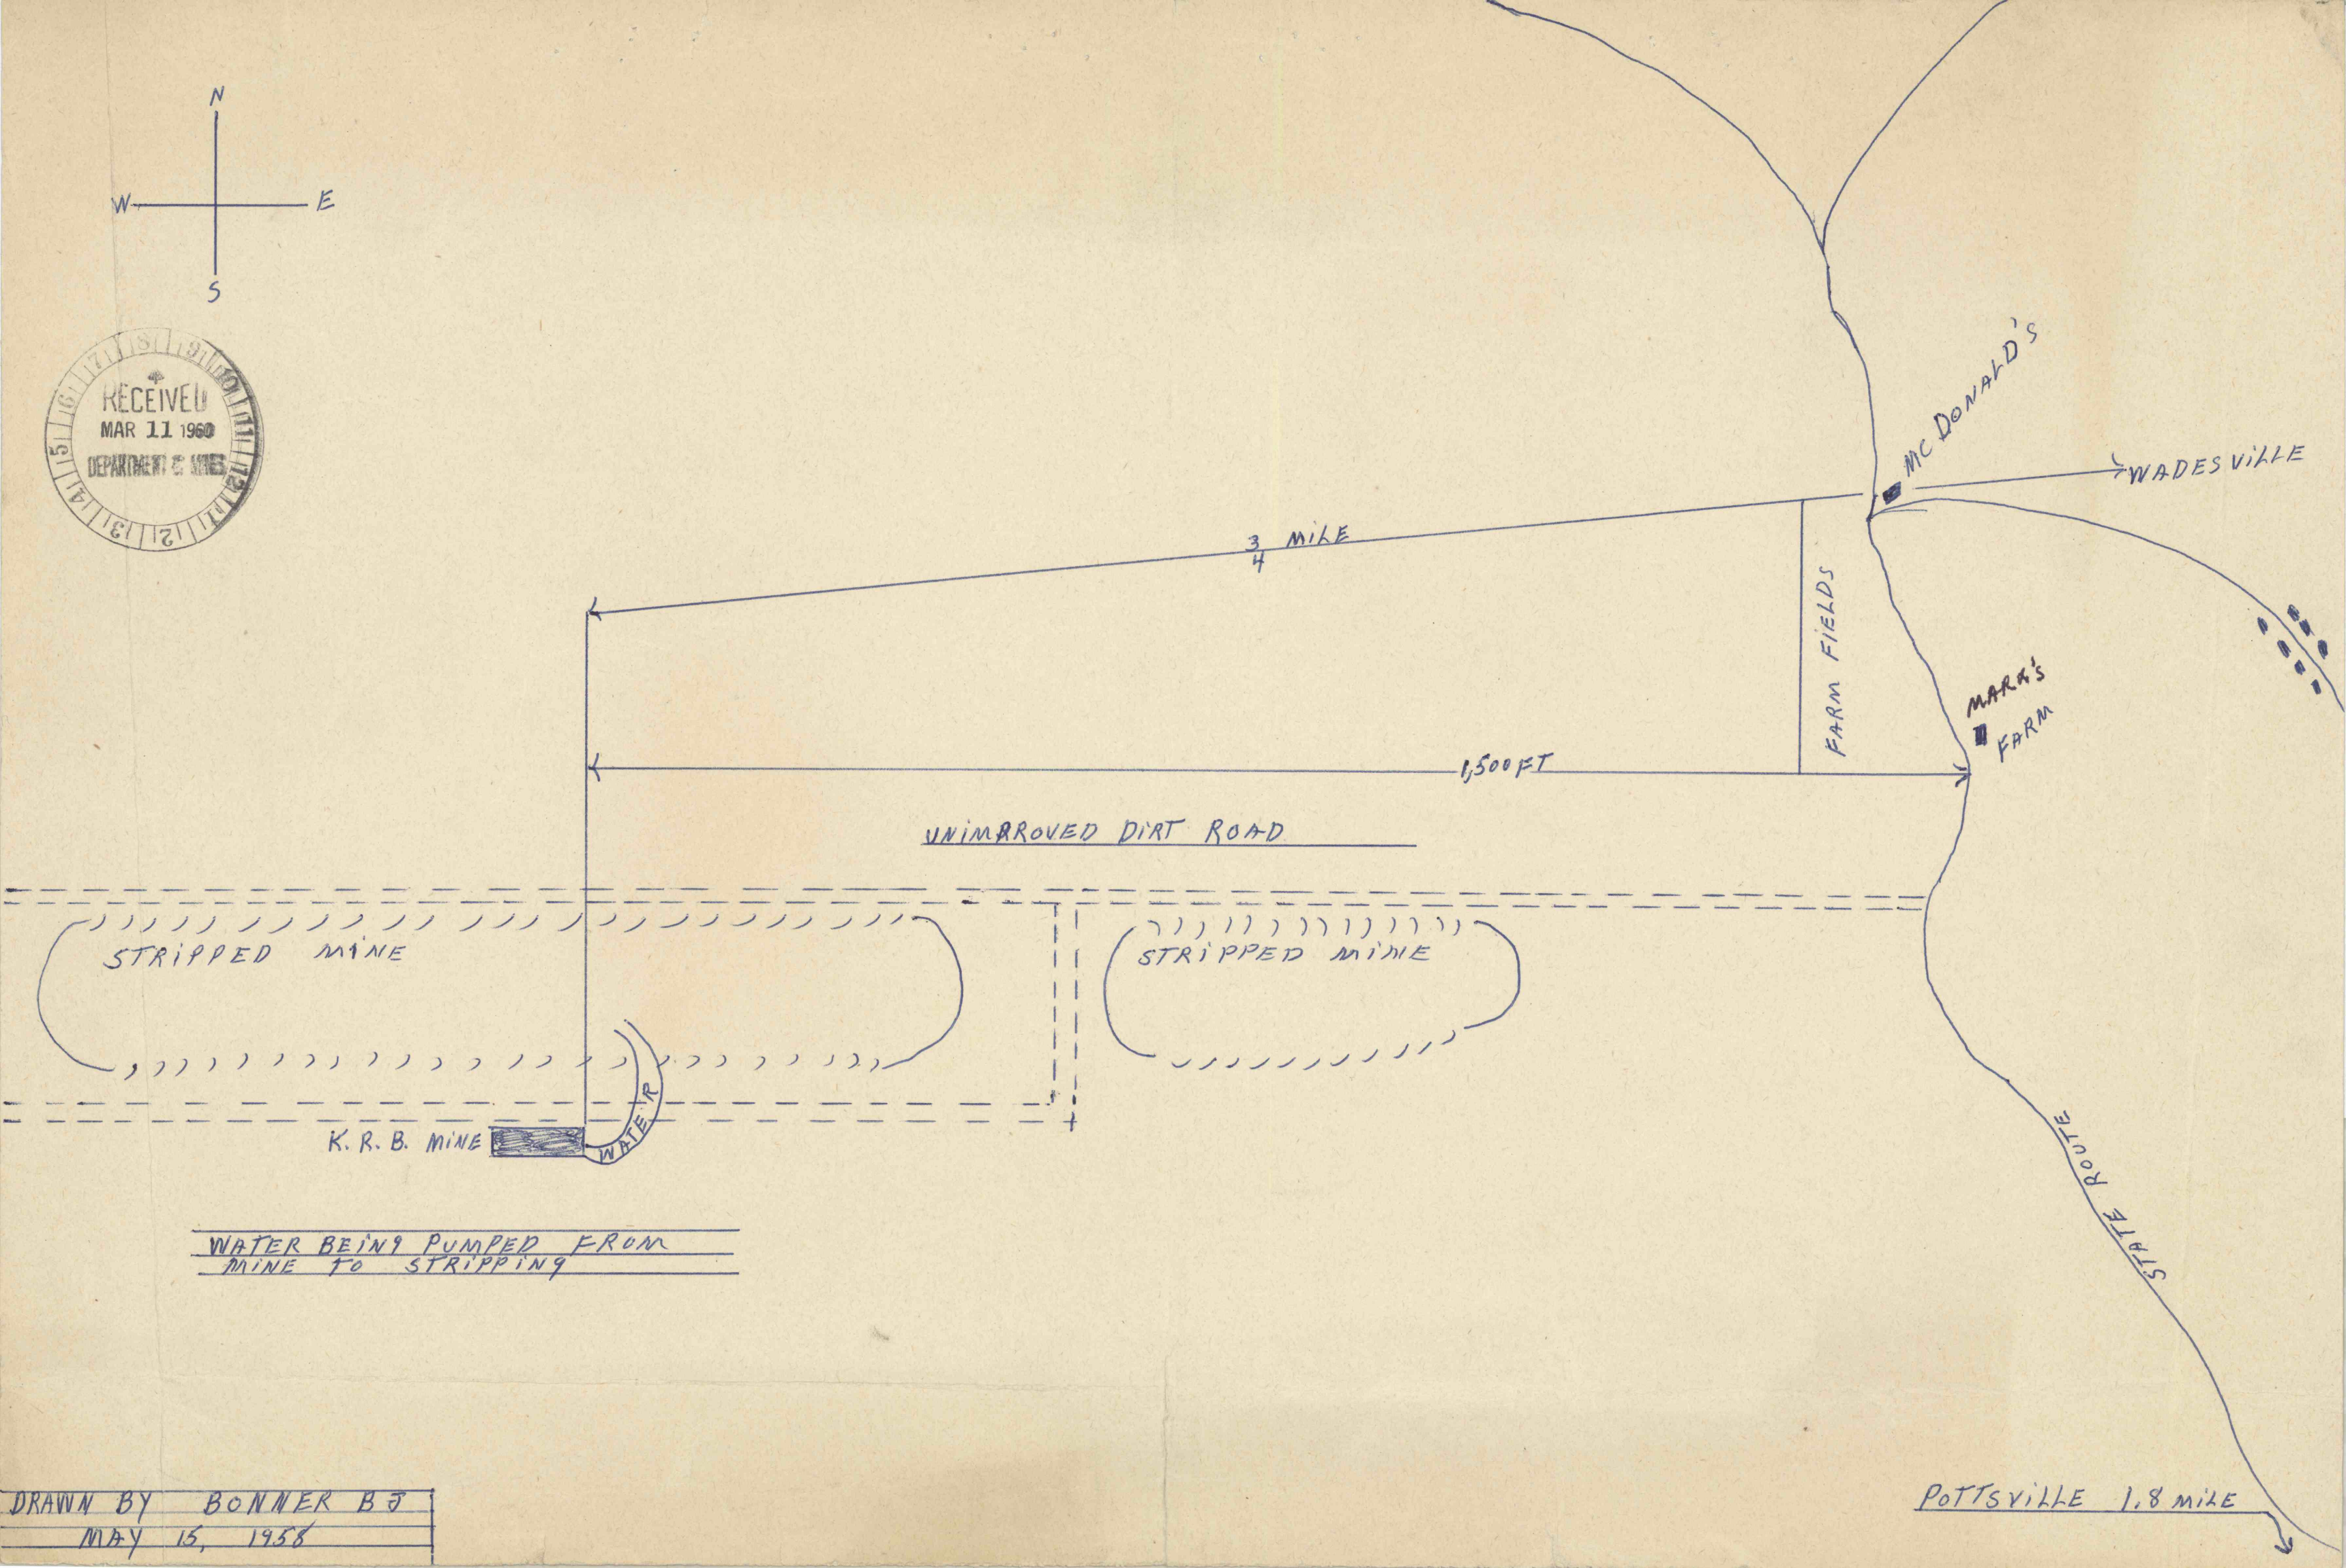


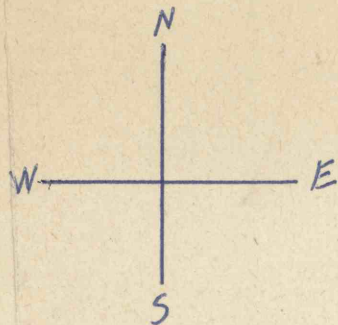

DRAWN BY BONNER B J
MAY 15, 1958