


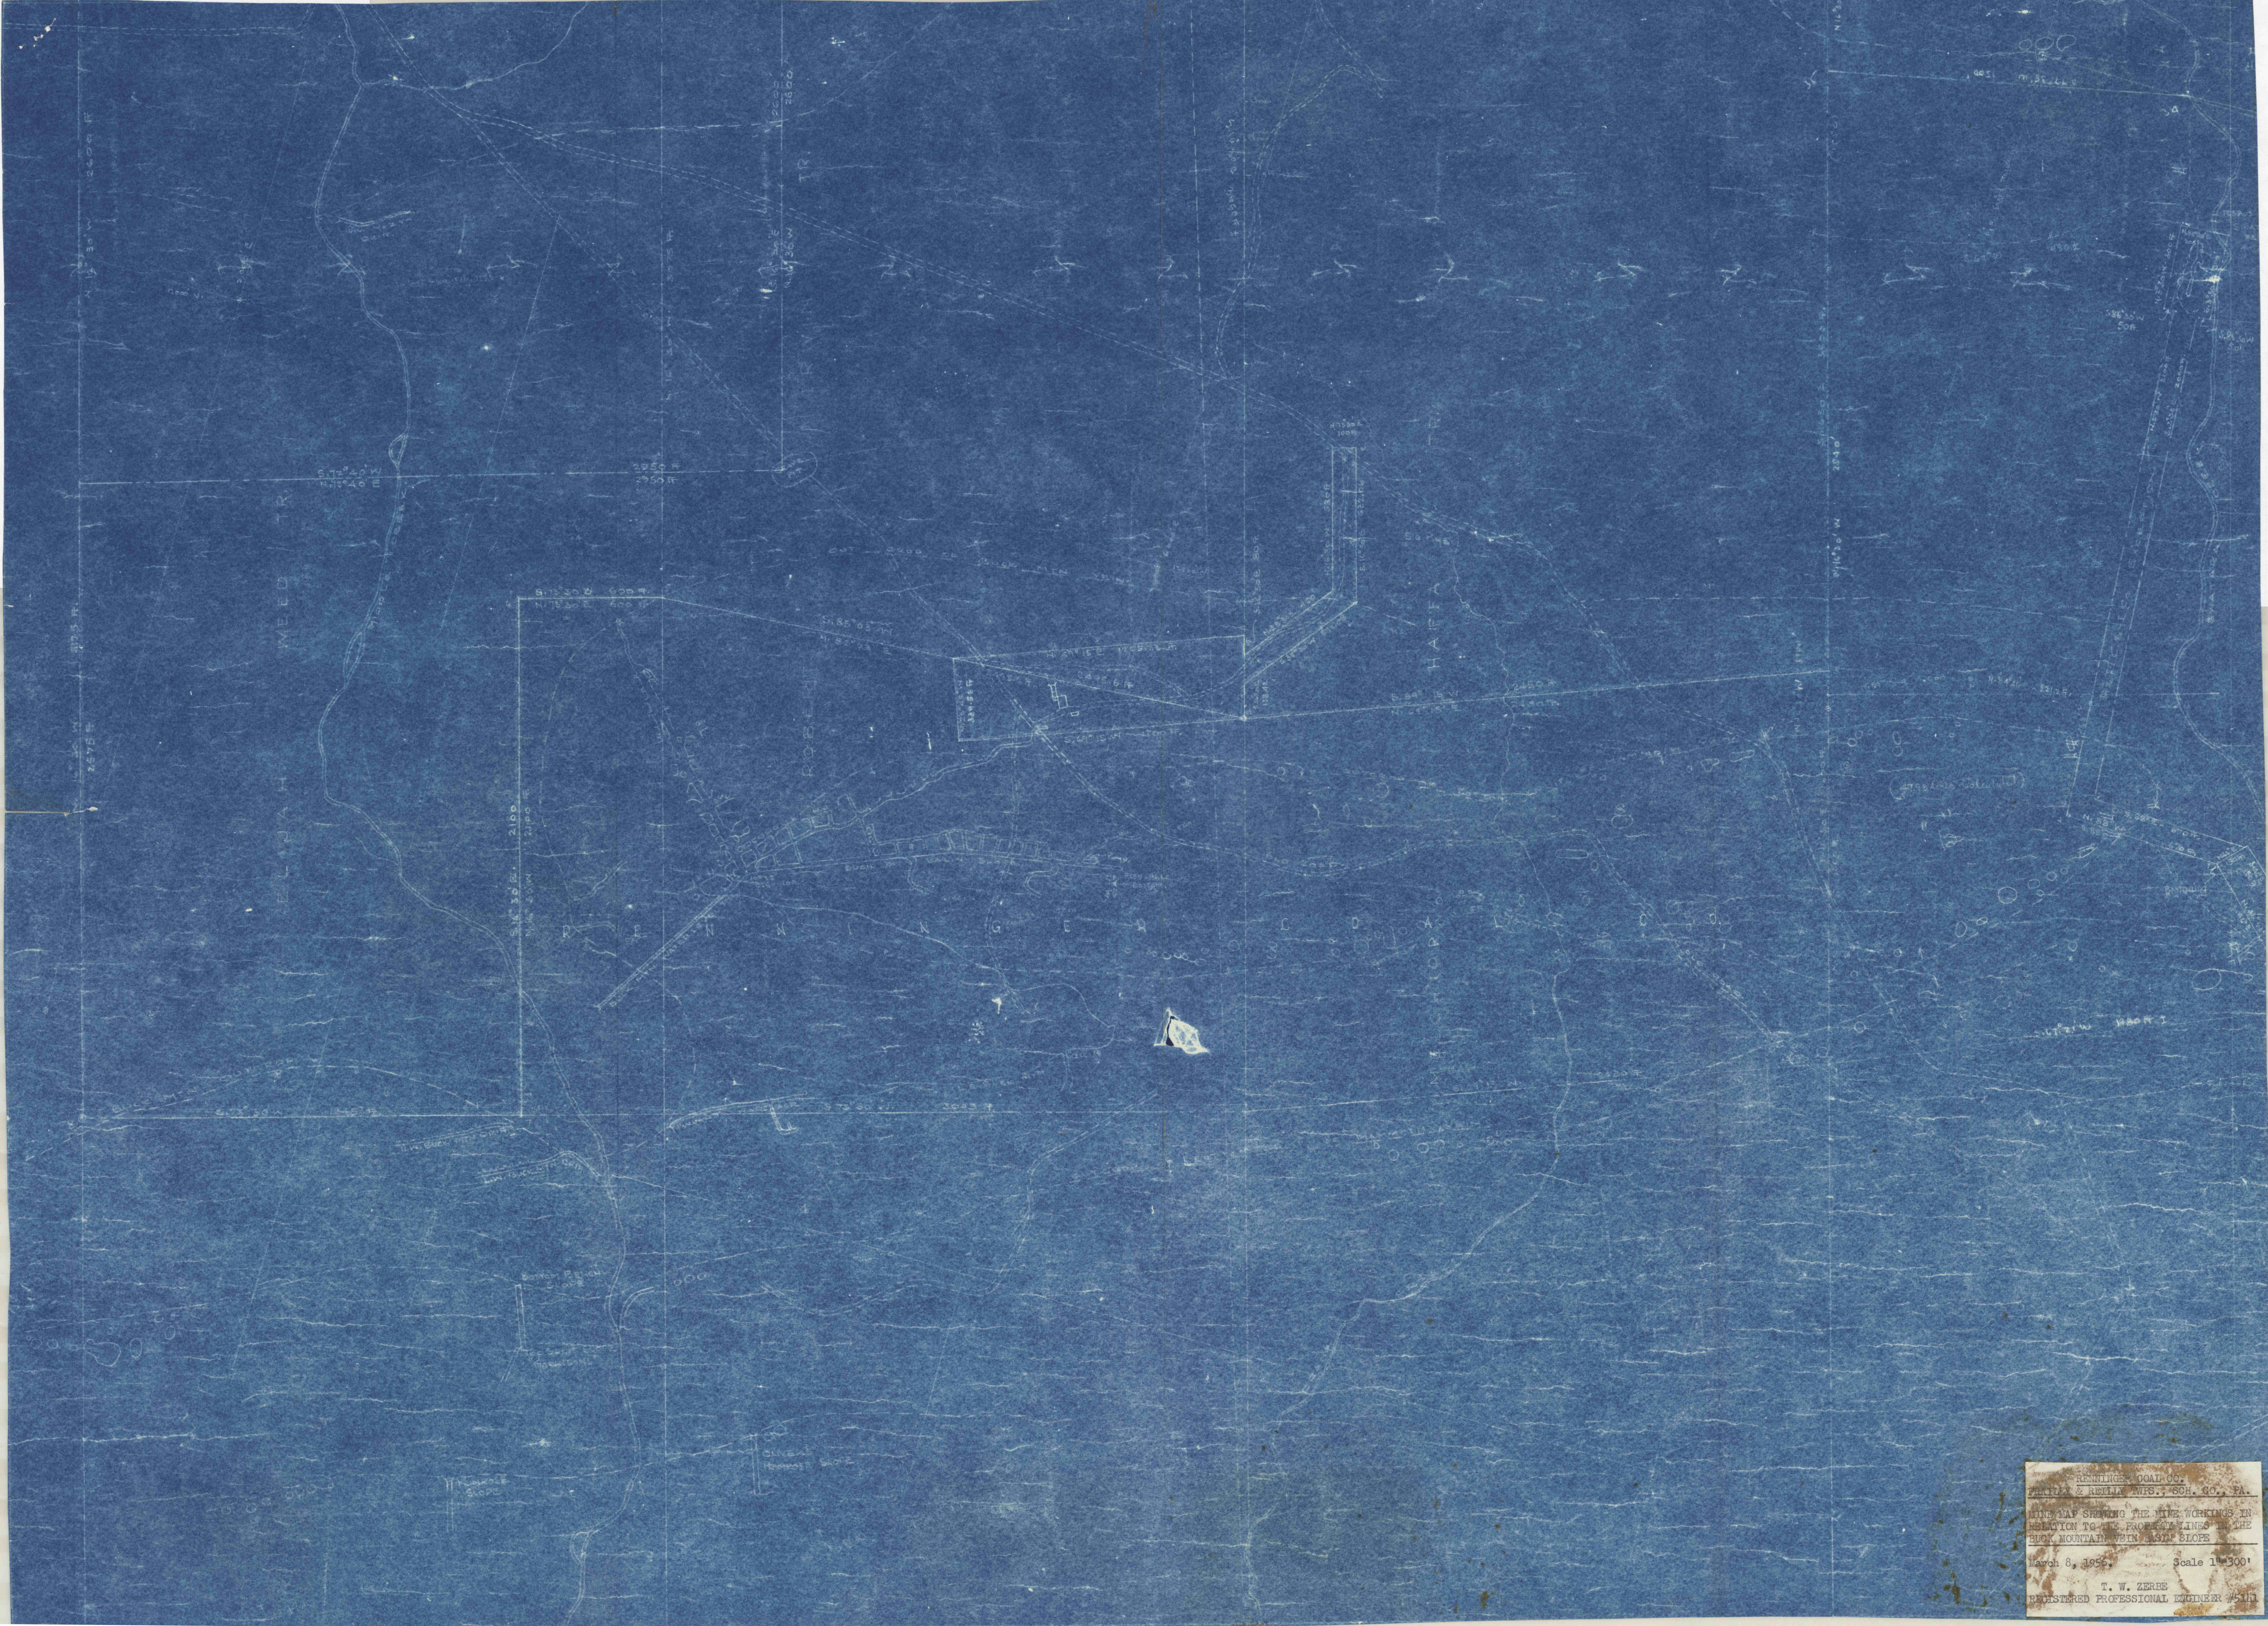

RENNING COAL CO.
FRANK E. RENNING MRS. J. SCH. 90, FLA.
MINE MAP SHOWING THE MINE WORKINGS IN
RELATION TO THE PROPERTY LINES IN THE
BUCK MOUNTAIN WITH EAST SLOPE
March 8, 1956. Scale 1" = 300'
T. W. ZERBE
REGISTERED PROFESSIONAL ENGINEER #5111