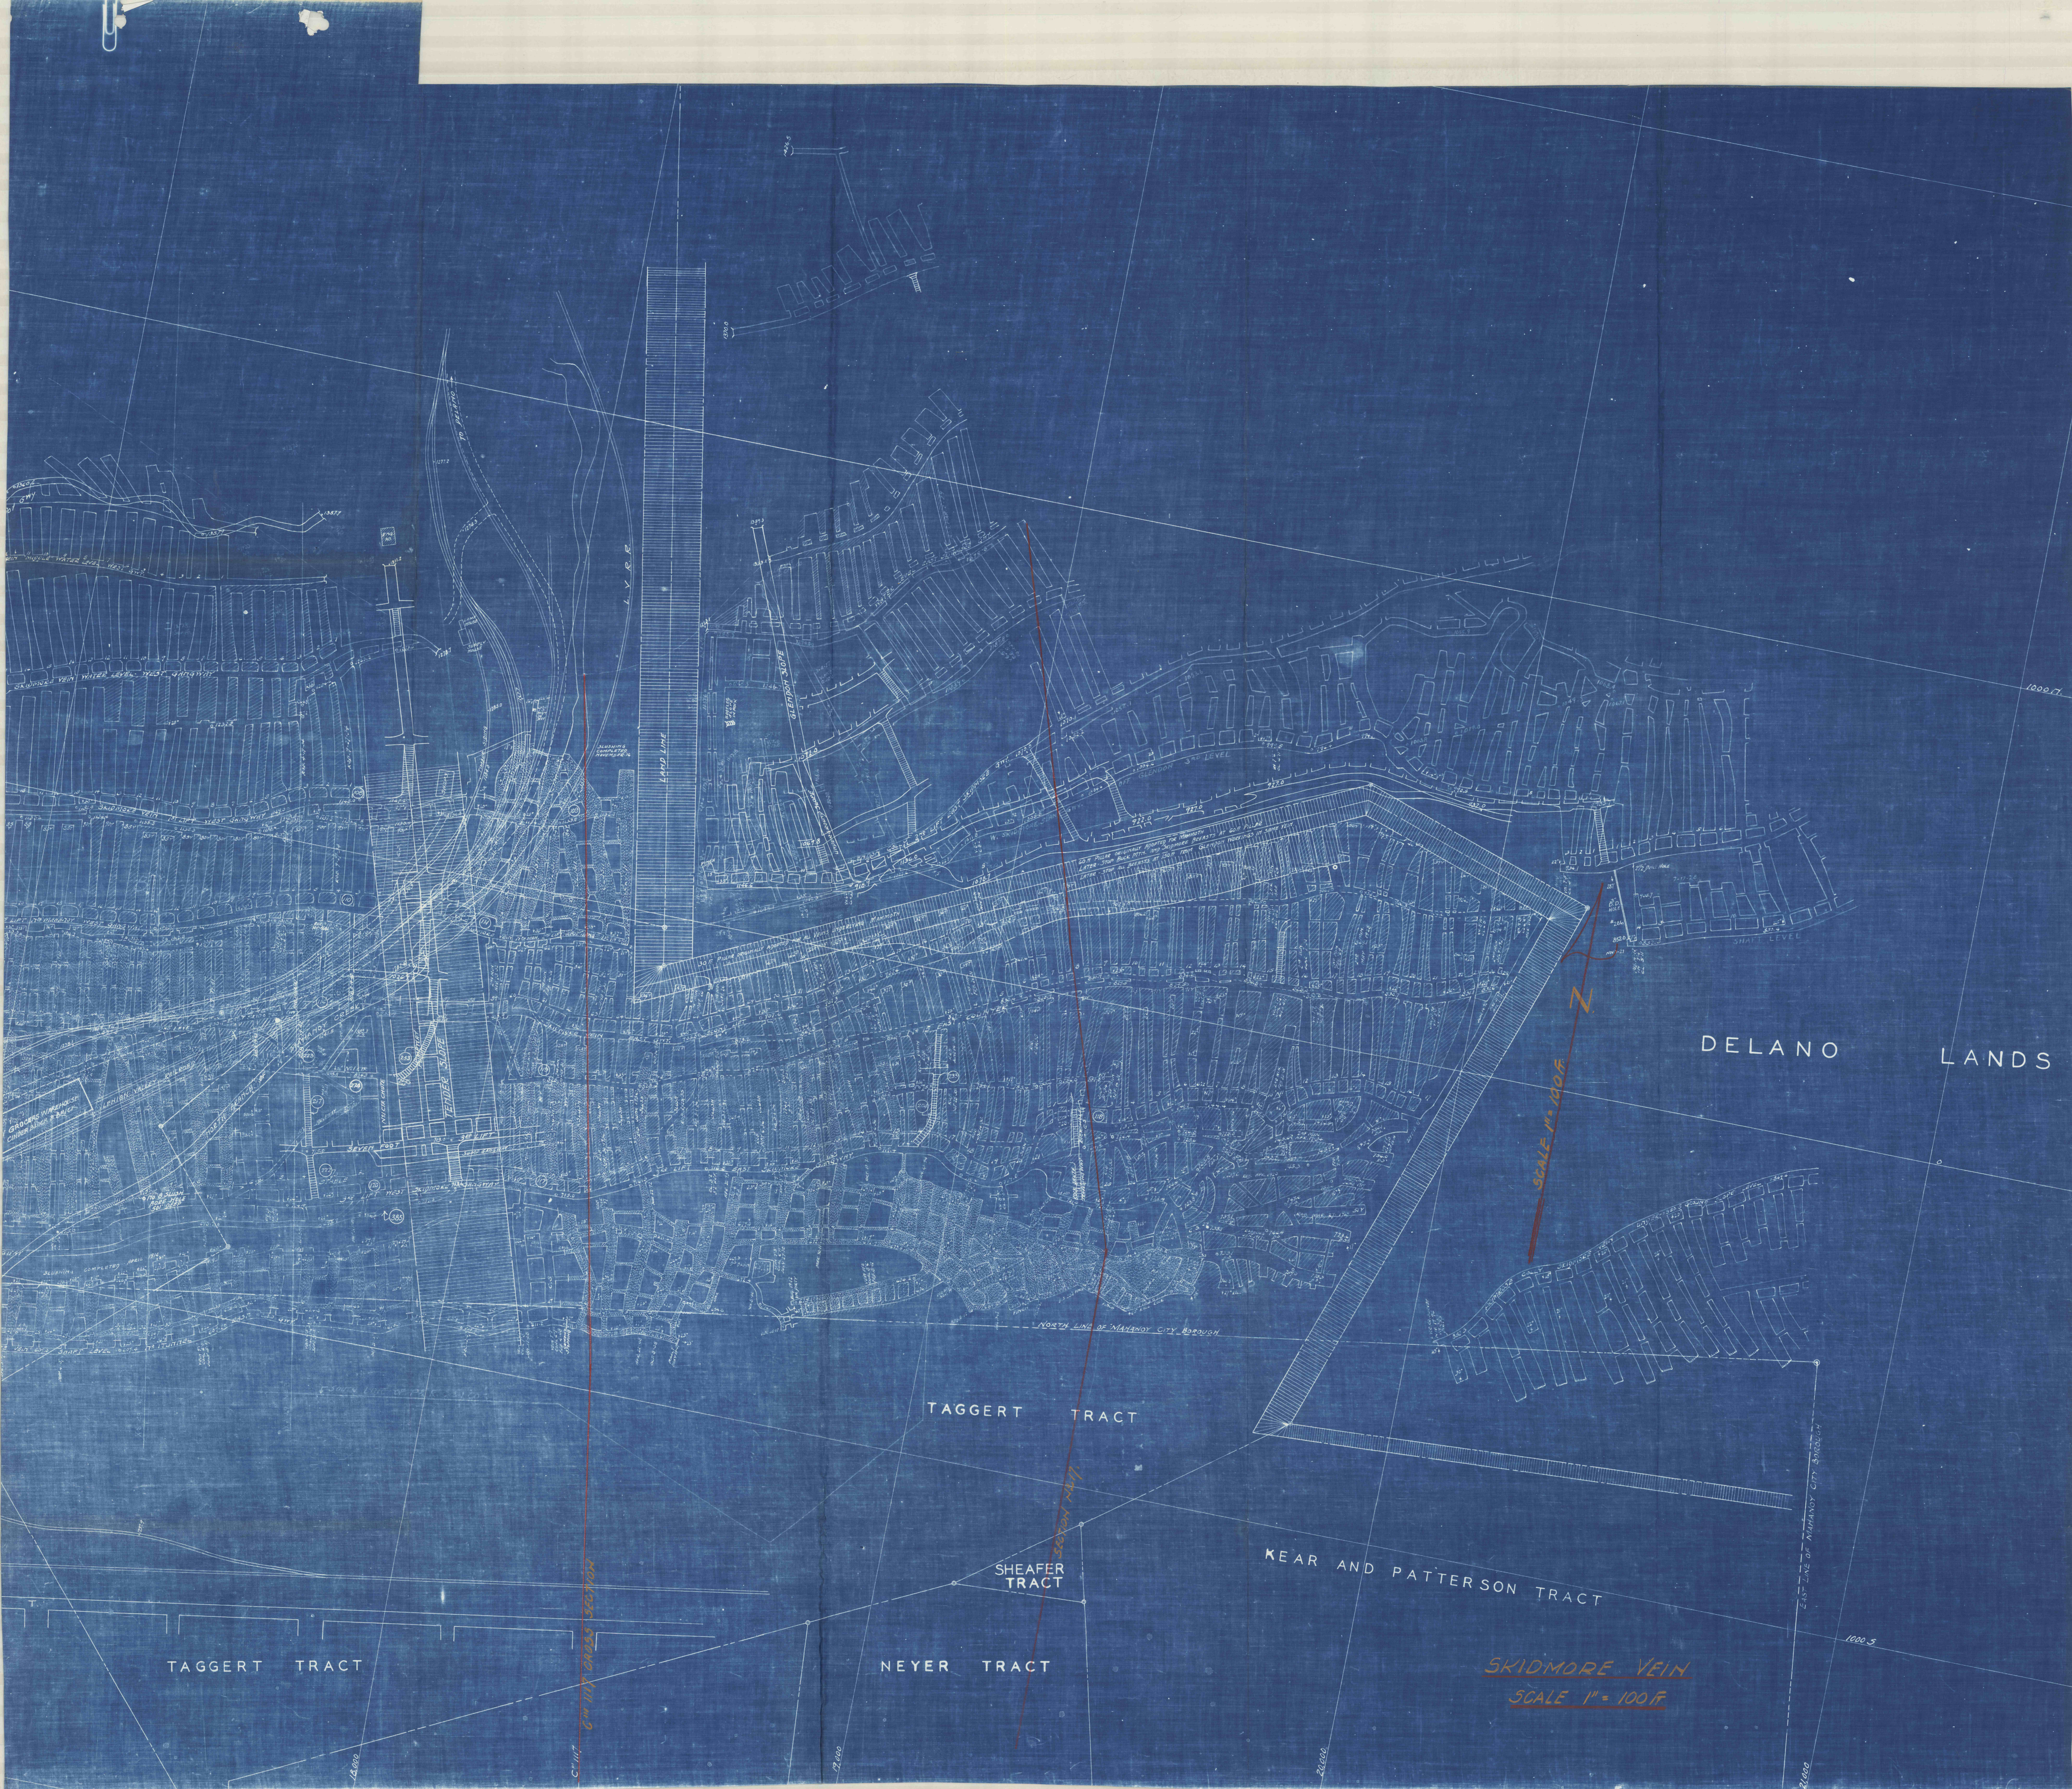
L.V.R.R.
LAND LINE
TO DELANO
ENG. HO.
LAMP HOUSE
SUPPLY HOUSE
SHOPS
TIMBER SIDING
SLUSHING COMPLETED NOVEMBER 16
SKIDMORE VEIN WATER LEVEL WEST GANGWAY
SKIDMORE VEIN 1ST LIFT WEST GANGWAY
1ST LIFT MAMMOTH WEST GANGWAY
GLENDON SLOPE
BOOTLEG SLOPE IN ROCK
UNDERGROUND SLOPE
WATER LEVEL EAST SKIDMORE GWY.
2ND LIFT EAST SKIDMORE GWY.
OFF GLENDON 3RD LEVEL
W. SKIDMORE SLANT GWY.
60 FT PILLAR ORIGINALLY ADOPTED FOR MAMMOTH
LATER - STOP BUCK MTN. AND SKIDMORE BREASTS AT 60 FT PILLAR
LATER - STOP ALL BREASTS AT 150 FT FROM GLENDON WORKINGS IN SAME VEIN.
30 FT PILLAR ORIGINALLY ADOPTED FOR ALL VEINS UNDERLYING MAMMOTH
GROCERS WAREHOUSE CINDER BLOCK & BRICK
LEHIGH VALLEY RAILROAD
NORTH BRANCH OF MAHANOY CREEK
TENDER SLOPE
SEVEN FOOT
3RD LIFT
SUMP GANGWAY
STABLE
3RD LIFT WEST SKIDMORE GANGWAY
SLUSHING COMPLETED APRIL 1914
SHAFT LEVEL
NO 15 EAST COUNTER
2ND LIFT EAST SKIDMORE GANGWAY
2 1/2" DRILL HOLE
7-17-28
D.D. HOLE
#286
852.0
NORTH LINE OF MAHANOY CITY BOROUGH
EAST LINE OF MAHANOY CITY BOROUGH
PRIMROSE COLLY SKIDMORE VEIN UNDERGROUND SLOPE LEVEL
DELANO LANDS
TAGGERT TRACT
SHEAFER TRACT
KEAR AND PATTERSON TRACT
TAGGERT TRACT
NEYER TRACT
C'' 1117 CROSS SECTION
SECTION No 17
4
N.
SCALE 1" = 100 FT
1000 N.
1000 S.
18,000
19,000
20,000
21,000
SKIDMORE VEIN
SCALE 1" = 100 FT