



 


CROSS SECTION THROUGH 7 FOOT SLOPE
RANDY COAL CO
THOMASTON WATER - 762
RICHARDSON WATER - 790

NOTE: THERE IS WORKING IN
THE SEVEN FOOT VEIN
ON THIS PROPERTY UNKNOWN
TO THE ENGINEER

MINING MAP
CASS TOWNSHIP SCH. CO. PA.
SHOWING RANDY COAL CO'S 7 FT SLOPE
SURVEYED APRIL 12 1986 SCALE 1"=100'
WALTER J. MAHART P.E. # 1195 K
POSTED DEC. 23, 1989

- "LEGEND"
- D - DOOR
 - OVERCAST
 - STOPPING
 - BRATTICE
 - AIR DIRECTION
 - R - REGULATOR
 - C - CURTAIN OR CHECK
 - F - FAN
 - ESCAPEWAY
 - RED - LITTLE BUCK
 - GREEN - BUCK MTN
 - BLACK - 7 FT VEIN & RIDGE VEIN
 - [X] - ROBBED

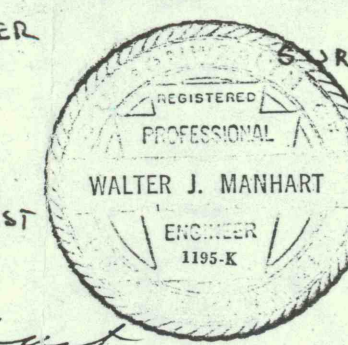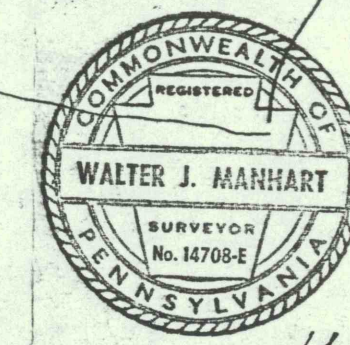

SURVEYED JULY 12, 1986
JANUARY 2, 1988
JULY 1, 1989
FEB. 16, 1991

- "LEGEND"
- D - DOOR
 - OVERCAST
 - STOPPING
 - BRATTICE
 - AIR FLOW
 - R - REGULATOR
 - C - CURTAIN OR CHECK
 - F - FAN
 - ESCAPEWAY
 - RED - LITTLE BUCK
 - GREEN - BUCK
 - BLACK - RIDGE VEIN
 - [X] - ROBBED AREA