Source of Information:

1. Silver Creek Colliery Mine Maps
2. Tucker Hill Coal Company Mine Map prepared by Elwood P. Wirth and dated December 4, 1990.
3. Survey dated November 5, 1991.

VENTILATION SYMBOLS

- (F) = Main Fan
- (A) = Auxiliary Fan
- = Air Flow - Intake
- = Air Flow - Exhaust
- = Permanent Stopping
- = Temporary Stopping
- = Air Bridge
- R = Regulator
- = Man Door
- V = Velocity, fpm
- Q = Quantity, cfm
- WG = Water Gauge
- (E) = Escapeway
- BEP = Bleeder Evaluation Point
- = Robbed Area
- = Projected Mining

MINE MAP

Showing the location and extent of development of the Tucker Hill Coal Company's No.1 slope. Situate on the southwestern slip of the Orchard Vein in Blythe Township, Schuylkill County, PA.
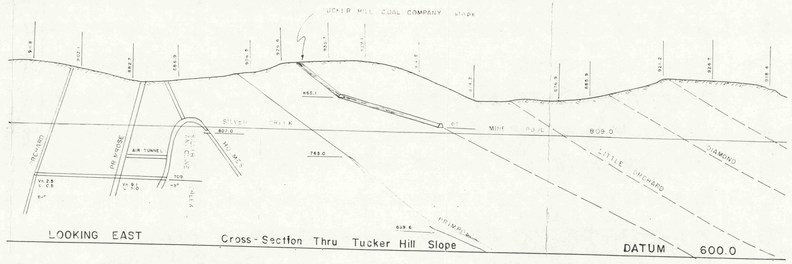
S.M.P. #54841308 Scale: 1" = 100'
M.S.H.A. #36 07478 November 5, 1991