

NORTHUMBERLAND
COUNTY COMMISSIONERS


LEONA BOSLEGO

ALEXANDER HUNTER WARRANTEE TRACT

LAND SALES COLLIERY

ROSINI COAL COMPANY

ROBERT DONAHUE

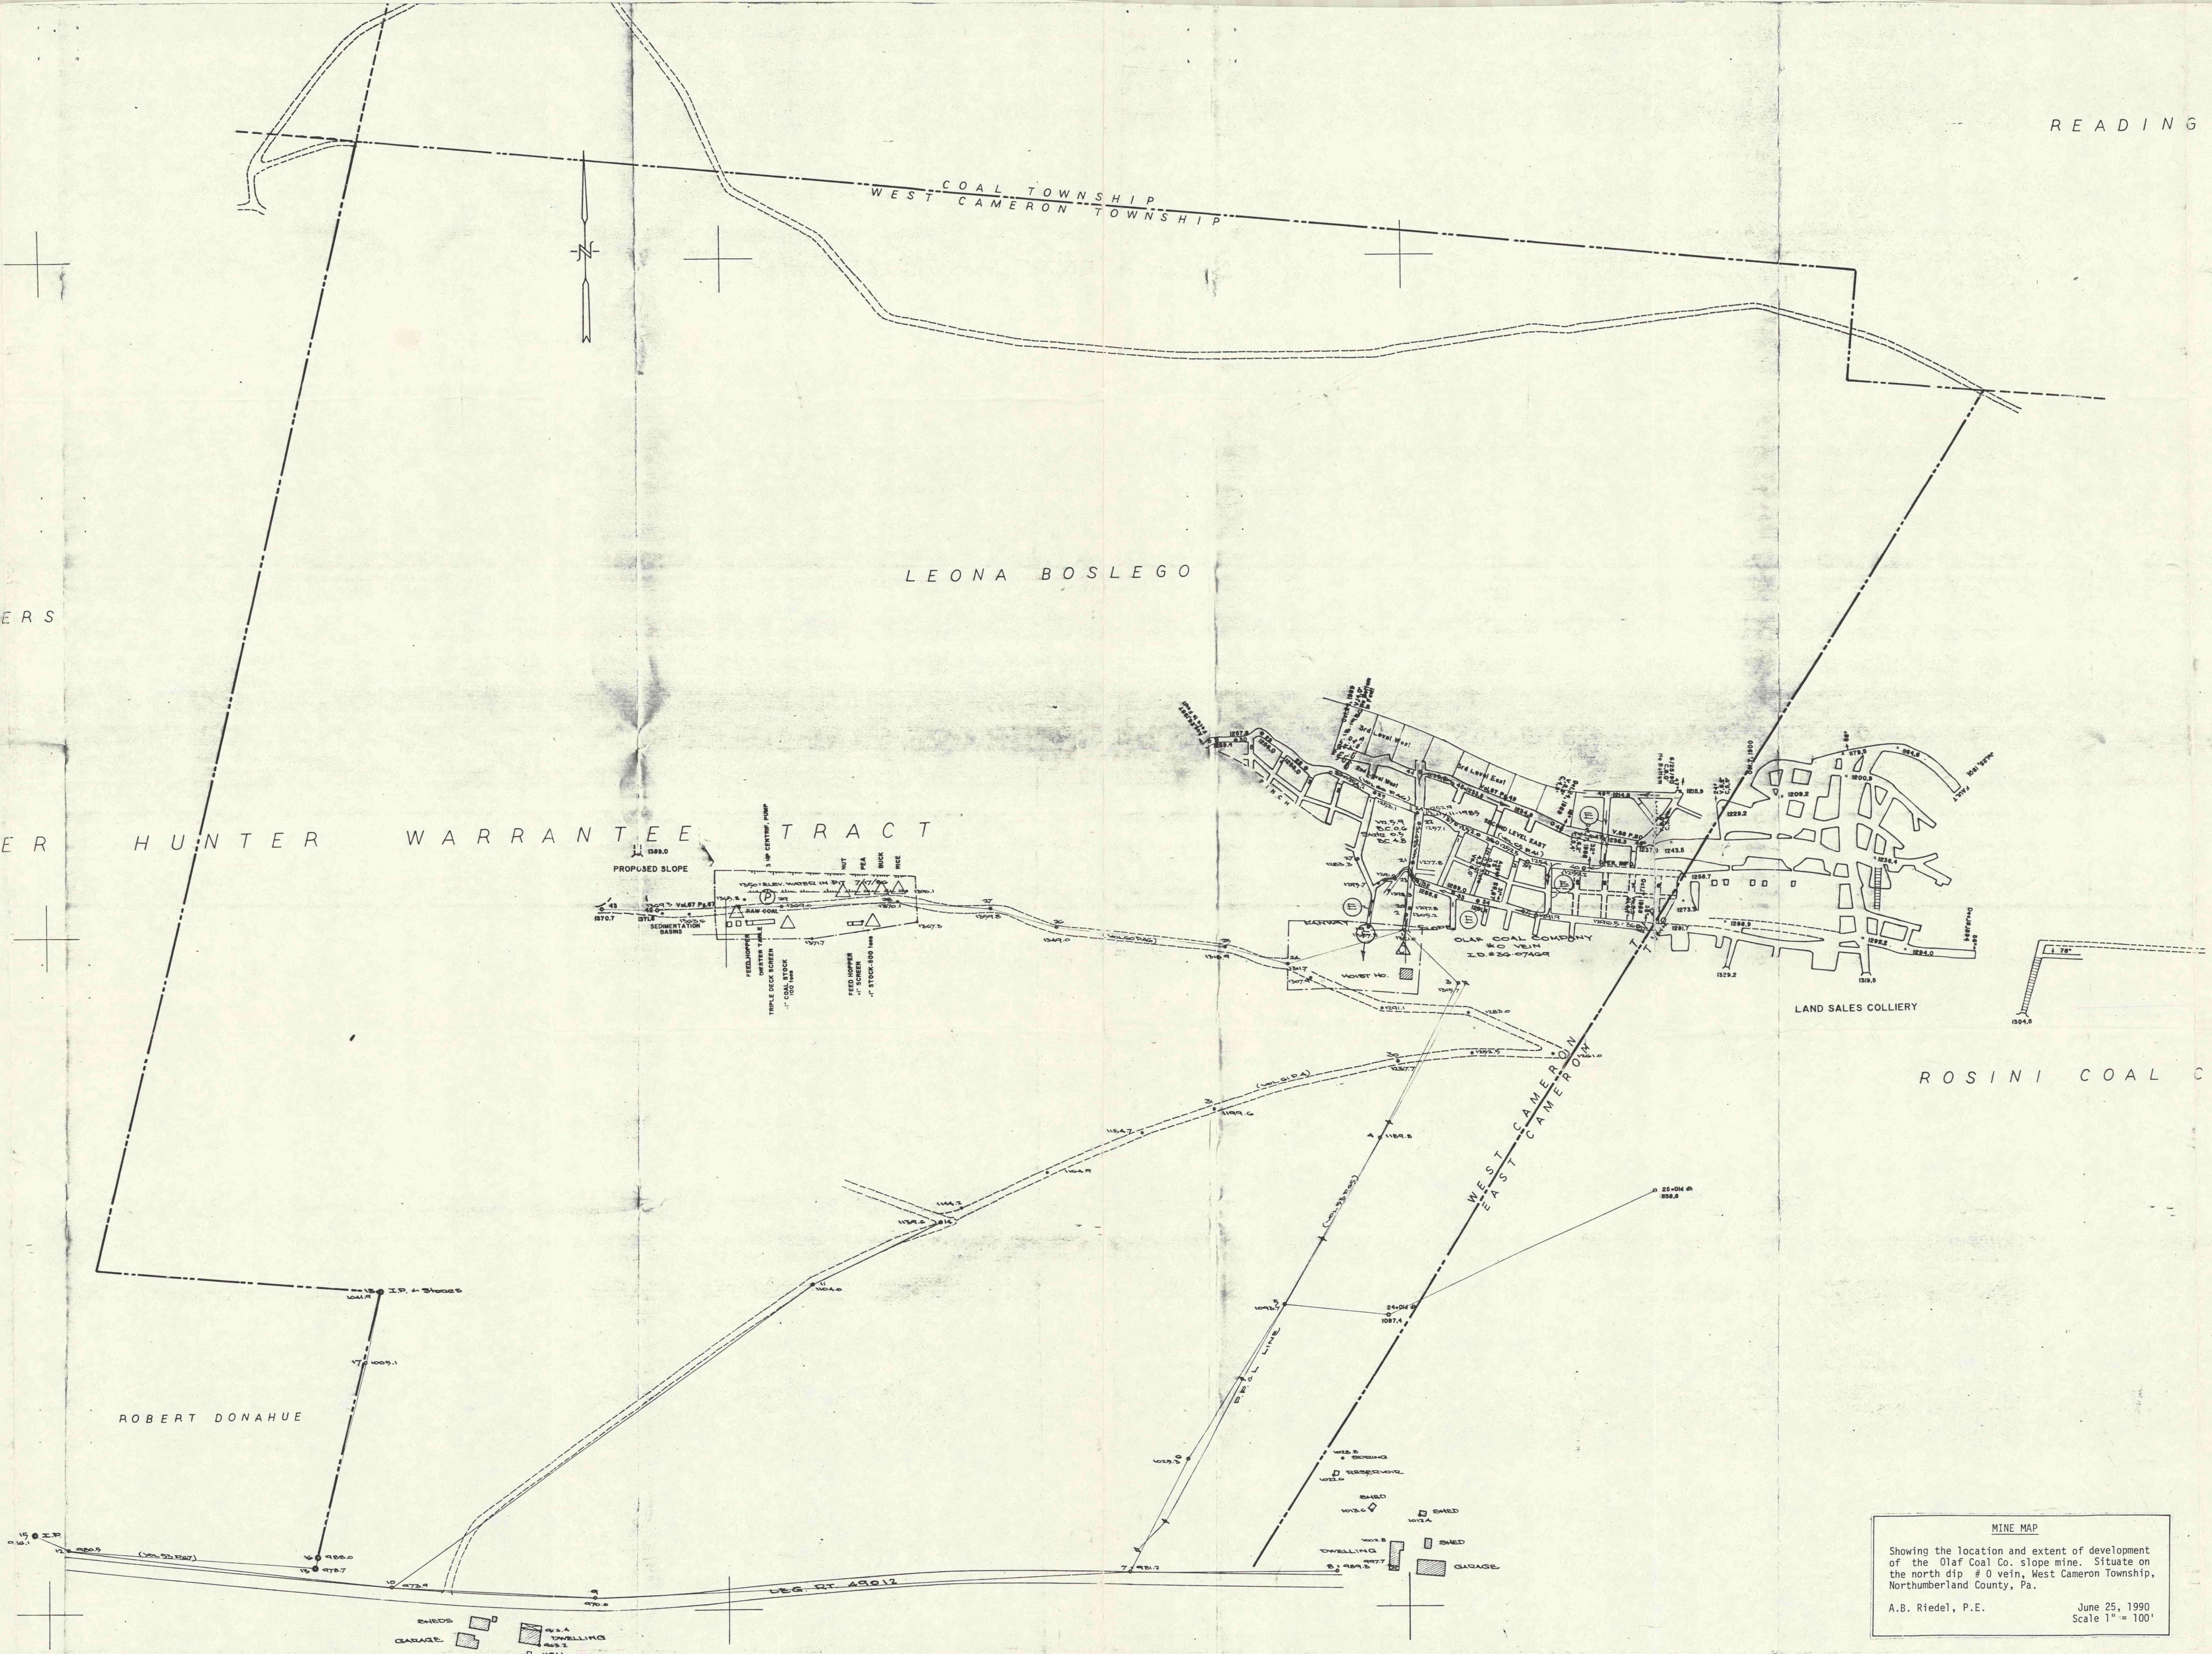

MINE MAP
Showing the location and extent of development
of the Olaf Coal Co. slope mine. Situate on
the north dip #0 vein, West Cameron Township,
Northumberland County, Pa.
A.B. Riedel, P.E. June 25, 1990
Scale 1" = 100'

VENTILATION SYMBOLS	
(F) = Main Fan	(B) = Air Bridge
(A) = Auxiliary Fan	(R) = Regulator
(I) = Air Flow - Intake	(M) = Man Door
(E) = Air Flow - Exhaust	(V) = Velocity, fpm
(+) = Permanent Stopping	(Q) = Quantity, cfm
(-) = Temporary Stopping	(WG) = Water Gauge

A.B. Riedel