


G M P L A N D & C O M P A N Y
S U R F & M I N E

A L E X S A U S N O R K
M A R Y S K A T C H E R
S U R F & M I N E

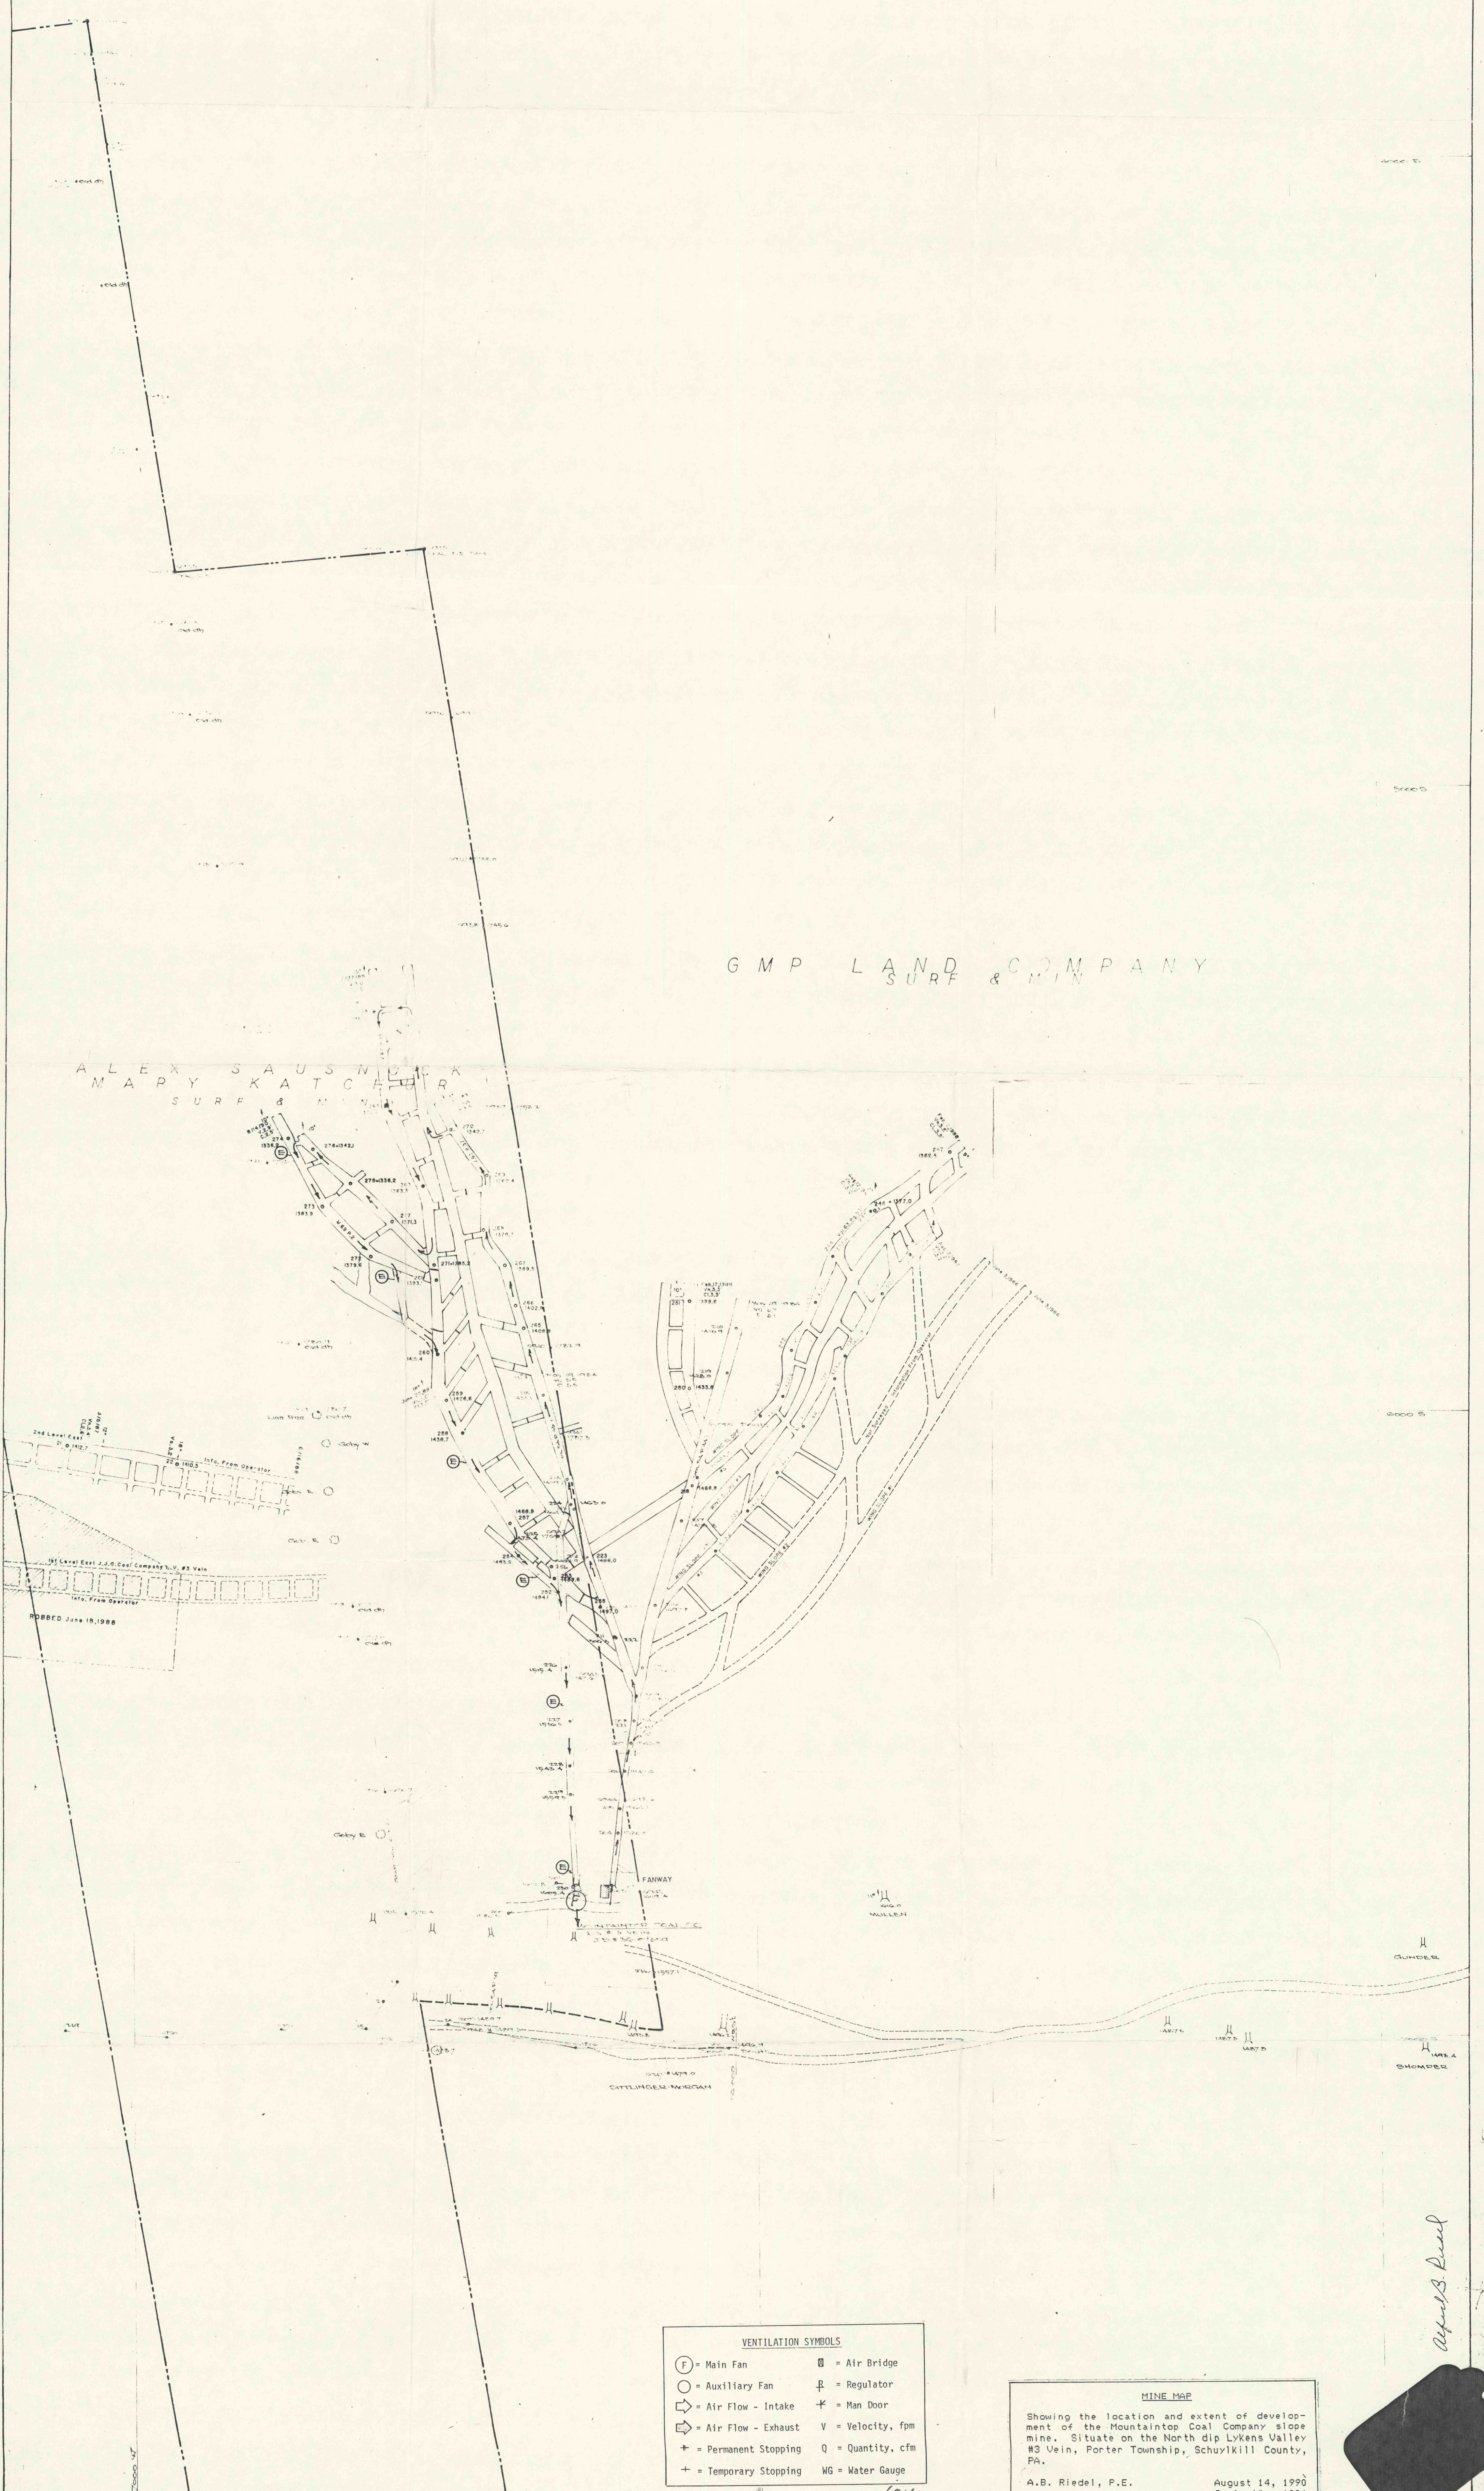

VENTILATION SYMBOLS			
⊙ = Main Fan	⊞ = Air Bridge		
⊙ = Auxiliary Fan	⊞ = Regulator		
⊞ = Air Flow - Intake	⊞ = Man Door		
⊞ = Air Flow - Exhaust	V = Velocity, fpm		
+ = Permanent Stopping	Q = Quantity, cfm		
+ = Temporary Stopping	WG = Water Gauge		

MINE MAP
Showing the location and extent of development of the Mountaintop Coal Company slope mine. Situate on the North dip Lykens Valley #3 Vein, Porter Township, Schuylkill County, PA.
A.B. Riedel, P.E. August 14, 1990
Scale 1" = 100'

August B. Riedel

1942