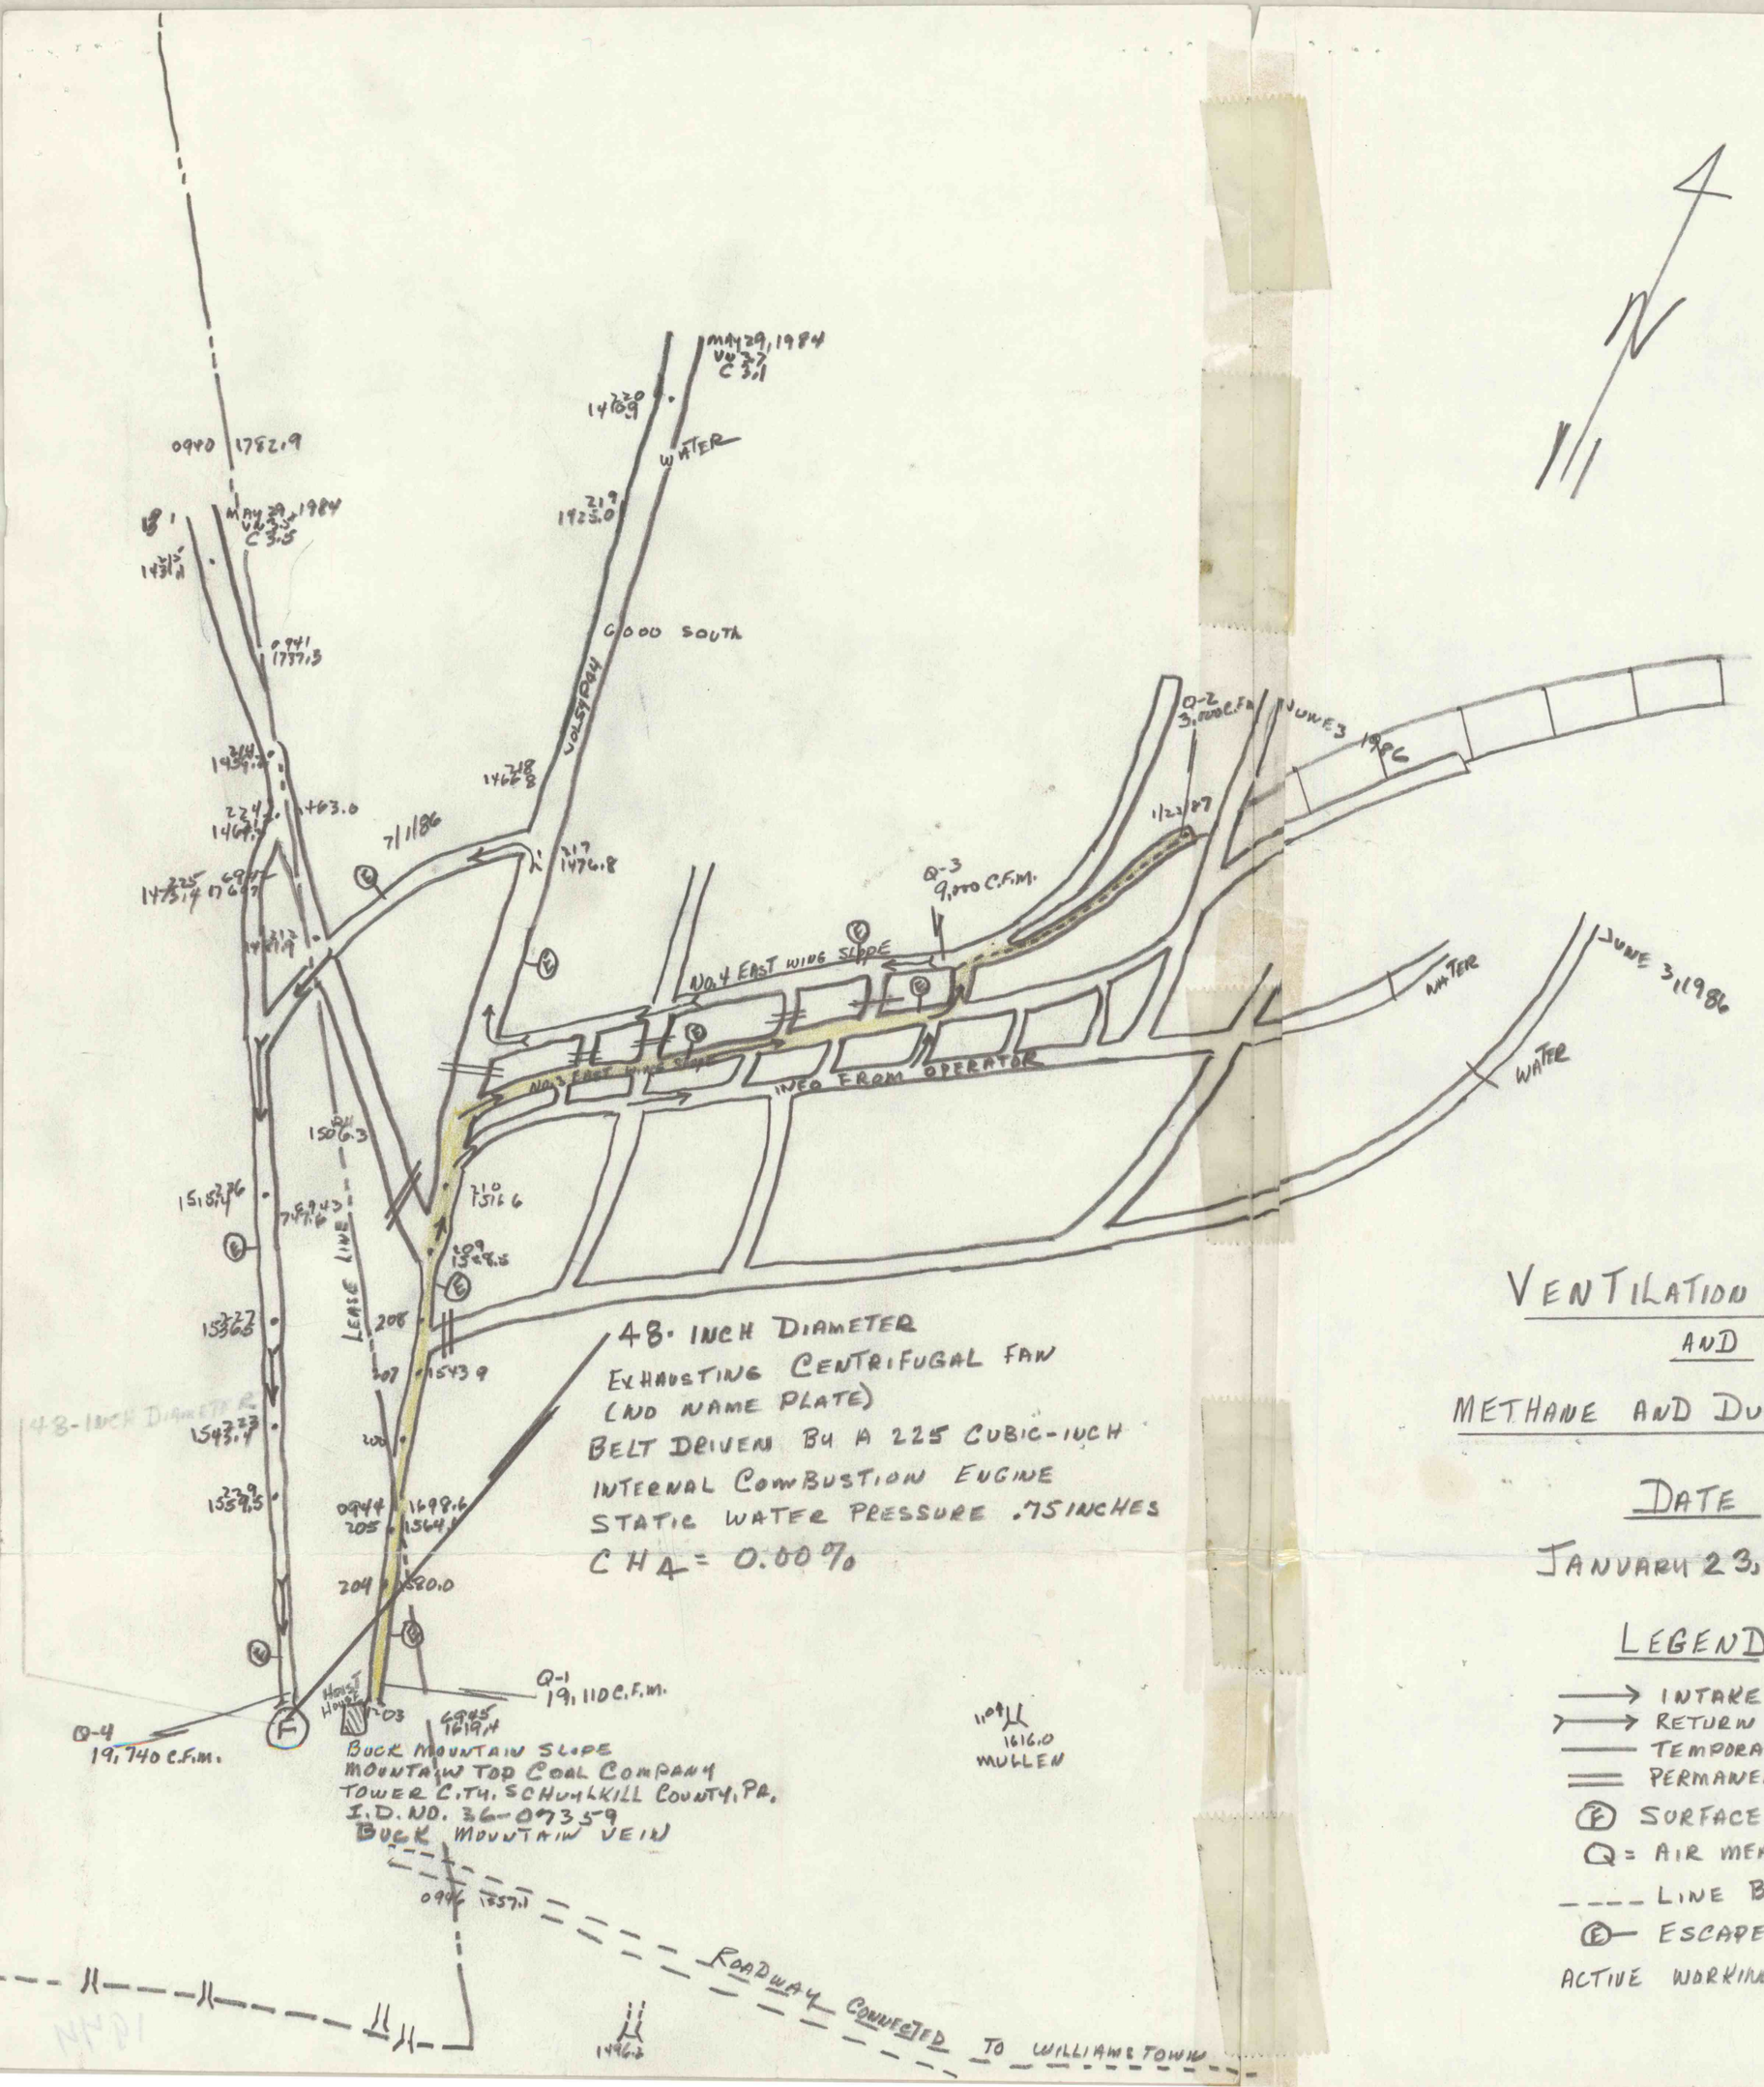

VENTILATION SYSTEM
AND
METHANE AND DUST CONTROL PLAN

DATE

JANUARY 23, 1987

LEGEND

- → INTAKE AIR
- → RETURN AIR
- —— TEMPORARY STOPPING
- ═══ PERMANENT STOPPING
- (F) SURFACE FAN
- Q = AIR MEASUREMENT LOCATION
- - - - LINE BRATTICE
- (E) ESCAPEWAY

ACTIVE WORKINGS DELINEATED IN YELLOW

DRAWING TAKEN FROM MINE MAP DATED 6/3/86

SEAL

Alan Bleidel