


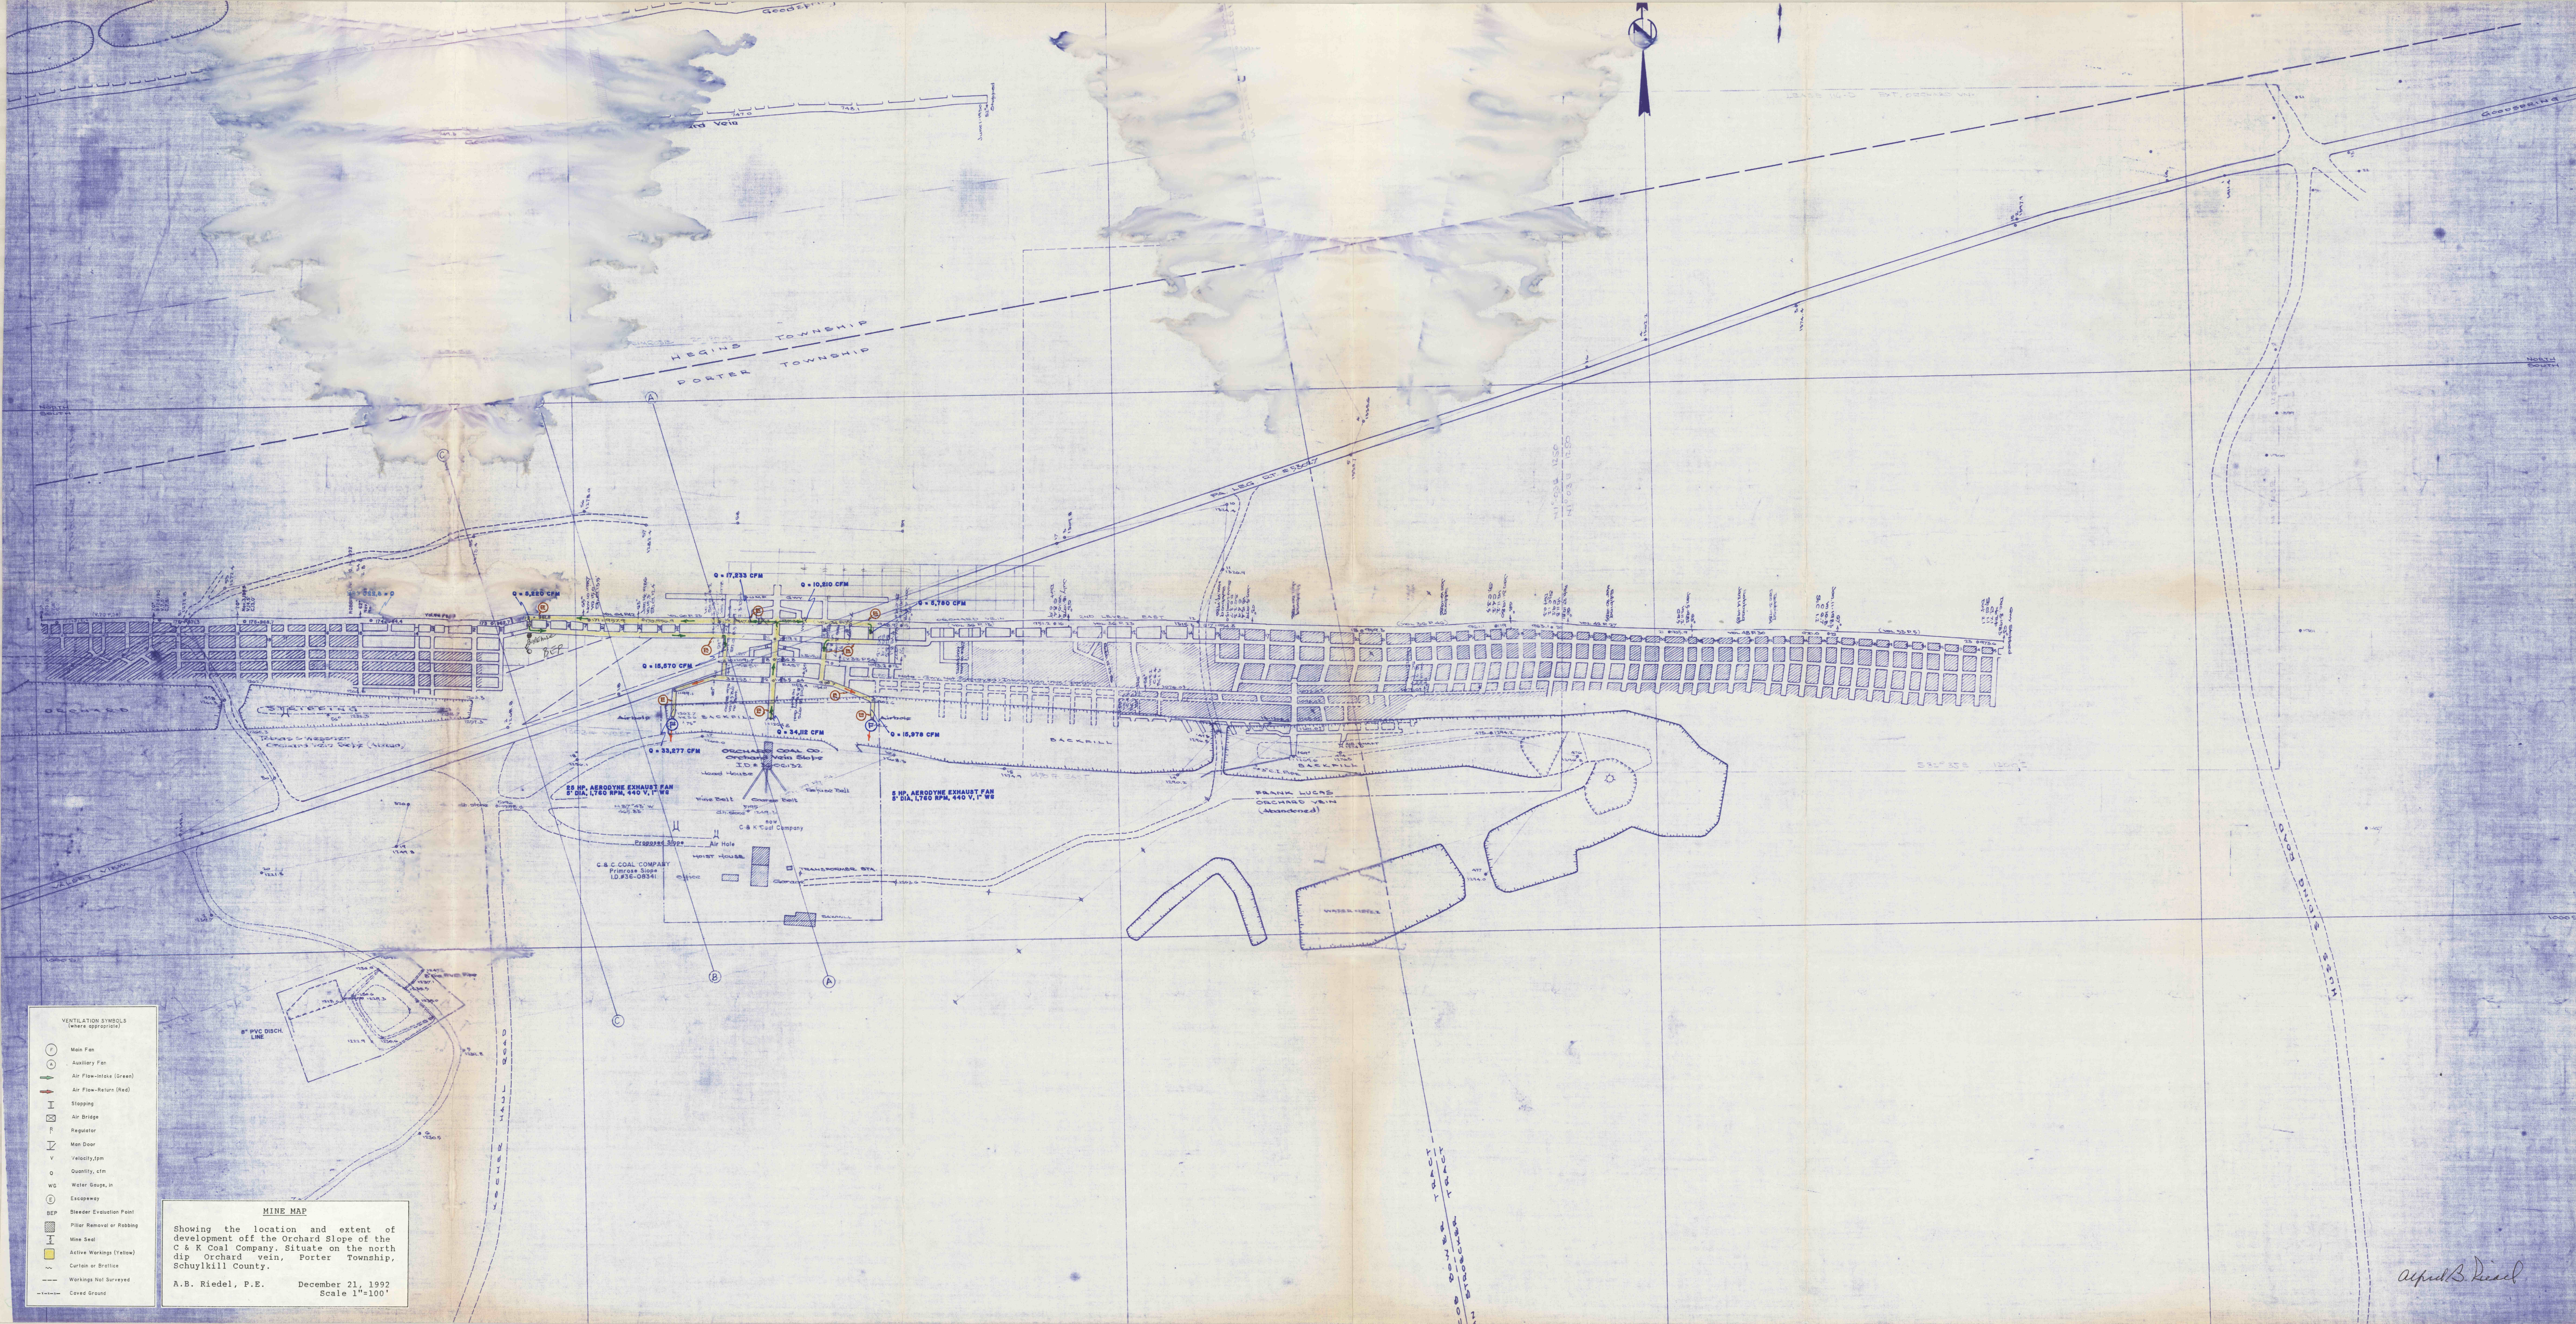

- VENTILATION SYMBOLS
(where appropriate)
- Main Fan
 - Auxiliary Fan
 - Air Flow-Intake (Green)
 - Air Flow-Return (Red)
 - Stopping
 - Air Bridge
 - Regulator
 - Man Door
 - Velocity, fpm
 - Quantity, cfm
 - WG Water Gauge, in
 - Escapeway
 - BEP Bleeder Evaluation Point
 - Pillar Removal or Robbing
 - Mine Seal
 - Active Workings (Yellow)
 - Curtain or Brattice
 - Workings Not Surveyed
 - Caved Ground

MINE MAP
Showing the location and extent of development off the Orchard Slope of the C & K Coal Company. Situate on the north dip Orchard vein, Porter Township, Schuylkill County.
A.B. Riedel, P.E. December 21, 1992
Scale 1"=100'

A. B. Riedel