


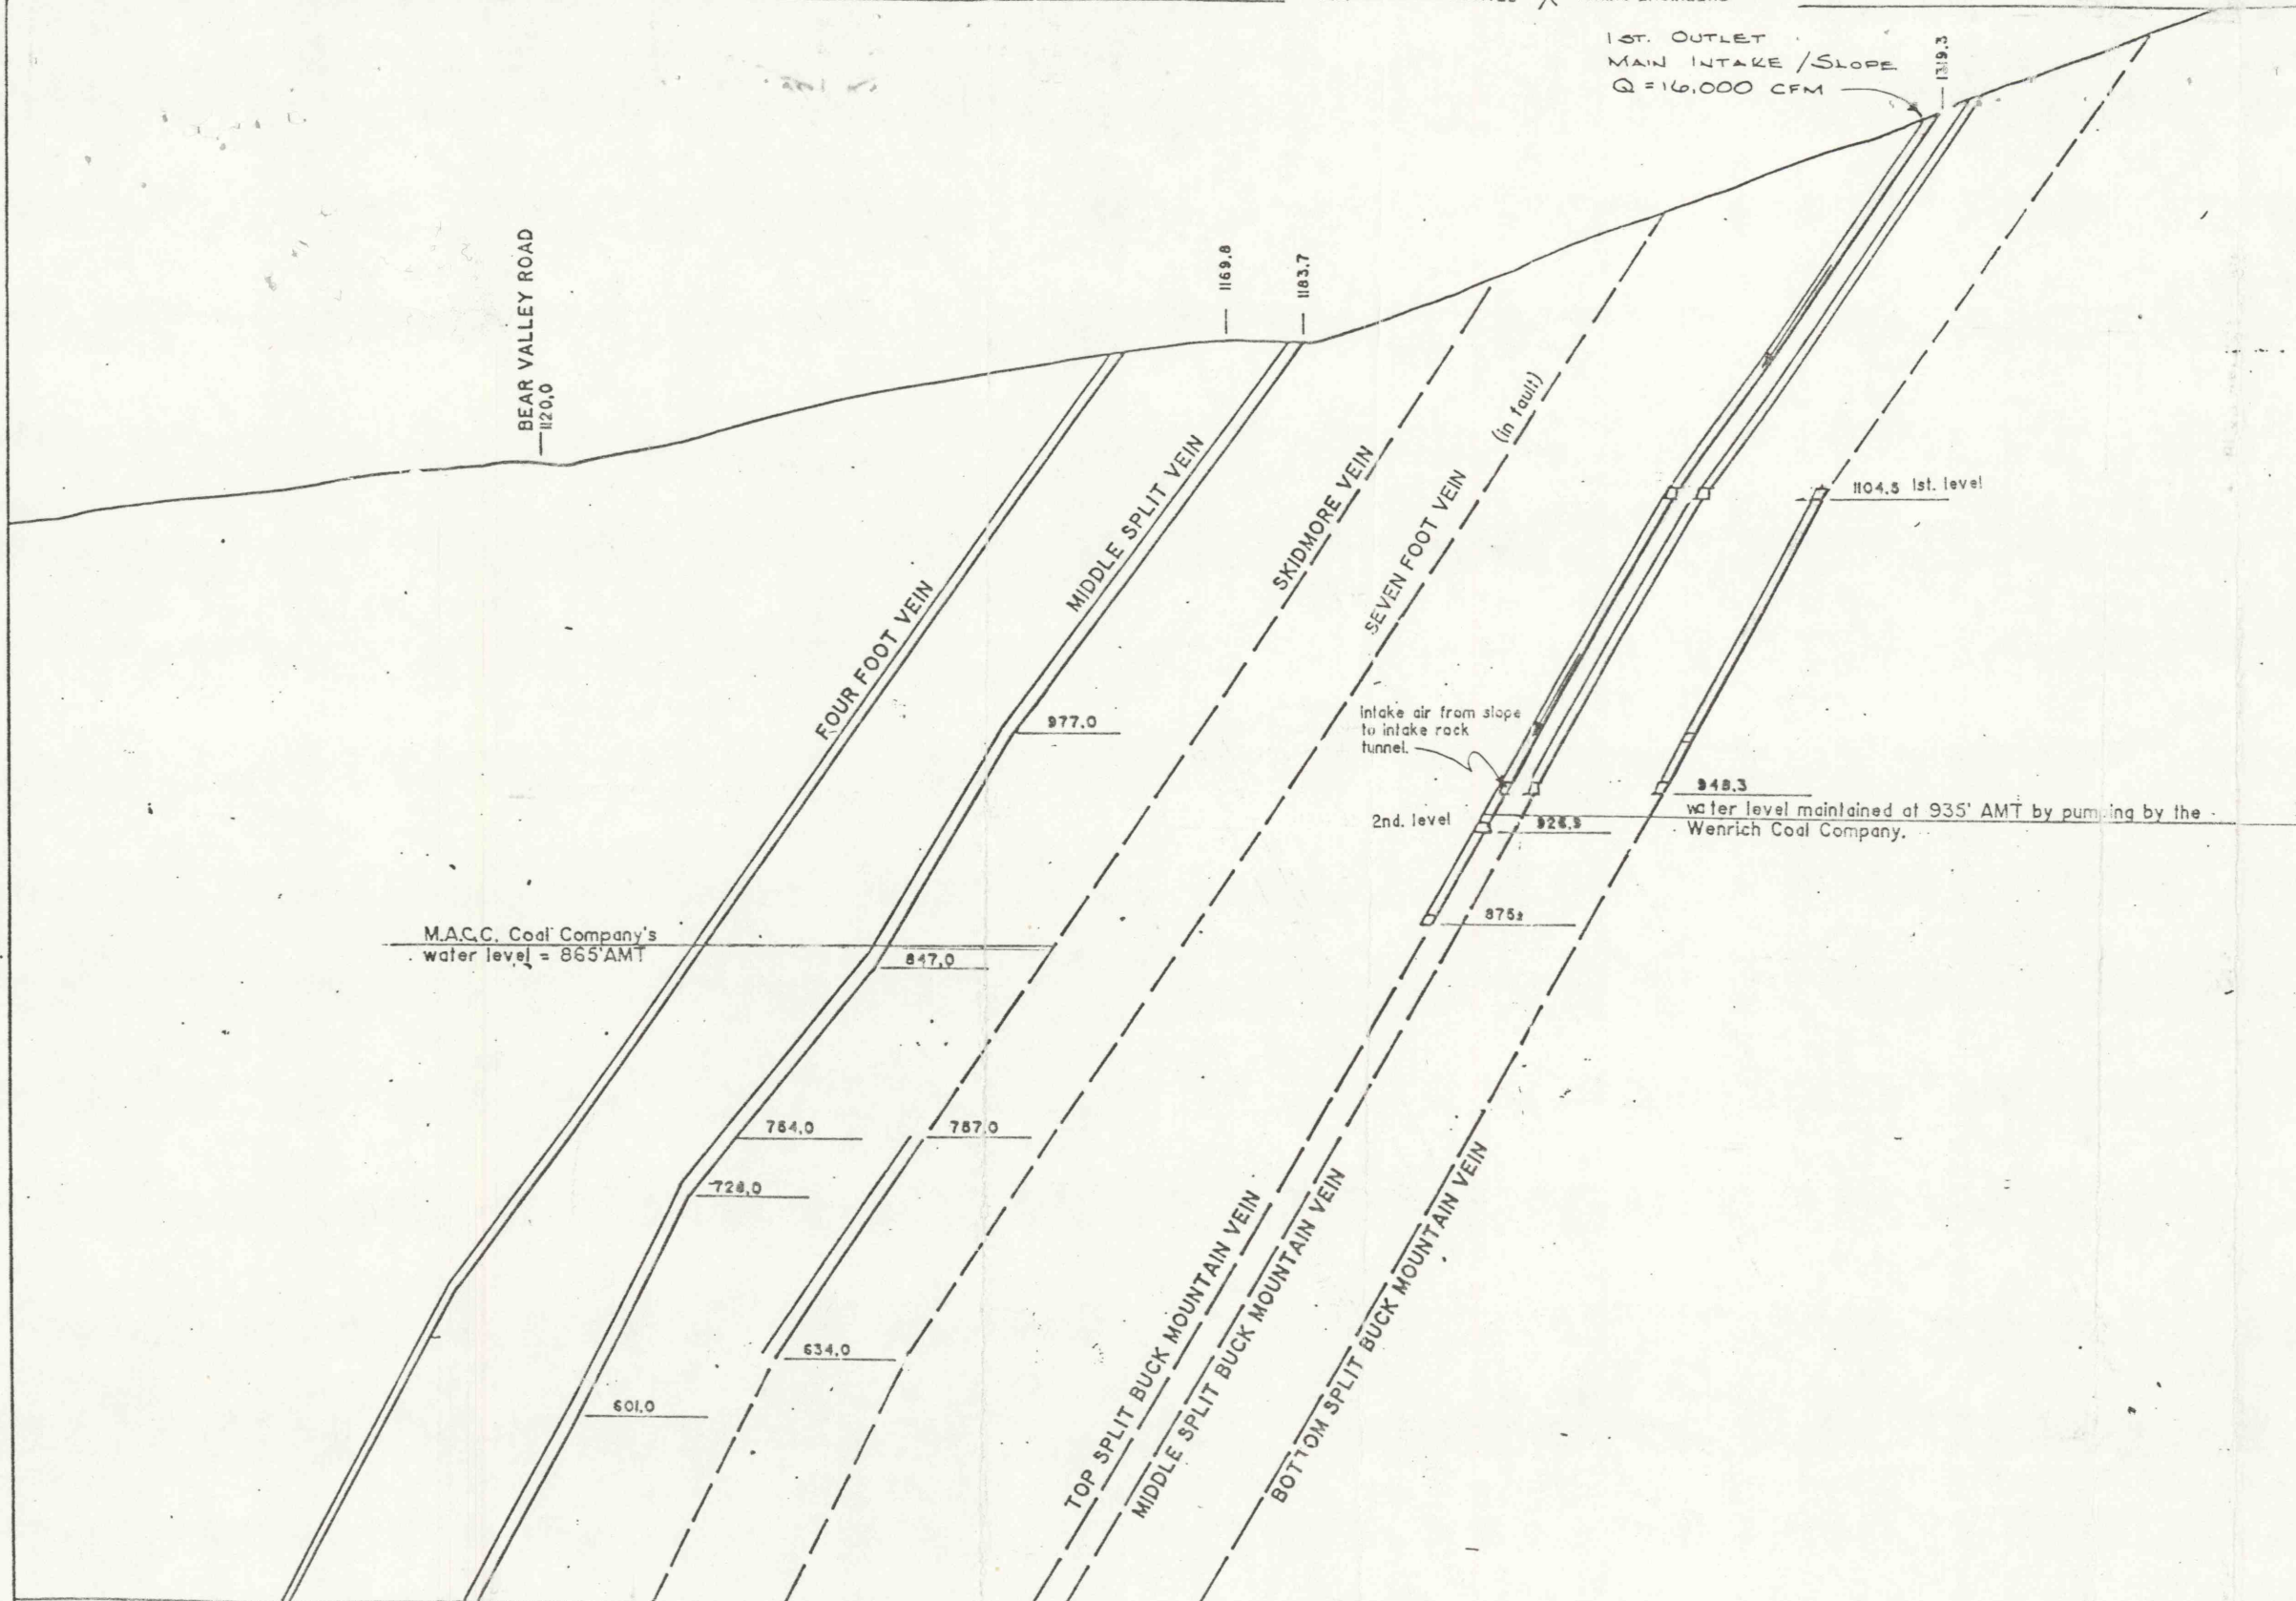

SECTION THRU WENRICK COAL COMPANY

DATUM 500' AMT - LOOKING WEST

Scale 1 inch = 100 feet


 Active workings
 Intake Air
 Exhaust Air

WENRICH COAL COMPANY
I.D.36-Q5717

Section B
(Through Slope)

David L. Williams