

36,000 WEST


35,000 WEST

34,000 WEST

33,000 WEST


COLLIERIES BY
MAY 28 9 1881
RECORDED

GEORGE DEWALD TRACT
DANIEL MESSERSMITH TRACT

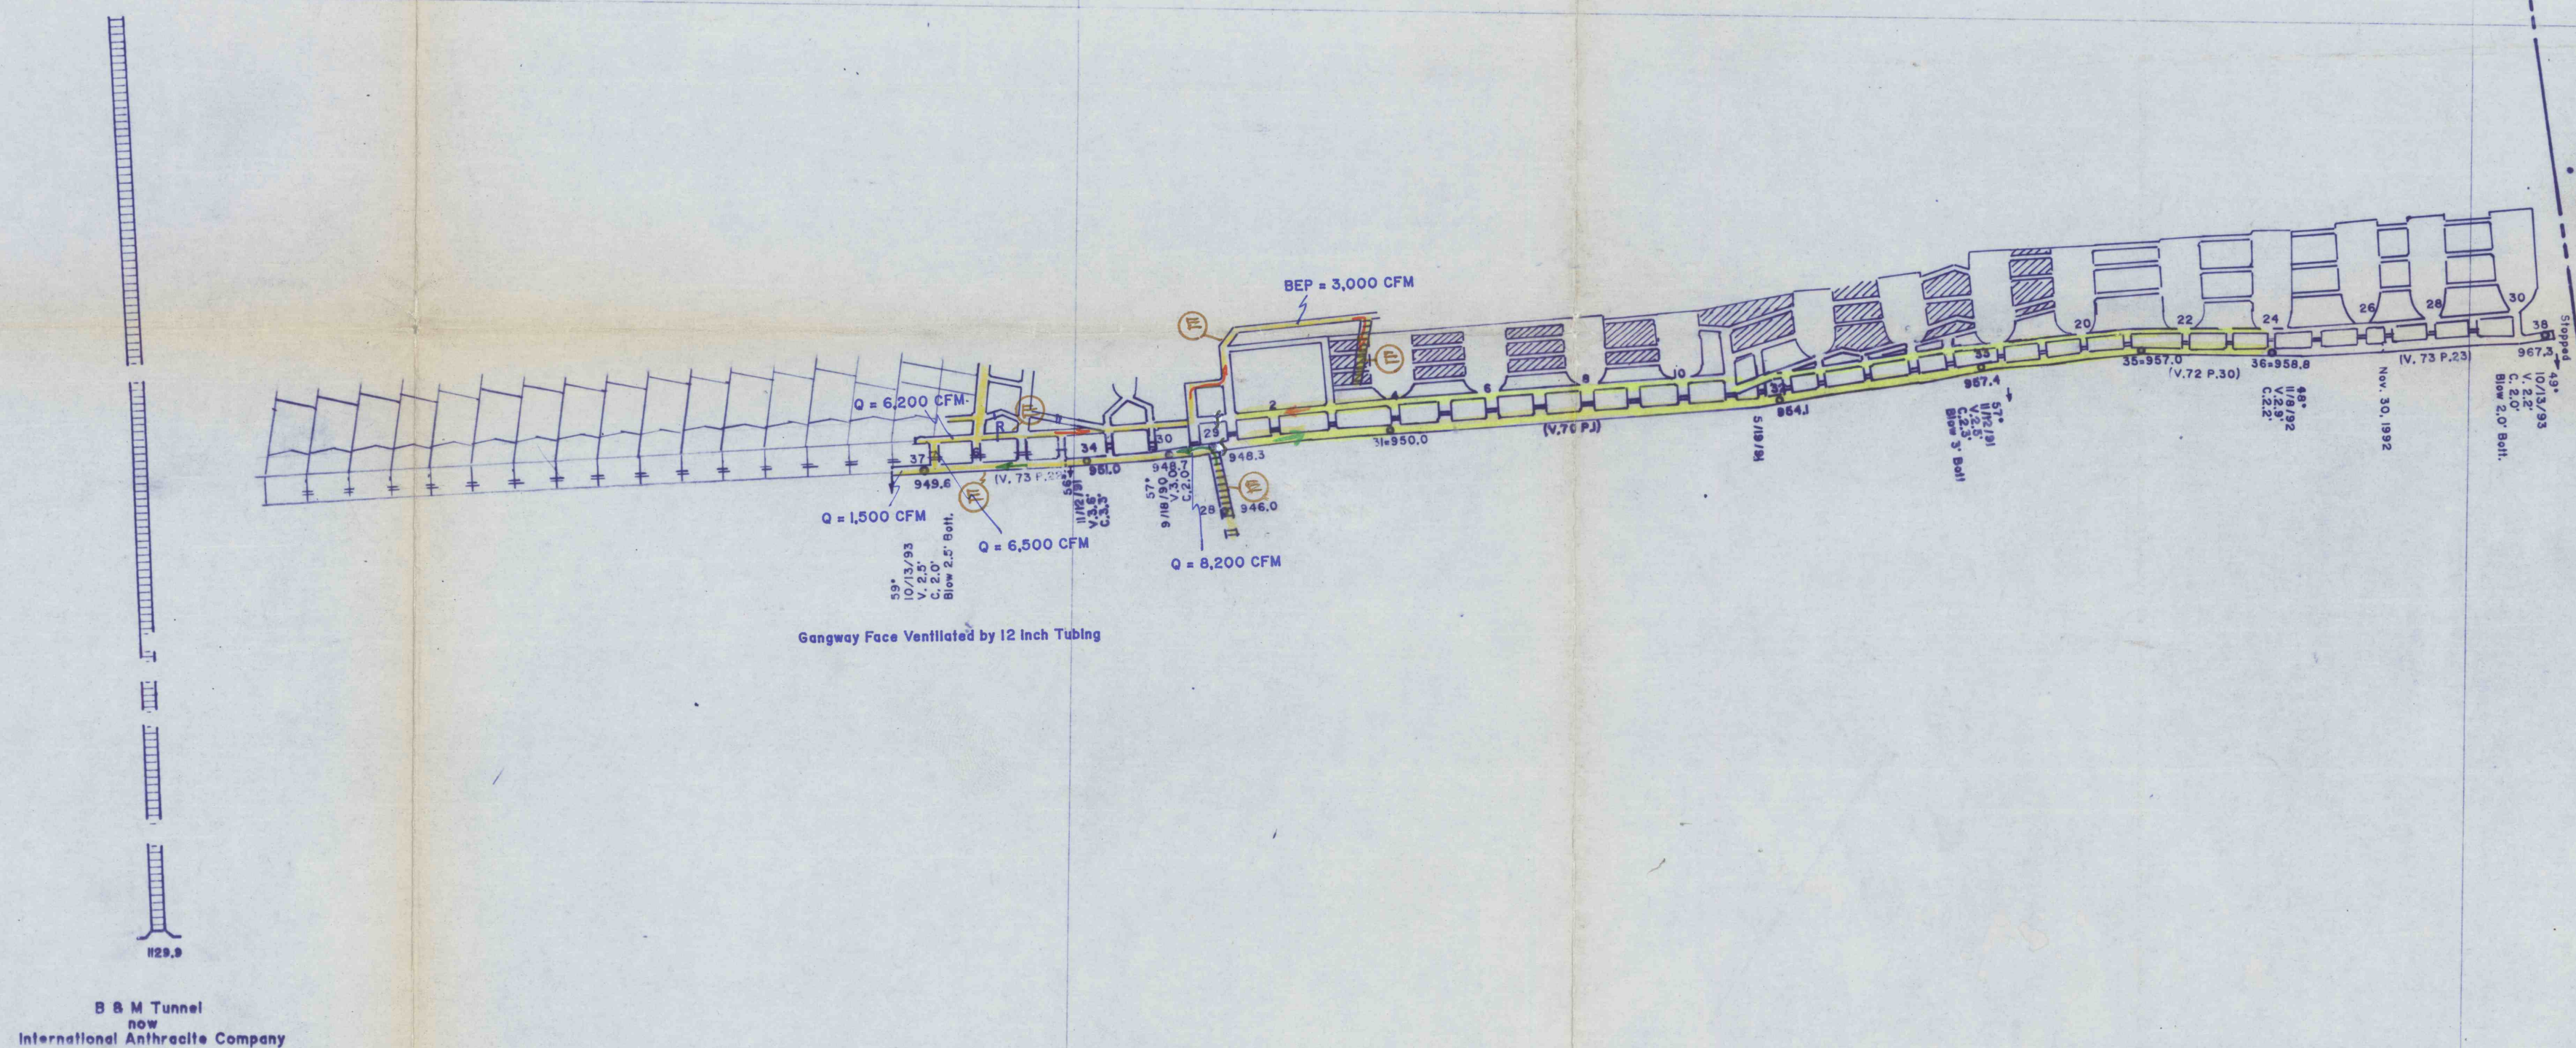

- VENTILATION SYMBOLS
(where appropriate)
- Main Fan
 - Auxiliary Fan
 - Air Flow-Intake (Green)
 - Air Flow-Return (Red)
 - Stopping
 - Air Bridge
 - Regulator
 - Man Door
 - Velocity, fpm
 - Quantity, cfm
 - Water Gauge, in
 - Escapeway
 - Blower Evaluation Point
 - Pillar Removal or Robbing
 - Mine Seal
 - Active Workings (Yellow)
 - Curtain or Brattice
 - Workings Not Surveyed
 - Caved Ground

MINE MAP
of the
WENRICH COAL COMPANY WORKINGS
situate on the
South Dip Bottom Buck Mountain Vein
Hegins Township, Schuylkill County
11112-0110

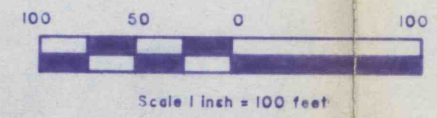

Survey & Map Posted Oct. 13, 1993
UPDATED BY TEMPORARY NOTATION 3-28-94

alfred B. Reed

1956

33,000 WEST