


26,000 WEST

25,000 WEST


24,000 WEST

23,000 WEST

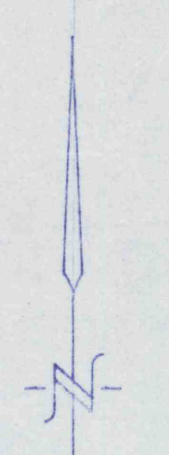


10-11-1951

000 0 030
00 3 11 21 10

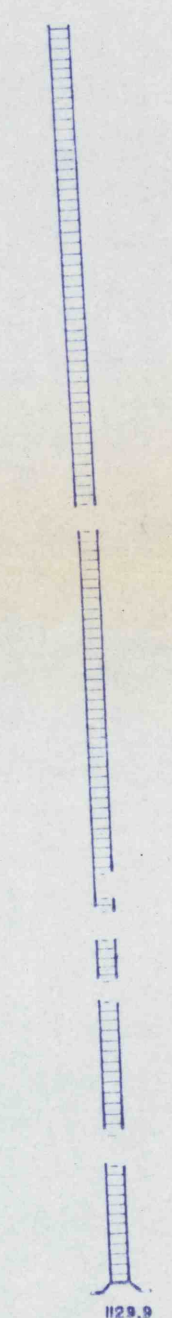

B & M Tunnel
now
International Anthracite Company

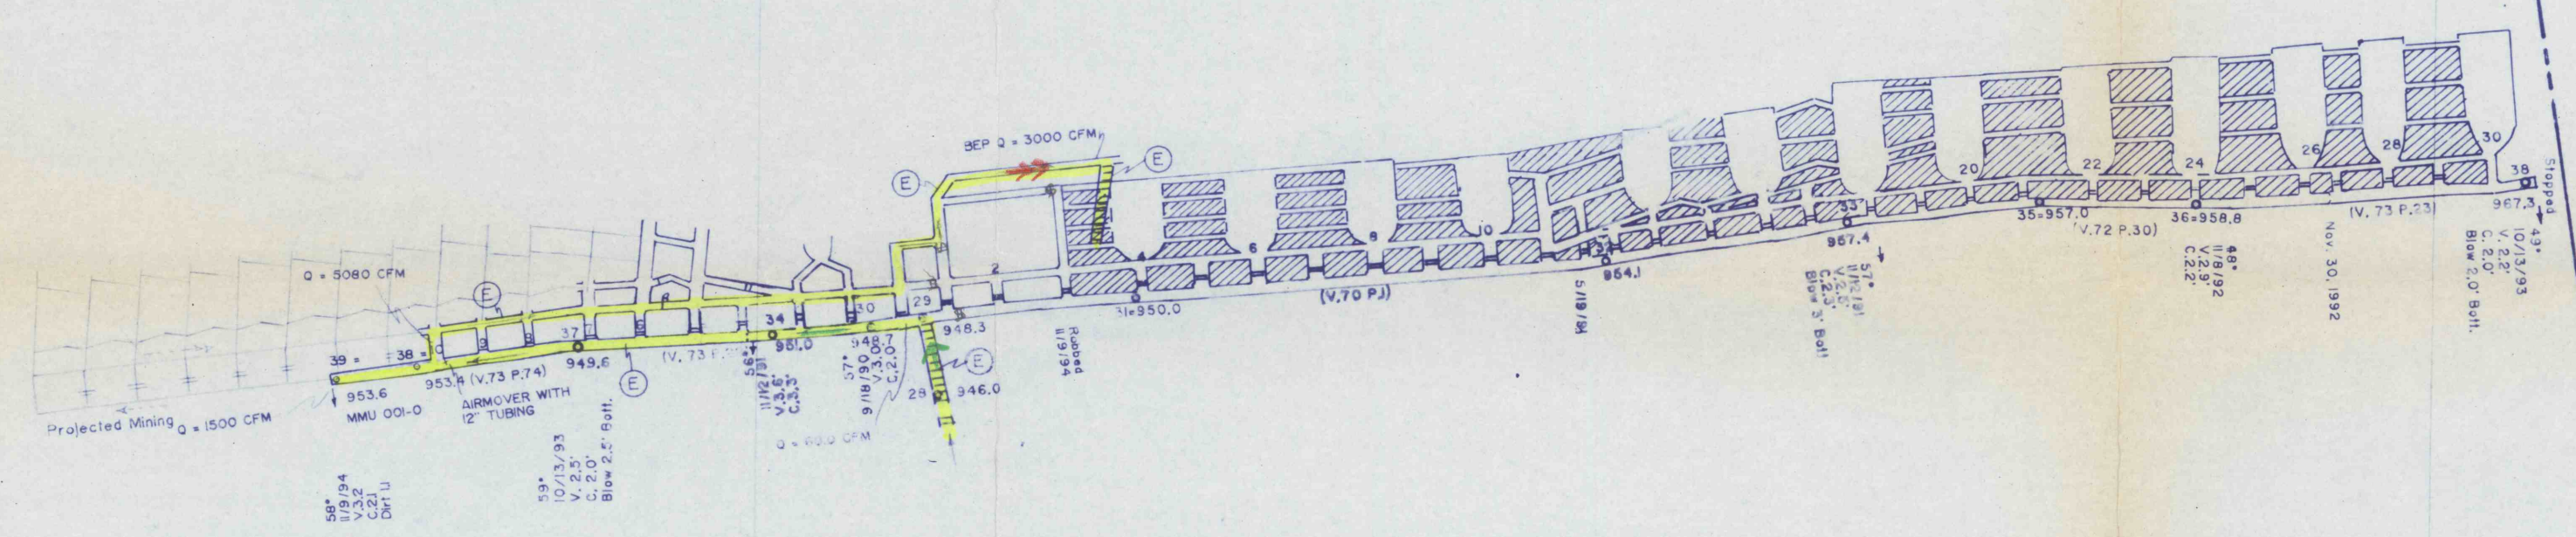

Hegins Township Route #607

Pennsylvania Power & Light Company

Kohlers Gap

- VENTILATION SYMBOLS
(where appropriate)
- ⊙ Main Fan
 - ⊙ Auxiliary Fan
 - ← Air Flow-Intake
 - Air Flow-Return
 - ⊞ Stopping
 - ⊞ Air Bridge
 - ⊞ Regulator
 - ⊞ Man Door
 - ⊞ Velocity, fpm
 - ⊞ Quantity, cfm
 - ⊞ Water Gauge, in
 - ⊞ Escapeway
 - ⊞ Bleeder Evaluation Point
 - ⊞ Pillar Removal or Rabbog
 - ⊞ Mine Seal
 - ⊞ Active Workings (Yellow)
 - ⊞ Curtain or Bolster
 - ⊞ Workings Not Surveyed
 - ⊞ Cured Ground

MINE MAP
of the
WENRICH COAL COMPANY WORKINGS
situated on the
South Dip Bottom Buck Mountain Vein
Hegins Township, Schuylkill County
ID.#36-05717
Scale 1 inch = 100 feet
Survey & Map Posted Nov. 9, 1954

MINE OPERATOR'S CERTIFICATION


I depose and say that the mine ventilation information shown on this map meets the requirements of 30 CFR Part 75.372 and was prepared by me or under my direction for which I accept full responsibility.

David E. Wenrich
Mine Foreman

SURVEYOR'S CERTIFICATION

I hereby certify that to the best of my knowledge that the areas that I have surveyed are true and correct as to the requirements of 30 CFR Part 75.203. All other information shown has been derived from the best available information but can not be field checked. Therefore, surveyor makes no certification to their accuracy.

David L. Williams
Surveyor

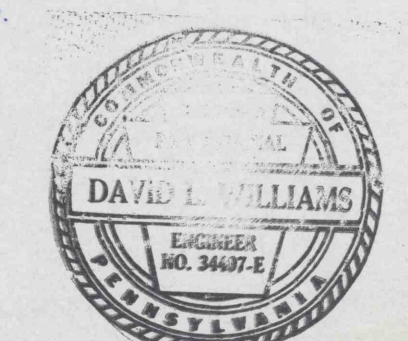

1957

26,000 WEST

25,000 WEST

24,000 WEST

23,000 WEST

1000 SOUTH