



48,000 WEST

53,000 WEST


54,000 WEST

55,000 WEST


0-NORTH  
C-SOUTH

0-NORTH  
C-SOUTH

B & M Tunnel  
owned by  
International Anthracite Company

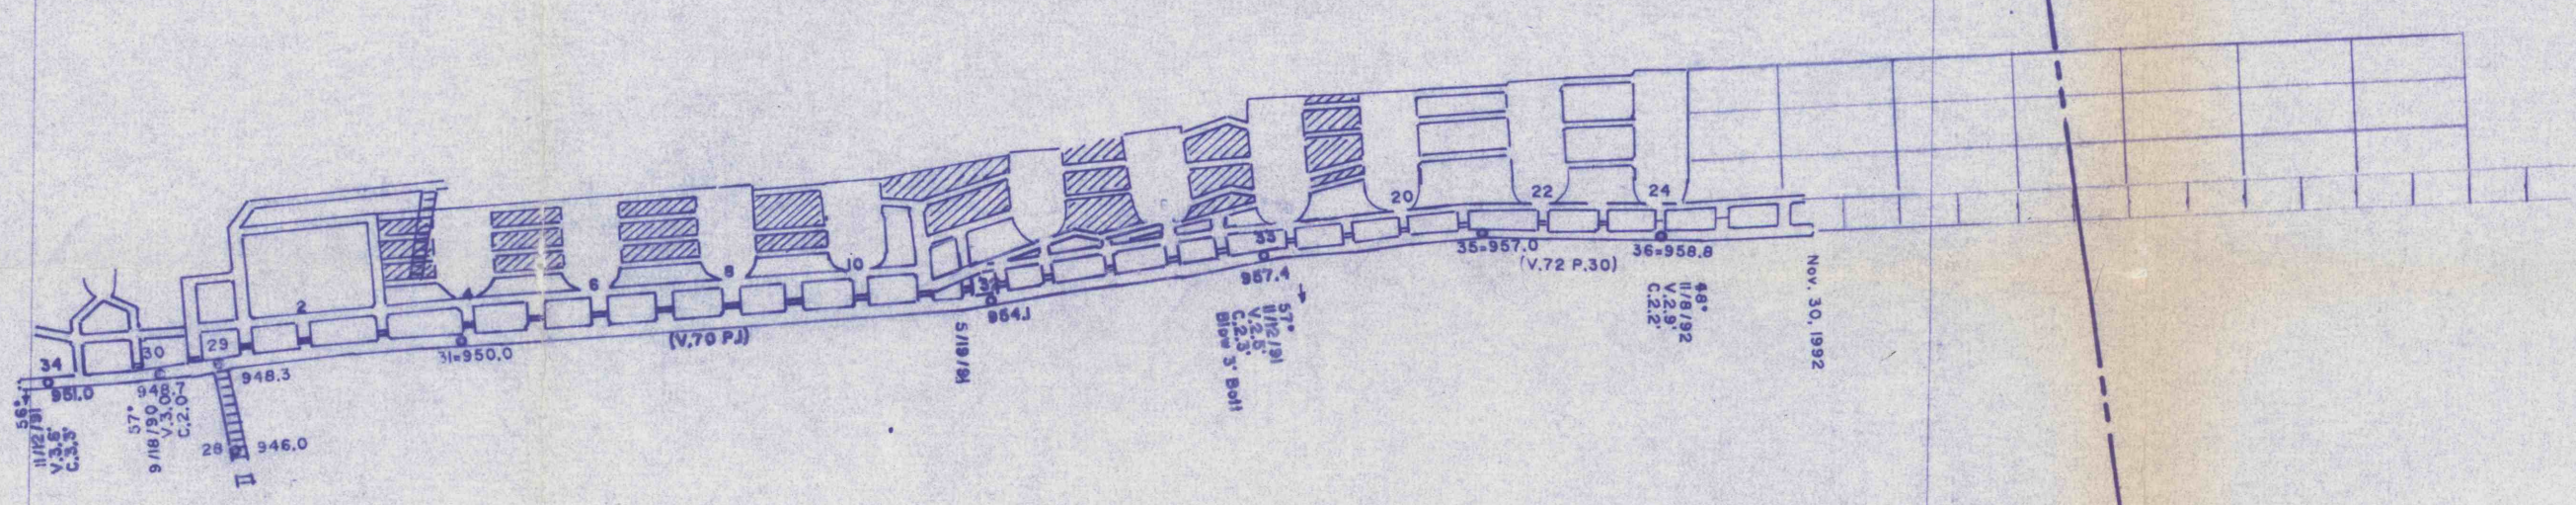

MINE MAP  
of the  
WENRICH COAL COMPANY WORKINGS  
situate on the  
South Dip Bottom Buck Mountain Vein  
Hegins Township, Schuylkill County

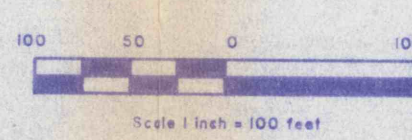

46,000 WEST

53,000 WEST

54,000 WEST

55,000 WEST

0-NORTH  
C-SOUTH

*Alfred B. Riesel*