


18,000 WEST

33,000 WEST

34,000 WEST

35,000 WEST

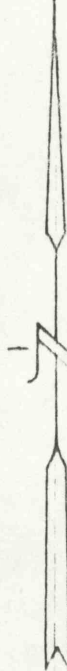

GEORGE DEWALD TRACT
DANIEL MESSERSMITH TRACT



Ventilation
MINE MAP
of the
WENRICH COAL COMPANY WORKINGS
situate on the
South Dip Bottom Buck Mountain Vein
Hedges Township, Schuylkill County
LD#36-05717
Scale 1 inch = 100 feet
MINE SURVEY POSTING NOV. 12, 1991

- VENTILATION SYMBOLS**
- (F) = Main Fan
 - (A) = Auxiliary Fan
 - = Air Flow - Intake
 - = Air Flow - Exhaust
 - = Permanent Stopping
 - - - = Temporary Stopping
 - ⊠ = Air Bridge
 - R = Regulator
 - V = Man Door
 - V = Velocity, fpm
 - Q = Quantity, cfm
 - WG = Water Gauge
 - (E) = Escapeway
 - BEP = Bleeder Evaluation Point