


56,000 WEST

55,000 WEST

54,000 WEST



53,000 WEST

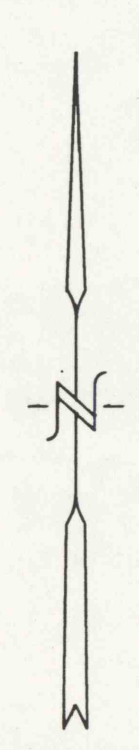


0-NORTH
0-SOUTH

0-NORTH
0-SOUTH

B & M Tunnel
now
International Anthracite Company

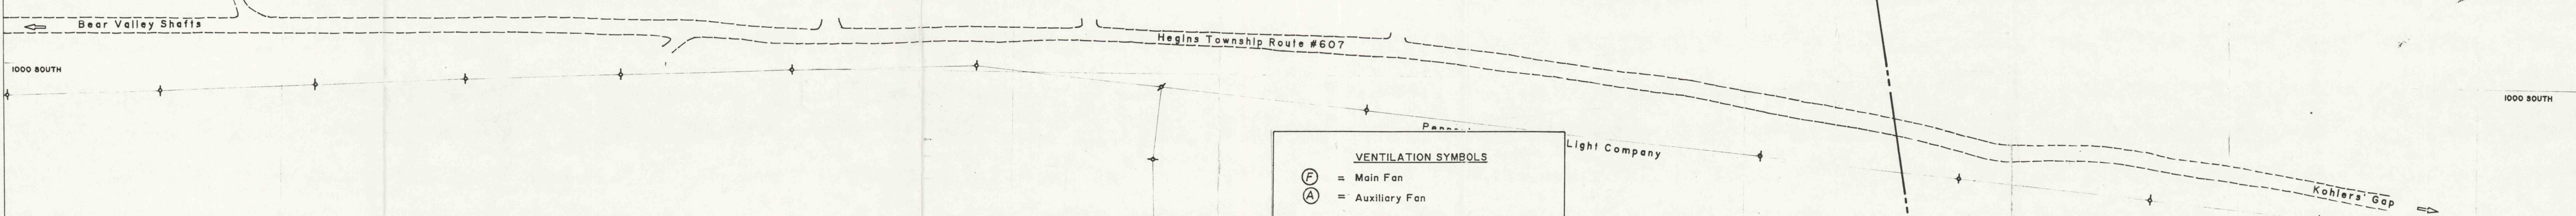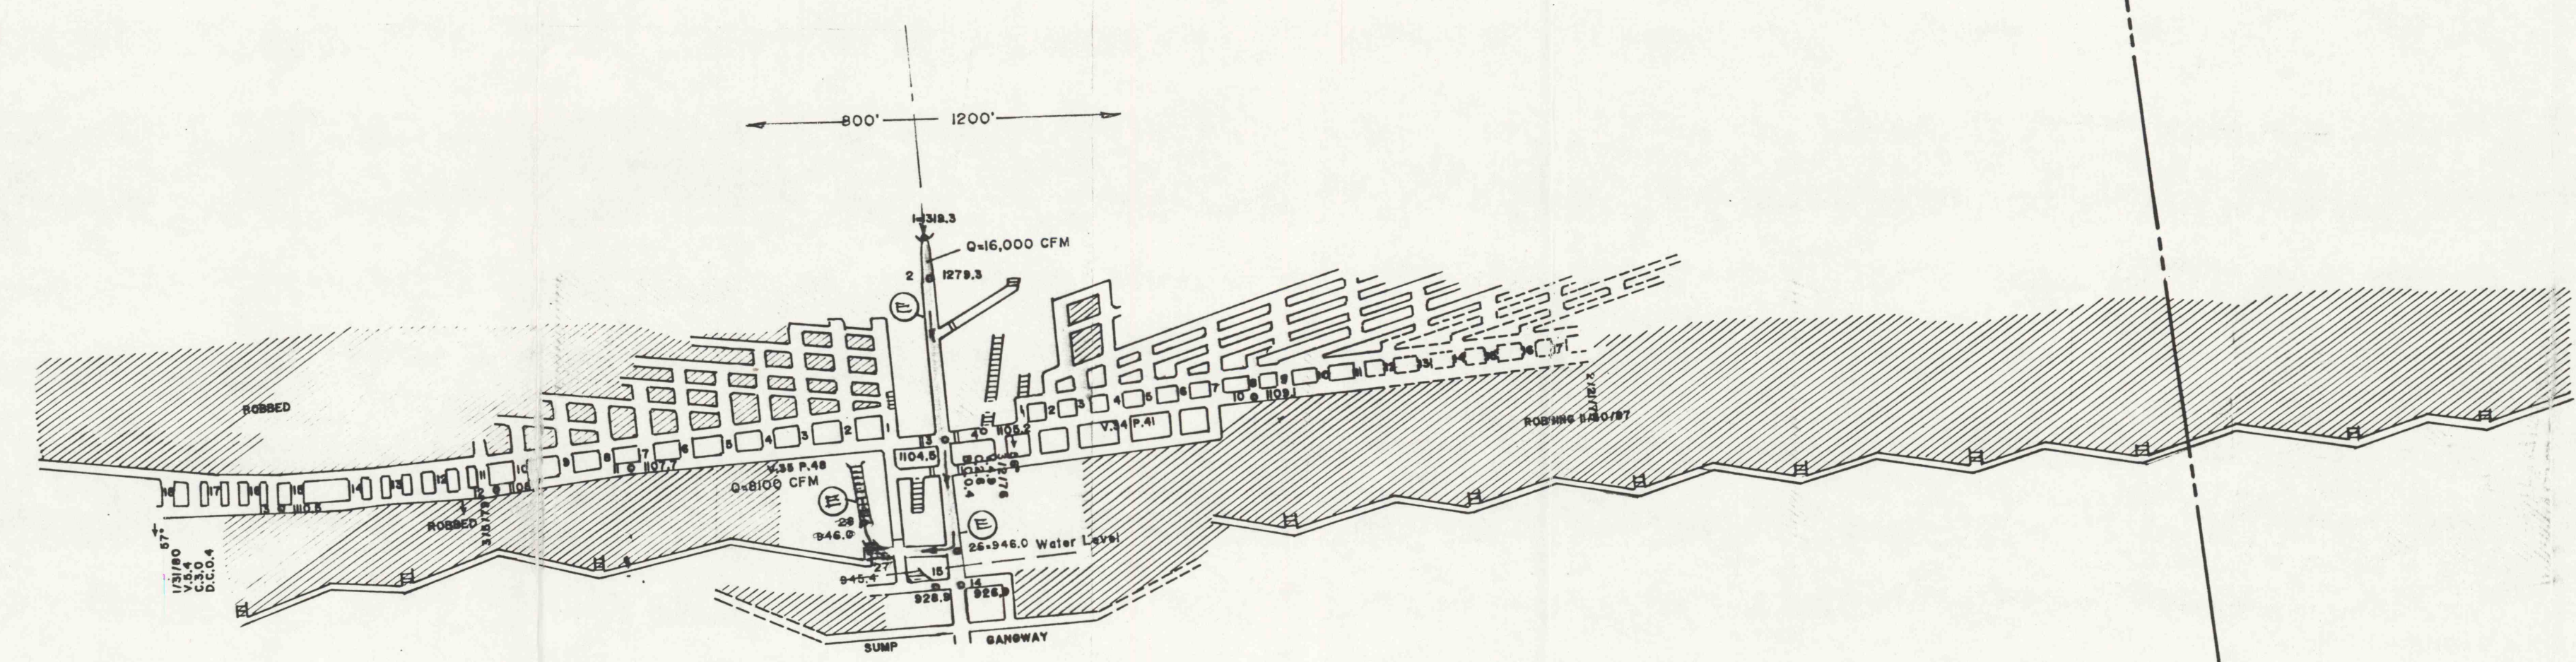

WENRICH COAL COMPANY
Hegins Township, Schuylkill County
Buck Mountain Vein, Top Split Workings
I.D.#36-05717

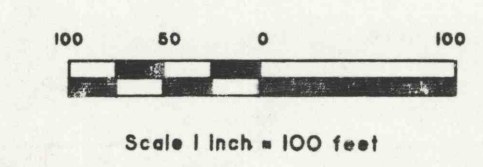

VENTILATION SYMBOLS	
(F)	= Main Fan
(A)	= Auxiliary Fan
→	= Air Flow - Intake
⇝	= Air Flow - Exhaust
— — —	= Permanent Stopping
— — —	= Temporary Stopping
⊠	= Air Bridge
R	= Regulator
∇	= Man Door
V	= Velocity, fpm
Q	= Quantity, cfm
WG	= Water Gauge
E	= Escapeway
BEP	= Bleeder Evaluation Point

RECEIVED
March 27/91
3/1/91 dh

ap-AB

1961
(b)