


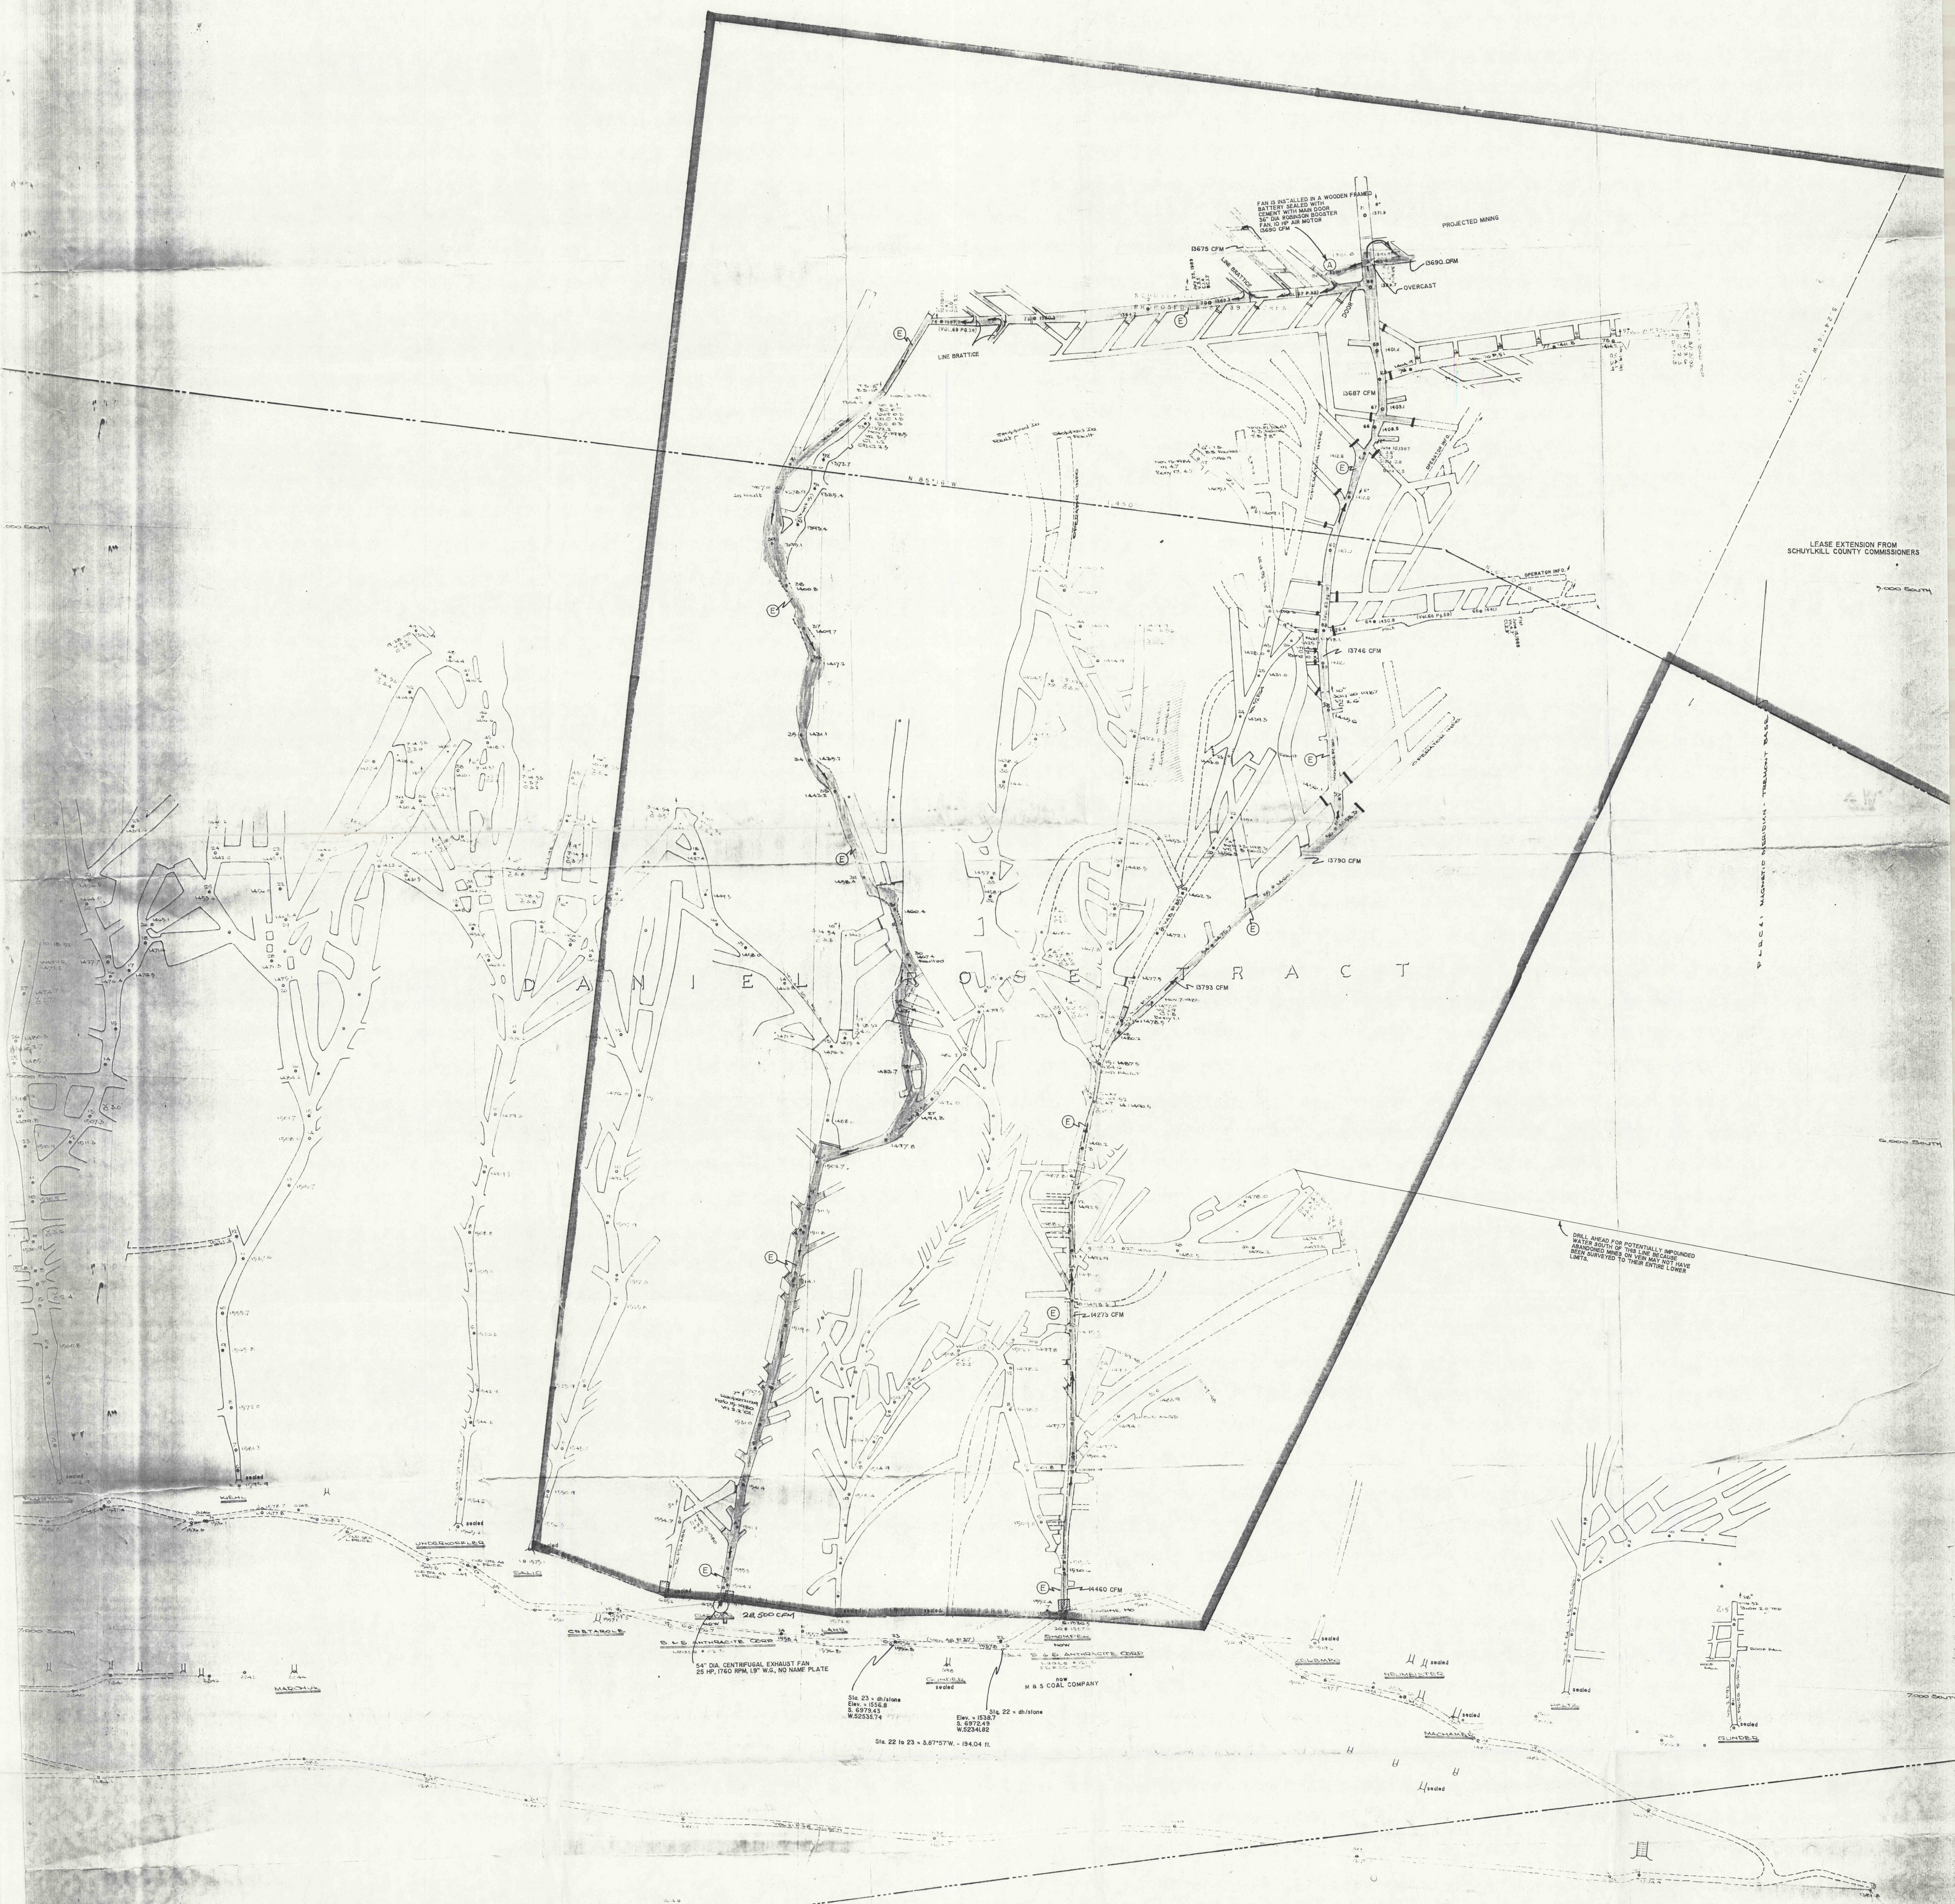

MINE MAP
for the
M & S Coal Company
situate
L.V.#3 Vein, Porter Twp., Schuylkill County
Scale 1 inch = 100 feet

LEGEND

- active areas (all areas not shaded yellow are abandoned)
- intake air
- exhaust air
- auxiliary fan
- fan
- escapeway
- temporary seal with wood
- permanent seal with wood
- permanent seal with wood and cement
- overcast
- collapsed area/
air tight

NOTES:

1. All mine water drains through the abandoned mine workings of the Lykens Valley Nos. 4 & 5 Veins from the West Brookside Colliery to the Valley View Colliery Mine Pool via the Valley View Tunnel at an elevation of 905 A.M.T. The only exception to this drainage scheme may be small pockets of water which could exist to the east of the M & S Coal Company's mine in abandoned Lykens Valley No. 3 Vein workings which are shown on the map but may not have been surveyed to their full developmental extent.
2. There are no other coal veins worked above the M & S Coal Company's mine according to available mine maps.
3. All areas which are not shaded in yellow are abandon and are isolated from the active workings by seals as identified on the map.

MINE MAP

Showing the location and extent of development of the M & S Coal Company Buck Mountain Slope/35-05619. Situated on the north dip Lykens Valley #3 Vein Porter Township, Schuylkill County, Pa.
David L. Williams, P.E. March 13, 1951
Revised 9/24/52
Scale: 1" = 100'