
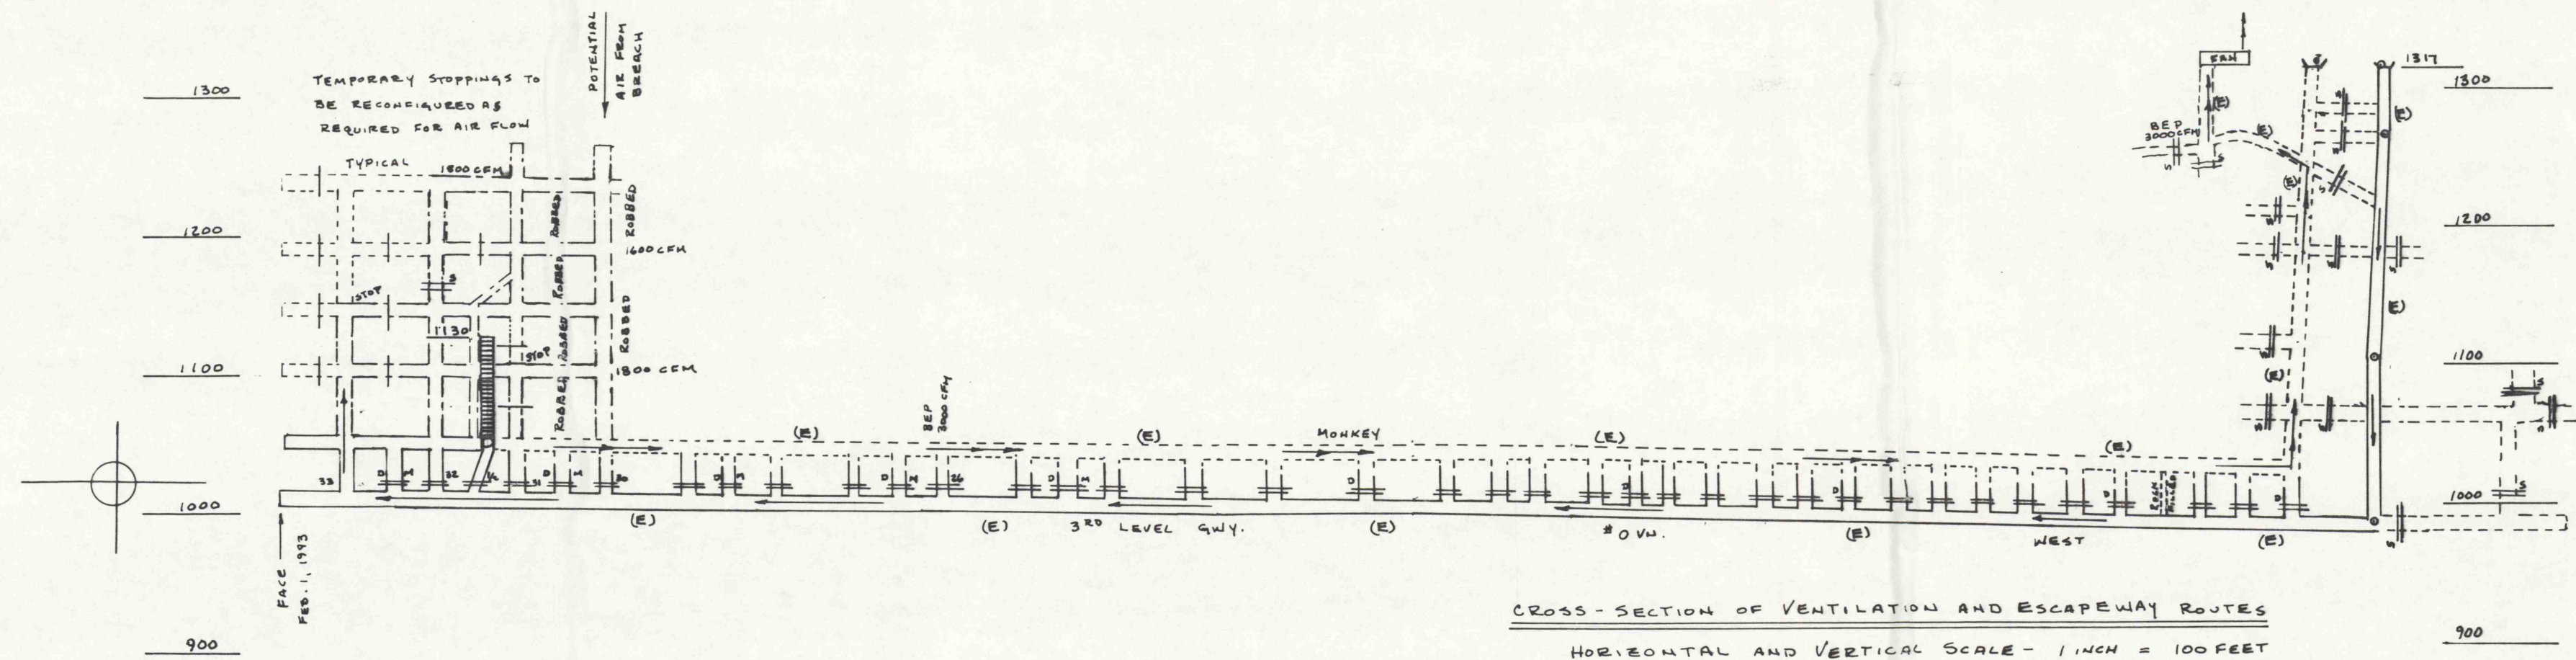


SUBSURFACE HORIZONTAL & VERTICAL CONTROL DATA			
STA.	NORTH	EAST	ELEV. DESCRIPTION
71	5450.12	5993.69	1266.4 SPAD IN CEILING
72	5566.37	5999.46	1106.0 SPAD IN FLOOR
73	5496.14	6003.97	987.7 SPAD IN CEILING
74	5490.71	5745.51	991.7 SPAD IN CEILING
75	5481.79	5557.62	993.9 SPAD IN CEILING
76	5479.98	5415.76	997.9 SPAD IN CEILING
77	5481.73	5300.28	1003.1 SPAD IN CEILING
78	5474.18	5155.35	1003.1 SPAD IN CEILING
79	5471.90	4947.64	1006.2 SPAD IN CEILING
80	5455.59	4566.13	1011.8 SPAD IN CEILING
82	5479.28	4559.54	1051.3 SPAD IN CEILING

ONE YEAR PROJECTION:

- * GANGWAY AND MONKEY HAVE BEEN STOPPED.
- * NO FUTURE EXTENSION OF MINING OF THIS GANGWAY WILL OCCURE.
- * THE MINE WILL BEGIN TO ROB TOWARD THE SLOPE.

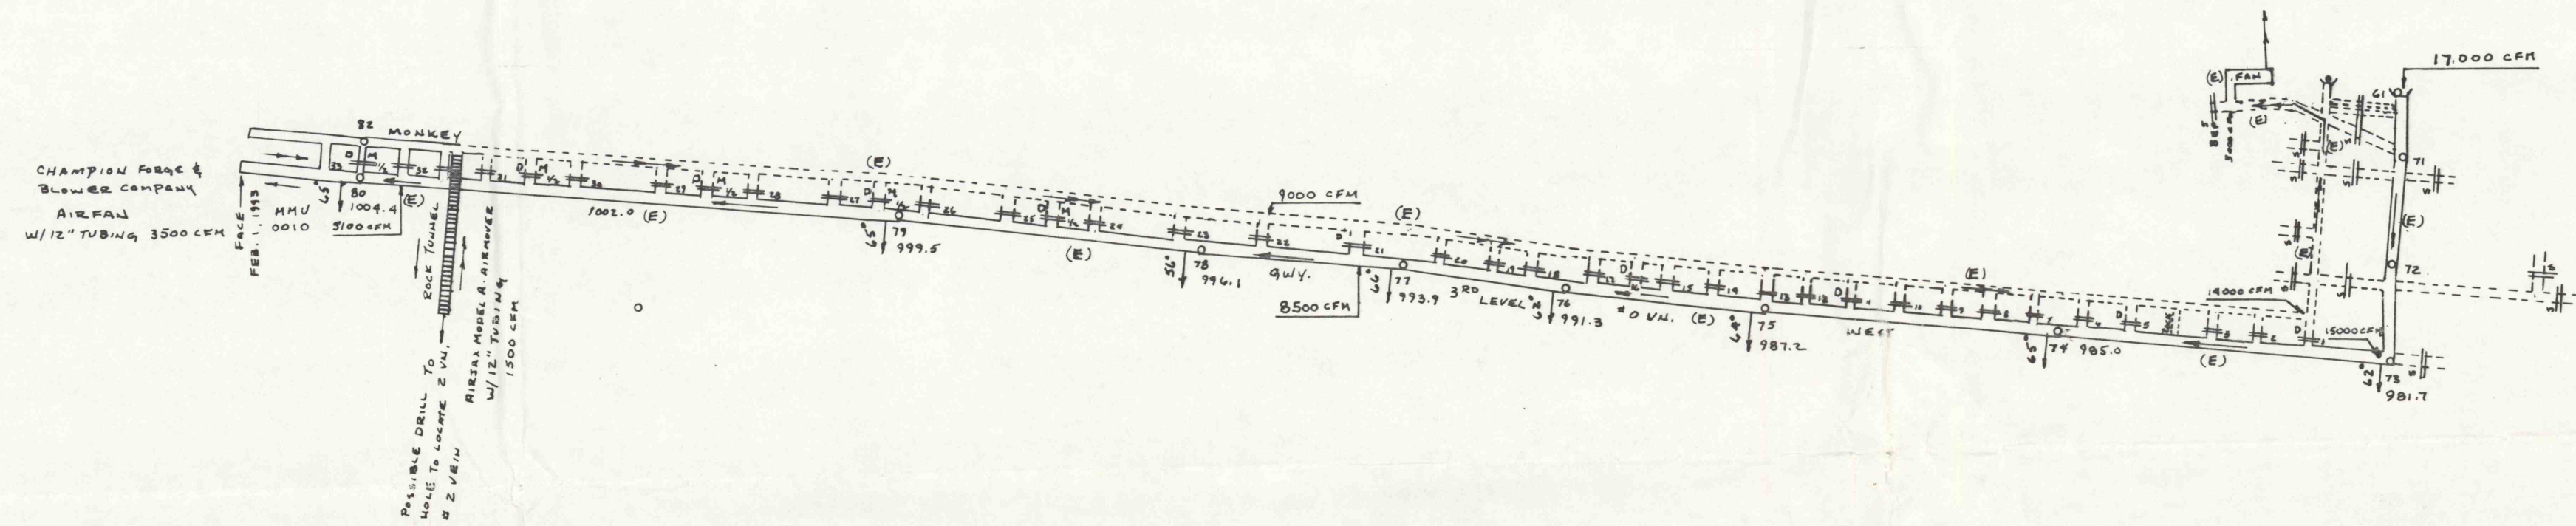


WILLIAM J. MESSNER, P.L.S.
R.D. #1 BOX 1523
HERNDON, PA. 17830
(717) 758-9266
SU-28849-E

William J. Messner

PLAN OF
MINE
AND
VENTILATION
FOR
S B & M COAL COMPANY
MSHA I.D. #36-05495
DER I.D. #49861309T
R.D. #2
HEGINS, PA. 17938
(717) 682-3697
LOCATED IN
M & R SLOPE
NO. ZERO VEIN - SOUTH DIP
BIG MOUNTAIN
TOWNSHIP OF ZERBY
COUNTY OF NORTHUMBERLAND
COMMONWEALTH OF PENNSYLVANIA
SCALE: AS NOTED
DATE: APRIL 30, 1993
FILE: SBM COAL
PLAN: #2 OF 6

REVISED: MAY 15, 1994

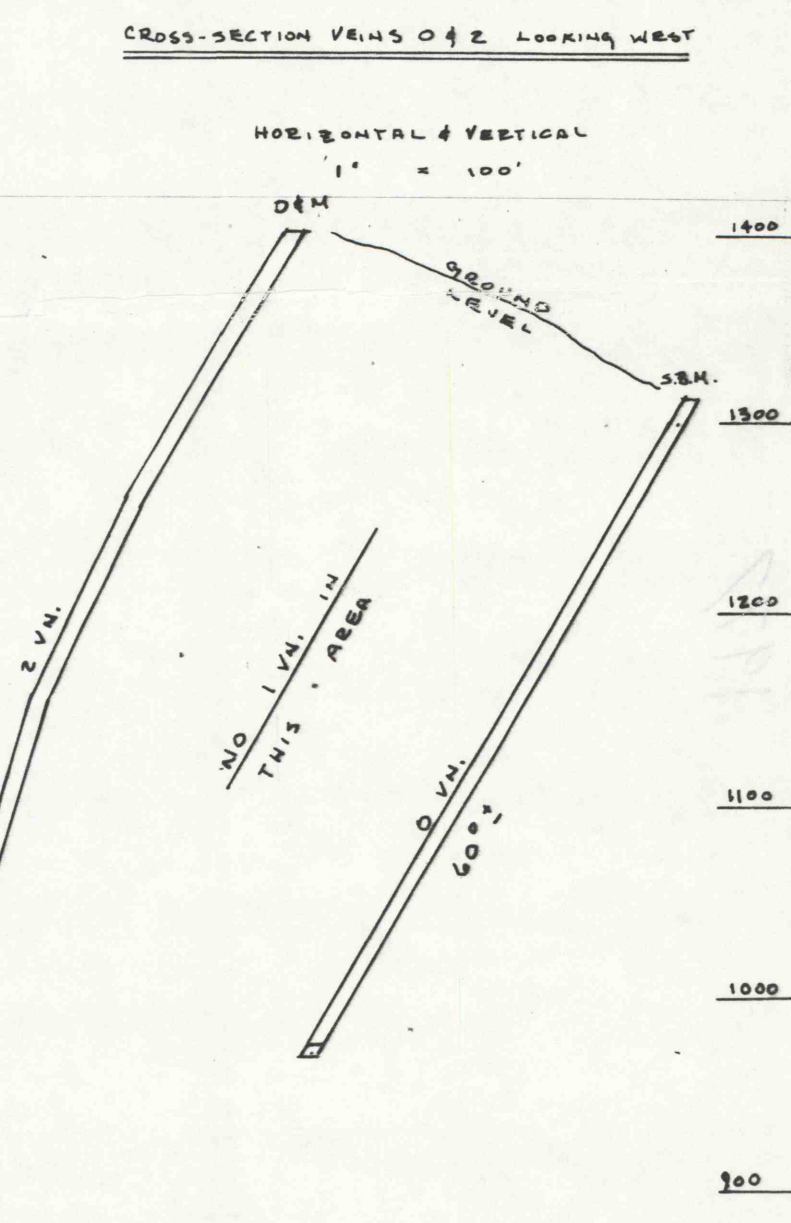

RECEIVED
JUN 03 1994
PA. DEPT. OF LAB.
MSHA
HARRISBURG, PA.