


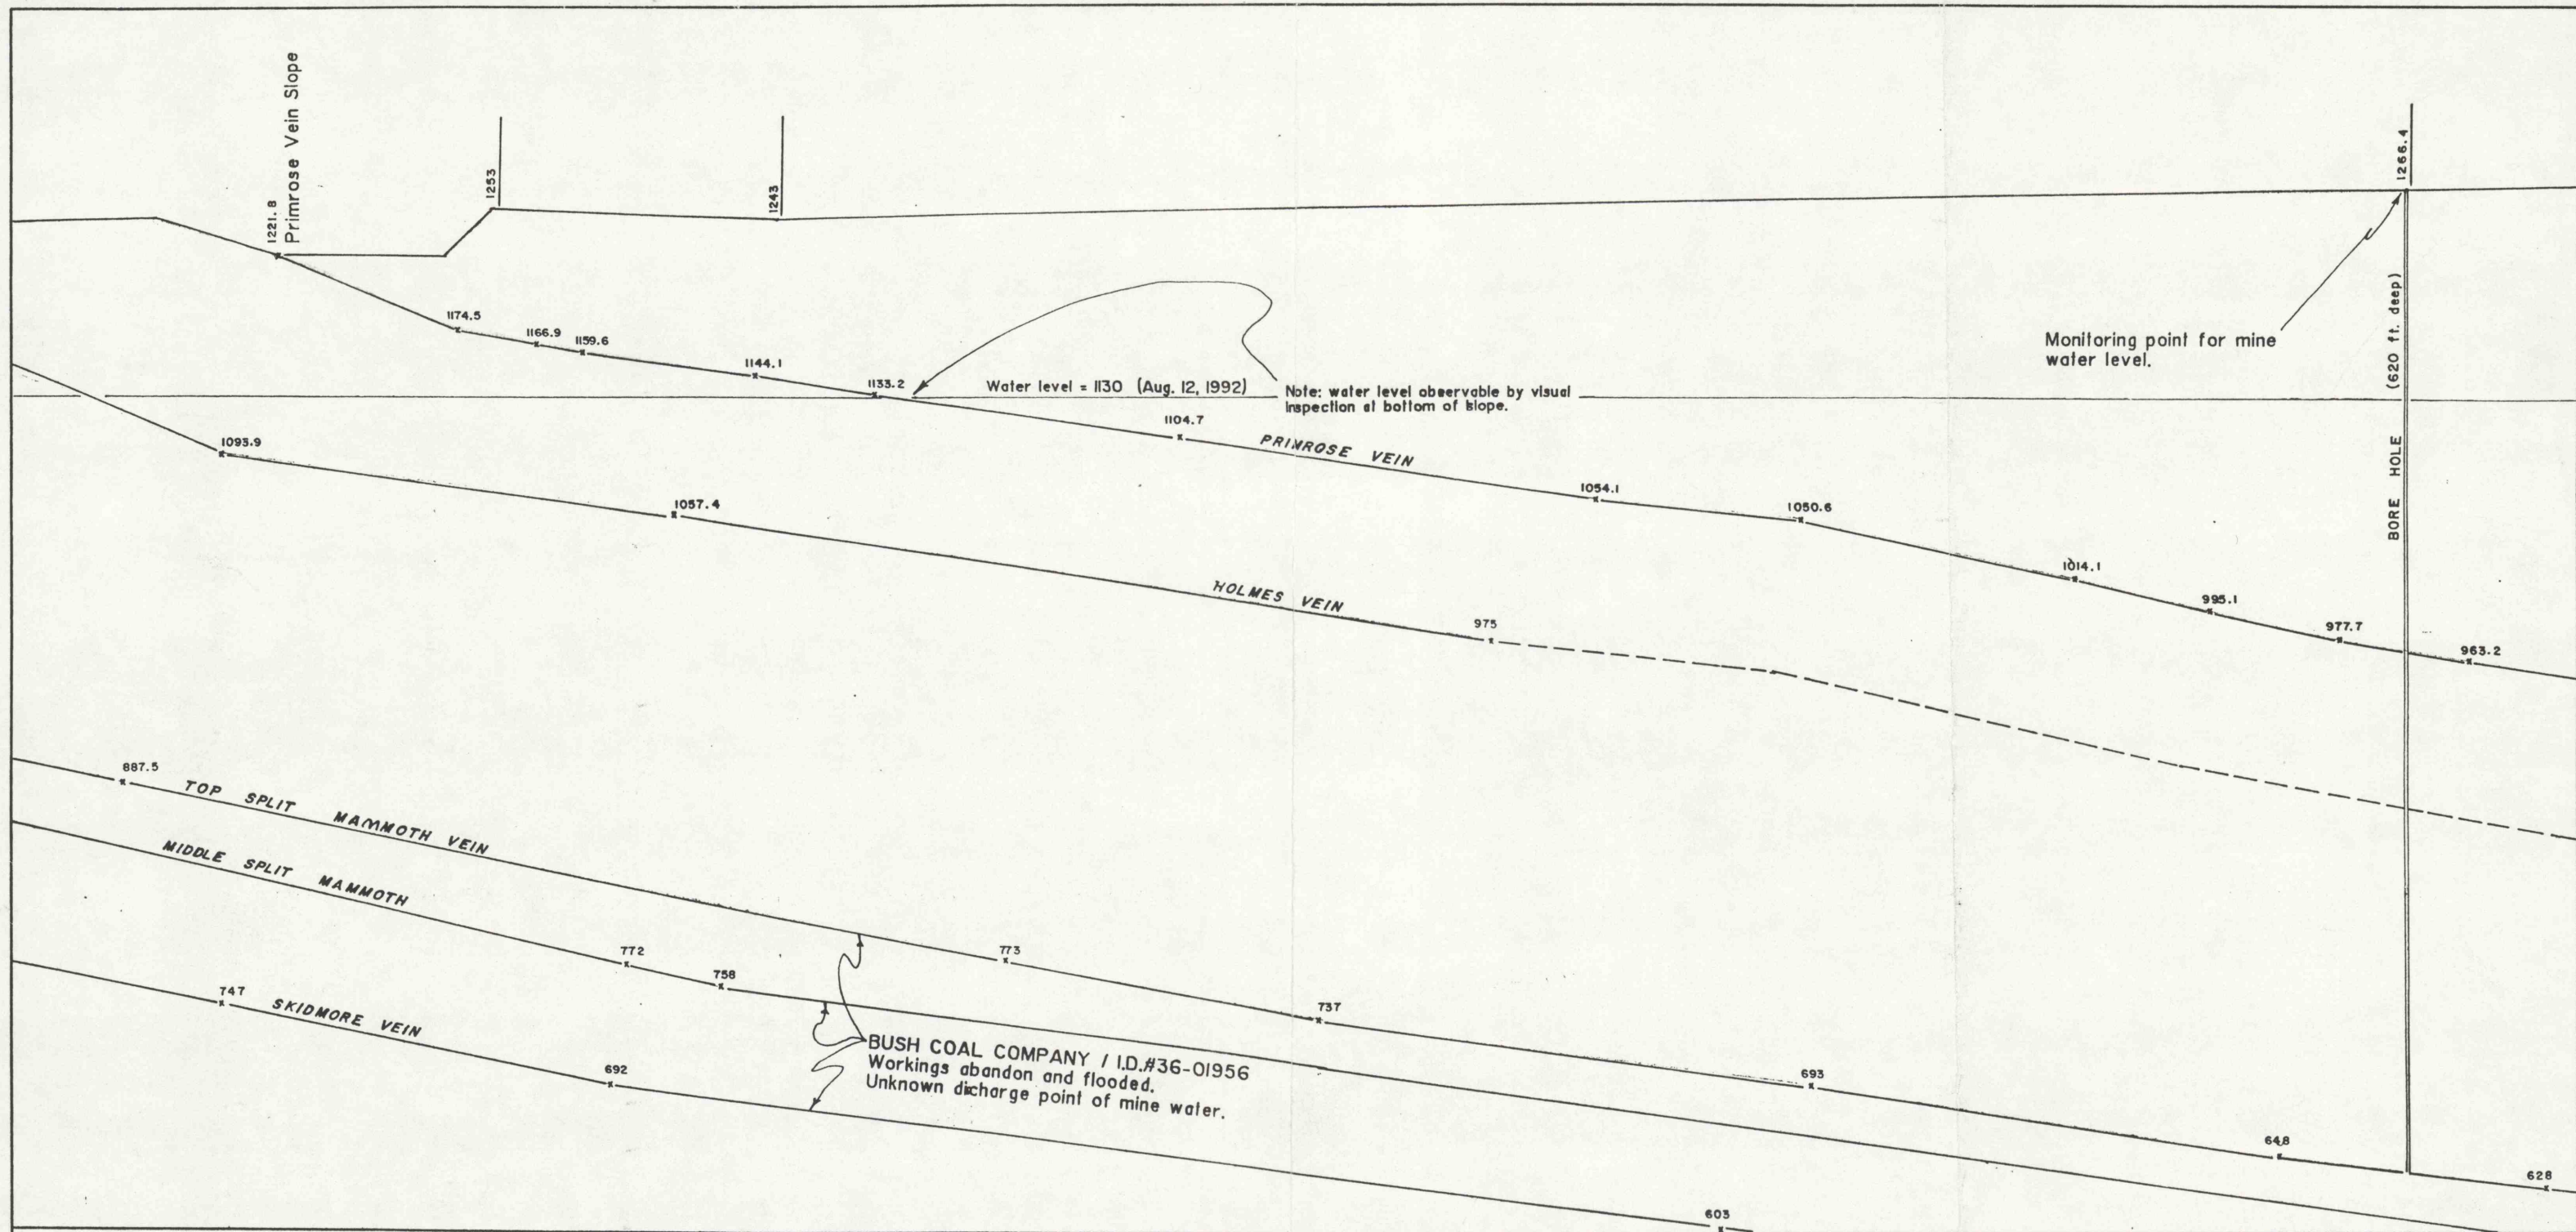

Looking North

SECTION THROUGH PRIMROSE COAL COMPANY's Primrose Vein Slope

Datum = 600 ft. A.M.T.

RECEIVED

OCT 26 1992

POTTSVILLE, PA

I.D. #36-04629

Scale: 1" = 100'

October 26, 1992

David L. Williams

1984