



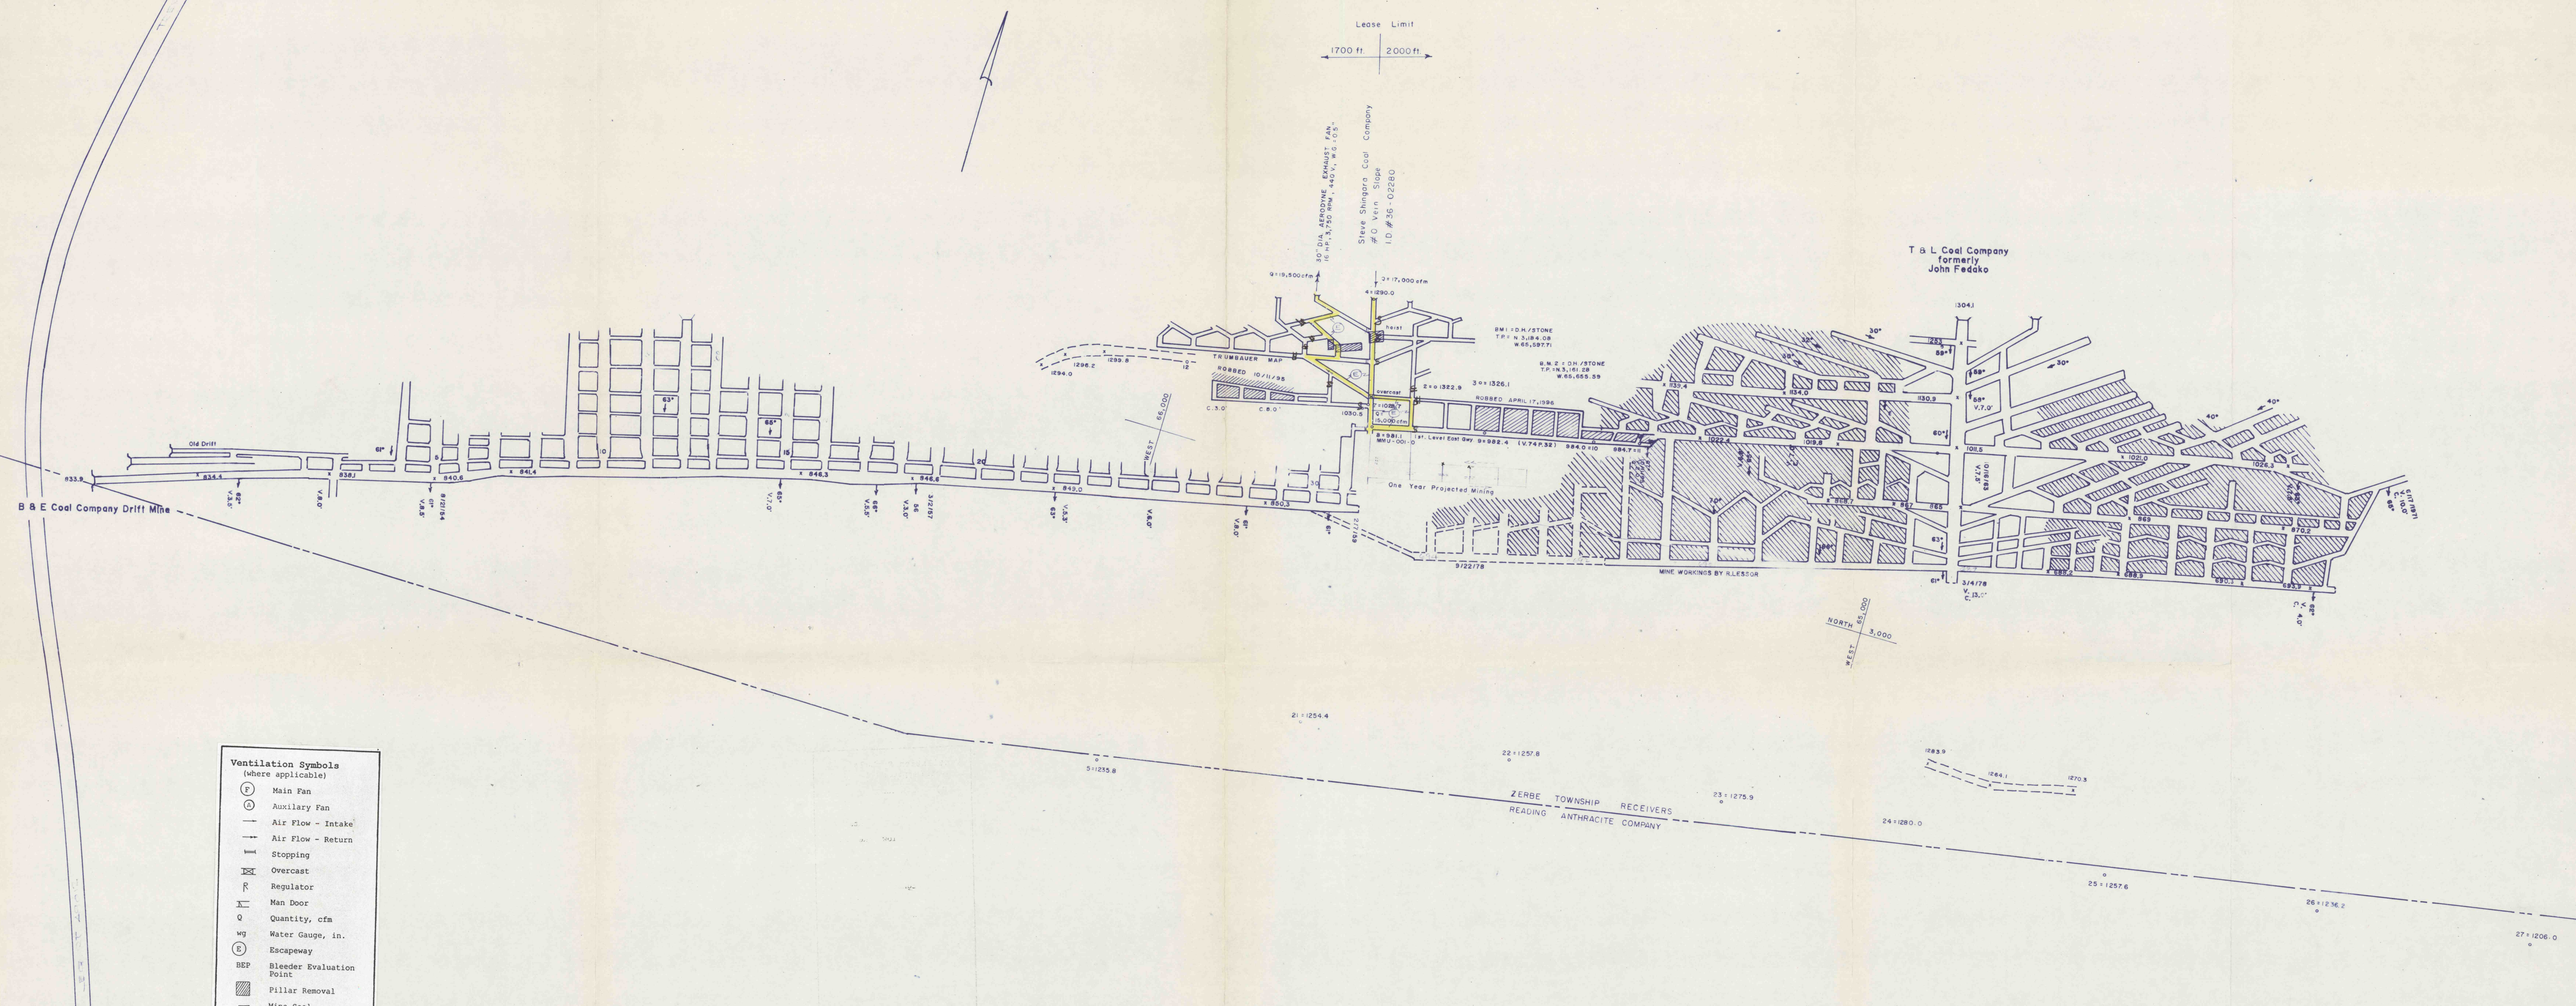

- Ventilation Symbols**
(where applicable)
- ⊕ Main Fan
 - ⊙ Auxiliary Fan
 - Air Flow - Intake
 - - - Air Flow - Return
 - ⊥ Stopping
 - ⊥ Overcast
 - ⊥ Regulator
 - ⊥ Man Door
 - Q Quantity, cfm
 - WG Water Gauge, in.
 - ⊕ Escapeway
 - BEP Bleeder Evaluation Point
 - ▨ Pillar Removal
 - ⊥ Mine Seal
 - ⊥ Active Workings
 - - - Curtain or Brattice
 - - - Workings Not Surveyed
 - - - Caved Ground

MINE MAP
of the
STEVE SHINGARA JR. COAL COMPANY
situate on the
south dip #0 vein
Zerbe Township, Northumberland County
A.B. Riedel, P.E. November 12, 1990
POSTED April 17, 1996

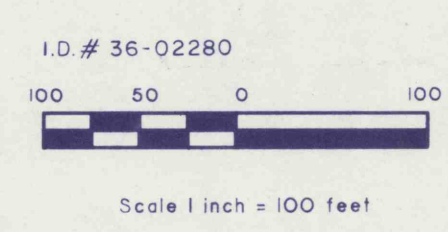

SURVEYOR'S CERTIFICATION

I hereby certify that to the best of my knowledge that the areas that I have surveyed are true and correct as to the requirements of 30 CFR Part 75.200. All other information shown has been derived from the best available information but can not be field checked. Therefore, surveyor makes no certification to their accuracy.

David L. Williams
Surveyor

MINE OPERATOR'S CERTIFICATION

I depose and say that the mine ventilation information shown on this map meets the requirements of 30 CFR Part 75.372 and was prepared by me or under my direction for which I accept full responsibility.

Stephen Shingara
Mine Foreman

RECEIVED


MAY 24 1996

U.S. DEPT. OF LABOR
SHAMOKIN, PA.

RECEIVED

JUN 8 1996

U.S. DEPT. OF LABOR
WILKES-BARRE, PA.

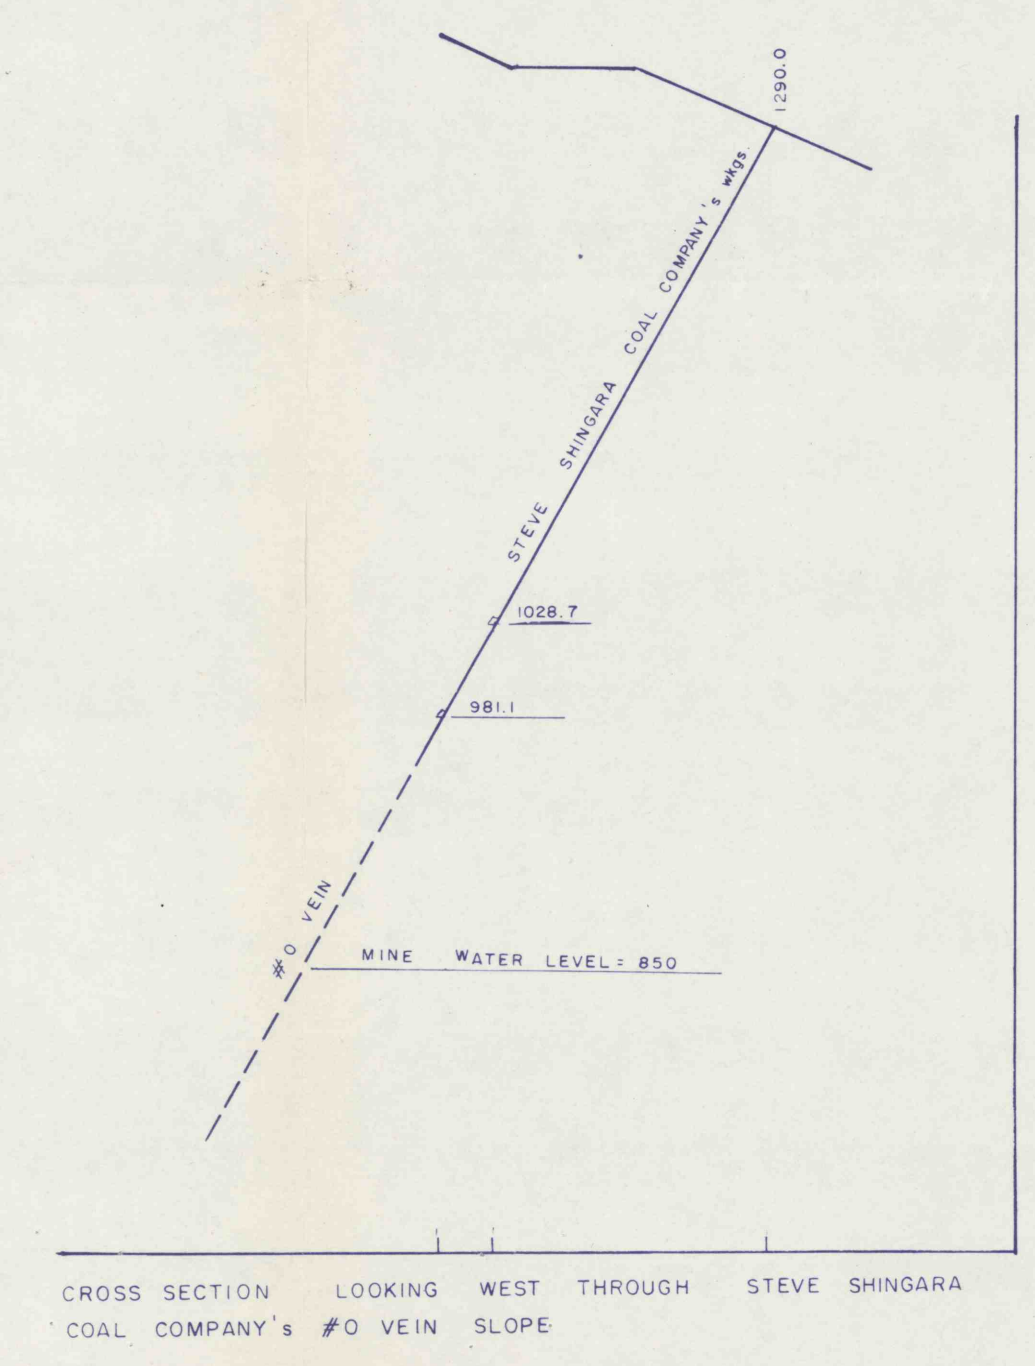

hbb1