


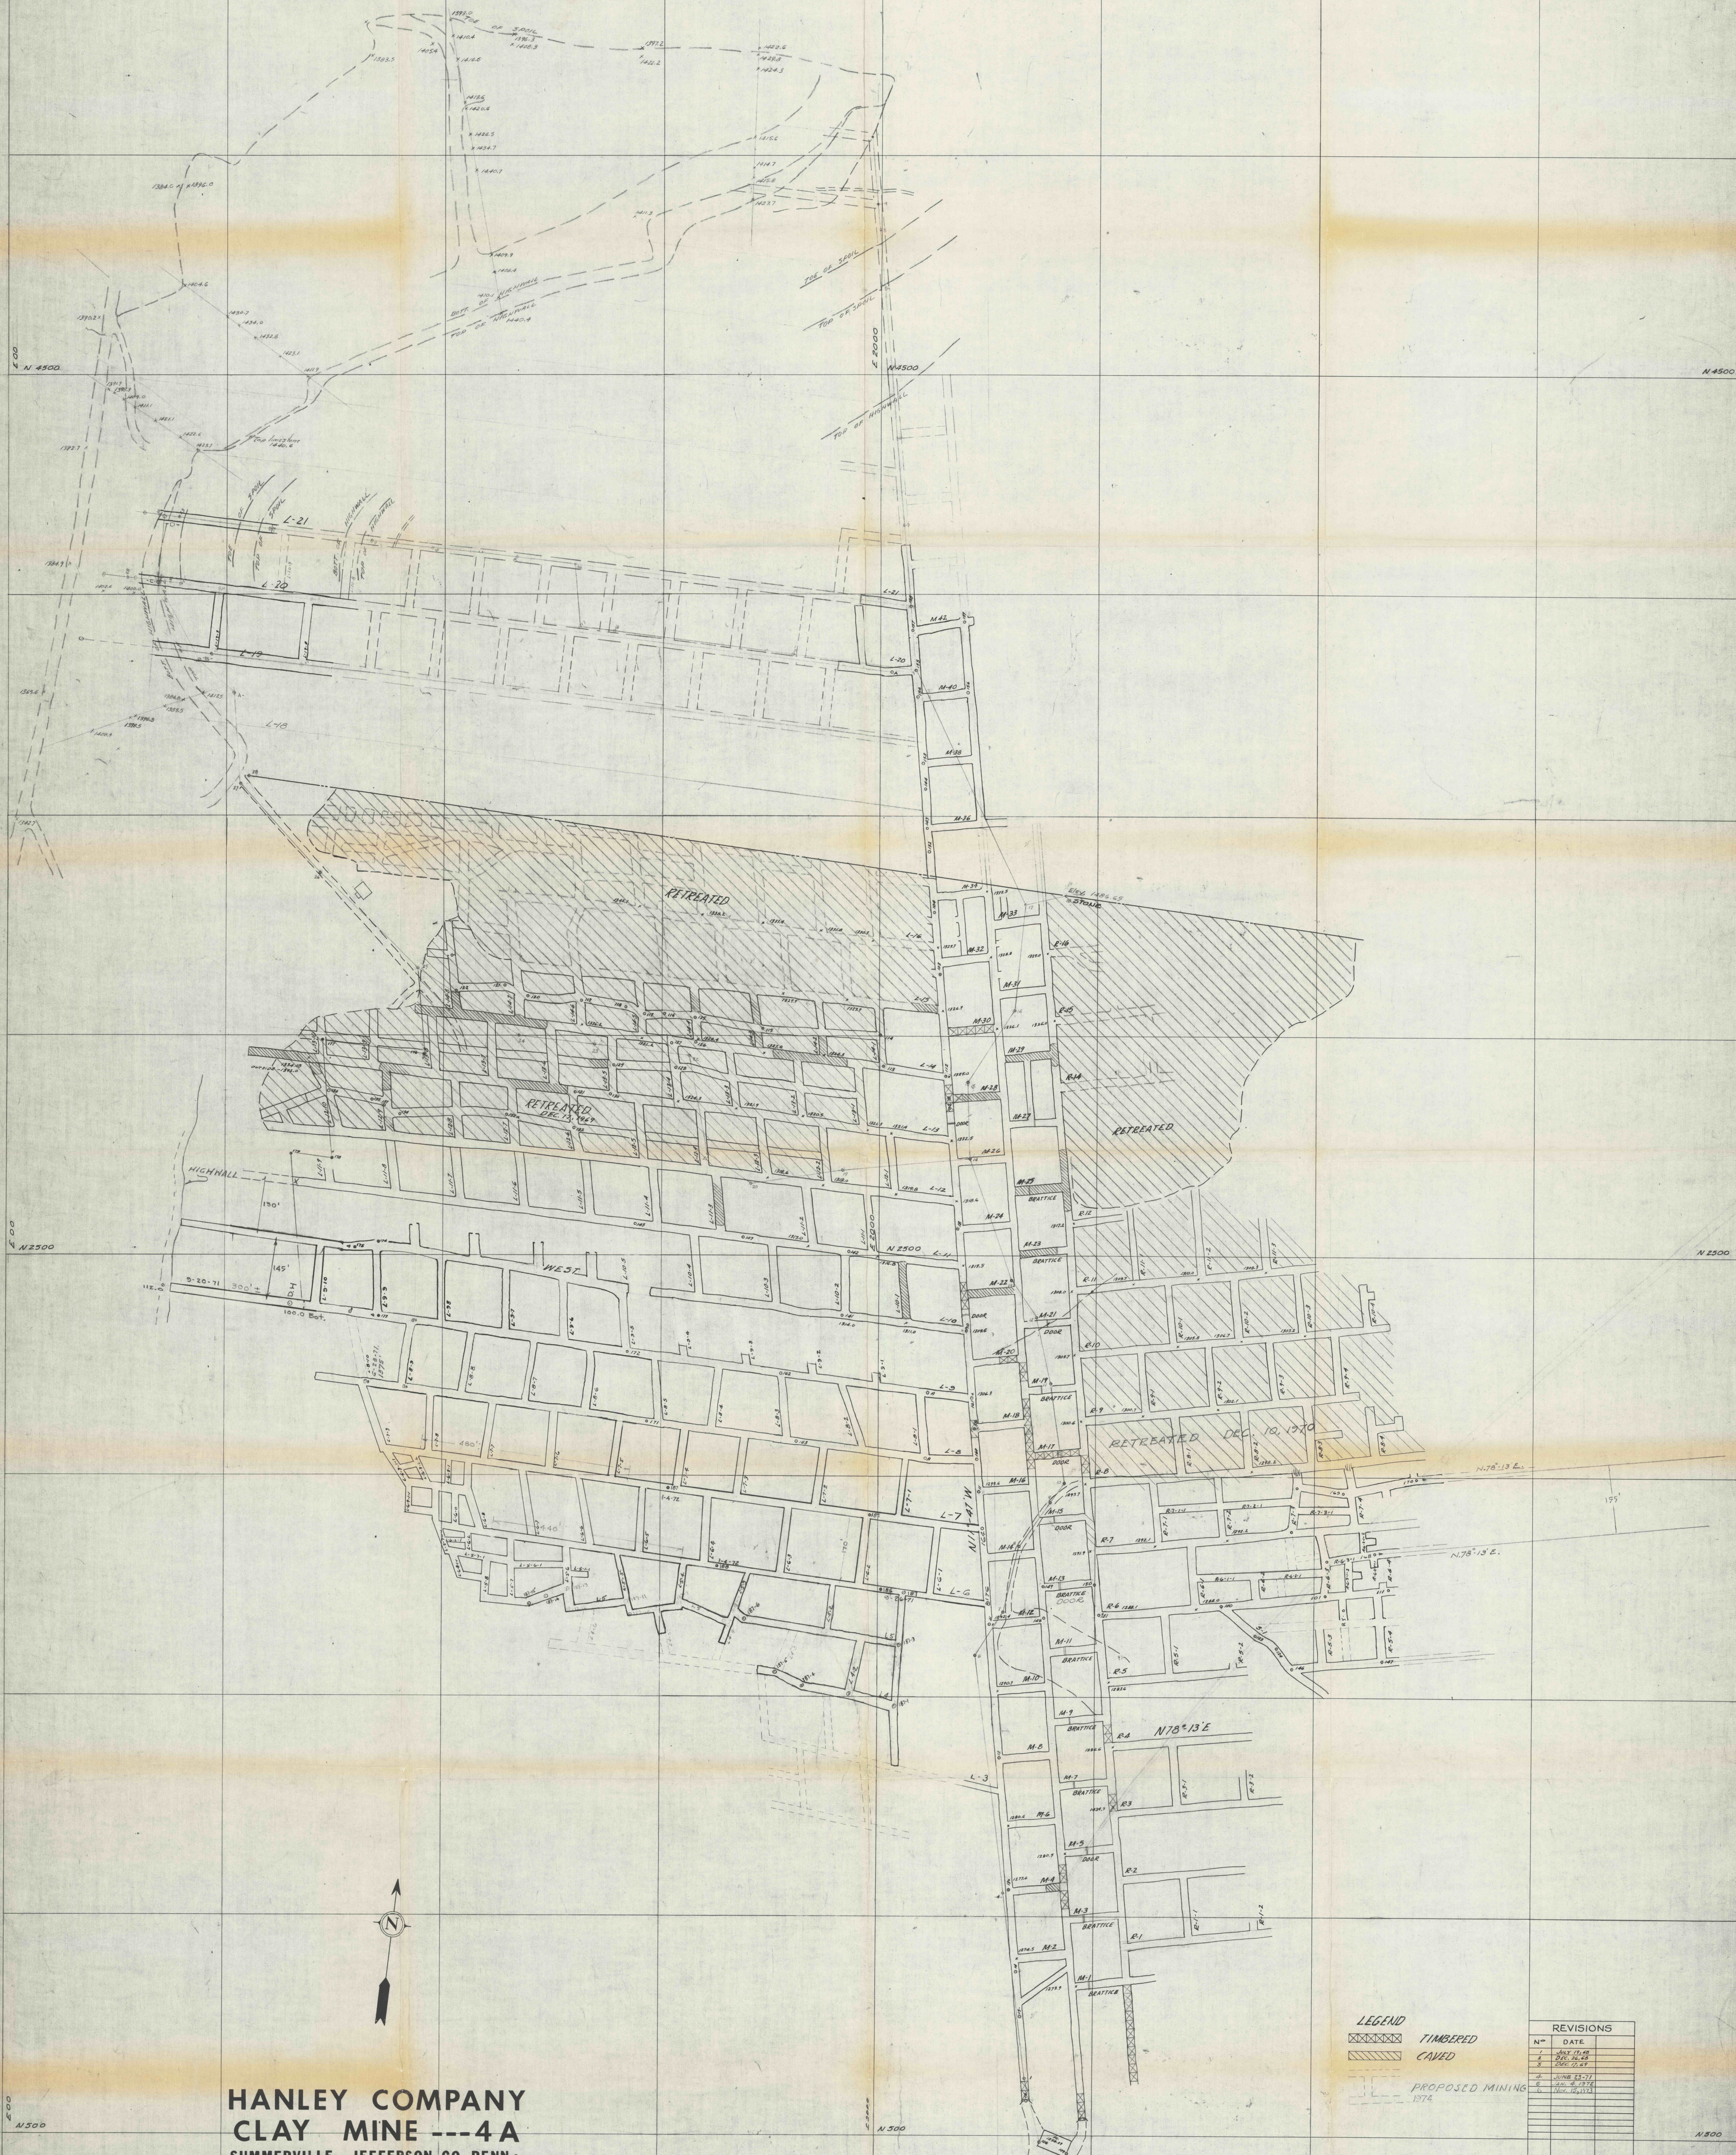

**HANLEY COMPANY
CLAY MINE ---4A**
SUMMERVILLE, JEFFERSON CO. PENNA.
SCALE 1"=10' JULY '7, 1968

LEGEND
TIMBERED
CAVED
PROPOSED MINING
1974

REVISIONS	
N ^o	DATE
1	APR 11-68
2	DEC 26-68
3	DEC 21-68
4	JUN 23-71
5	JUL 6-1974
6	JUL 21-1974
7	
8	
9	
10	