


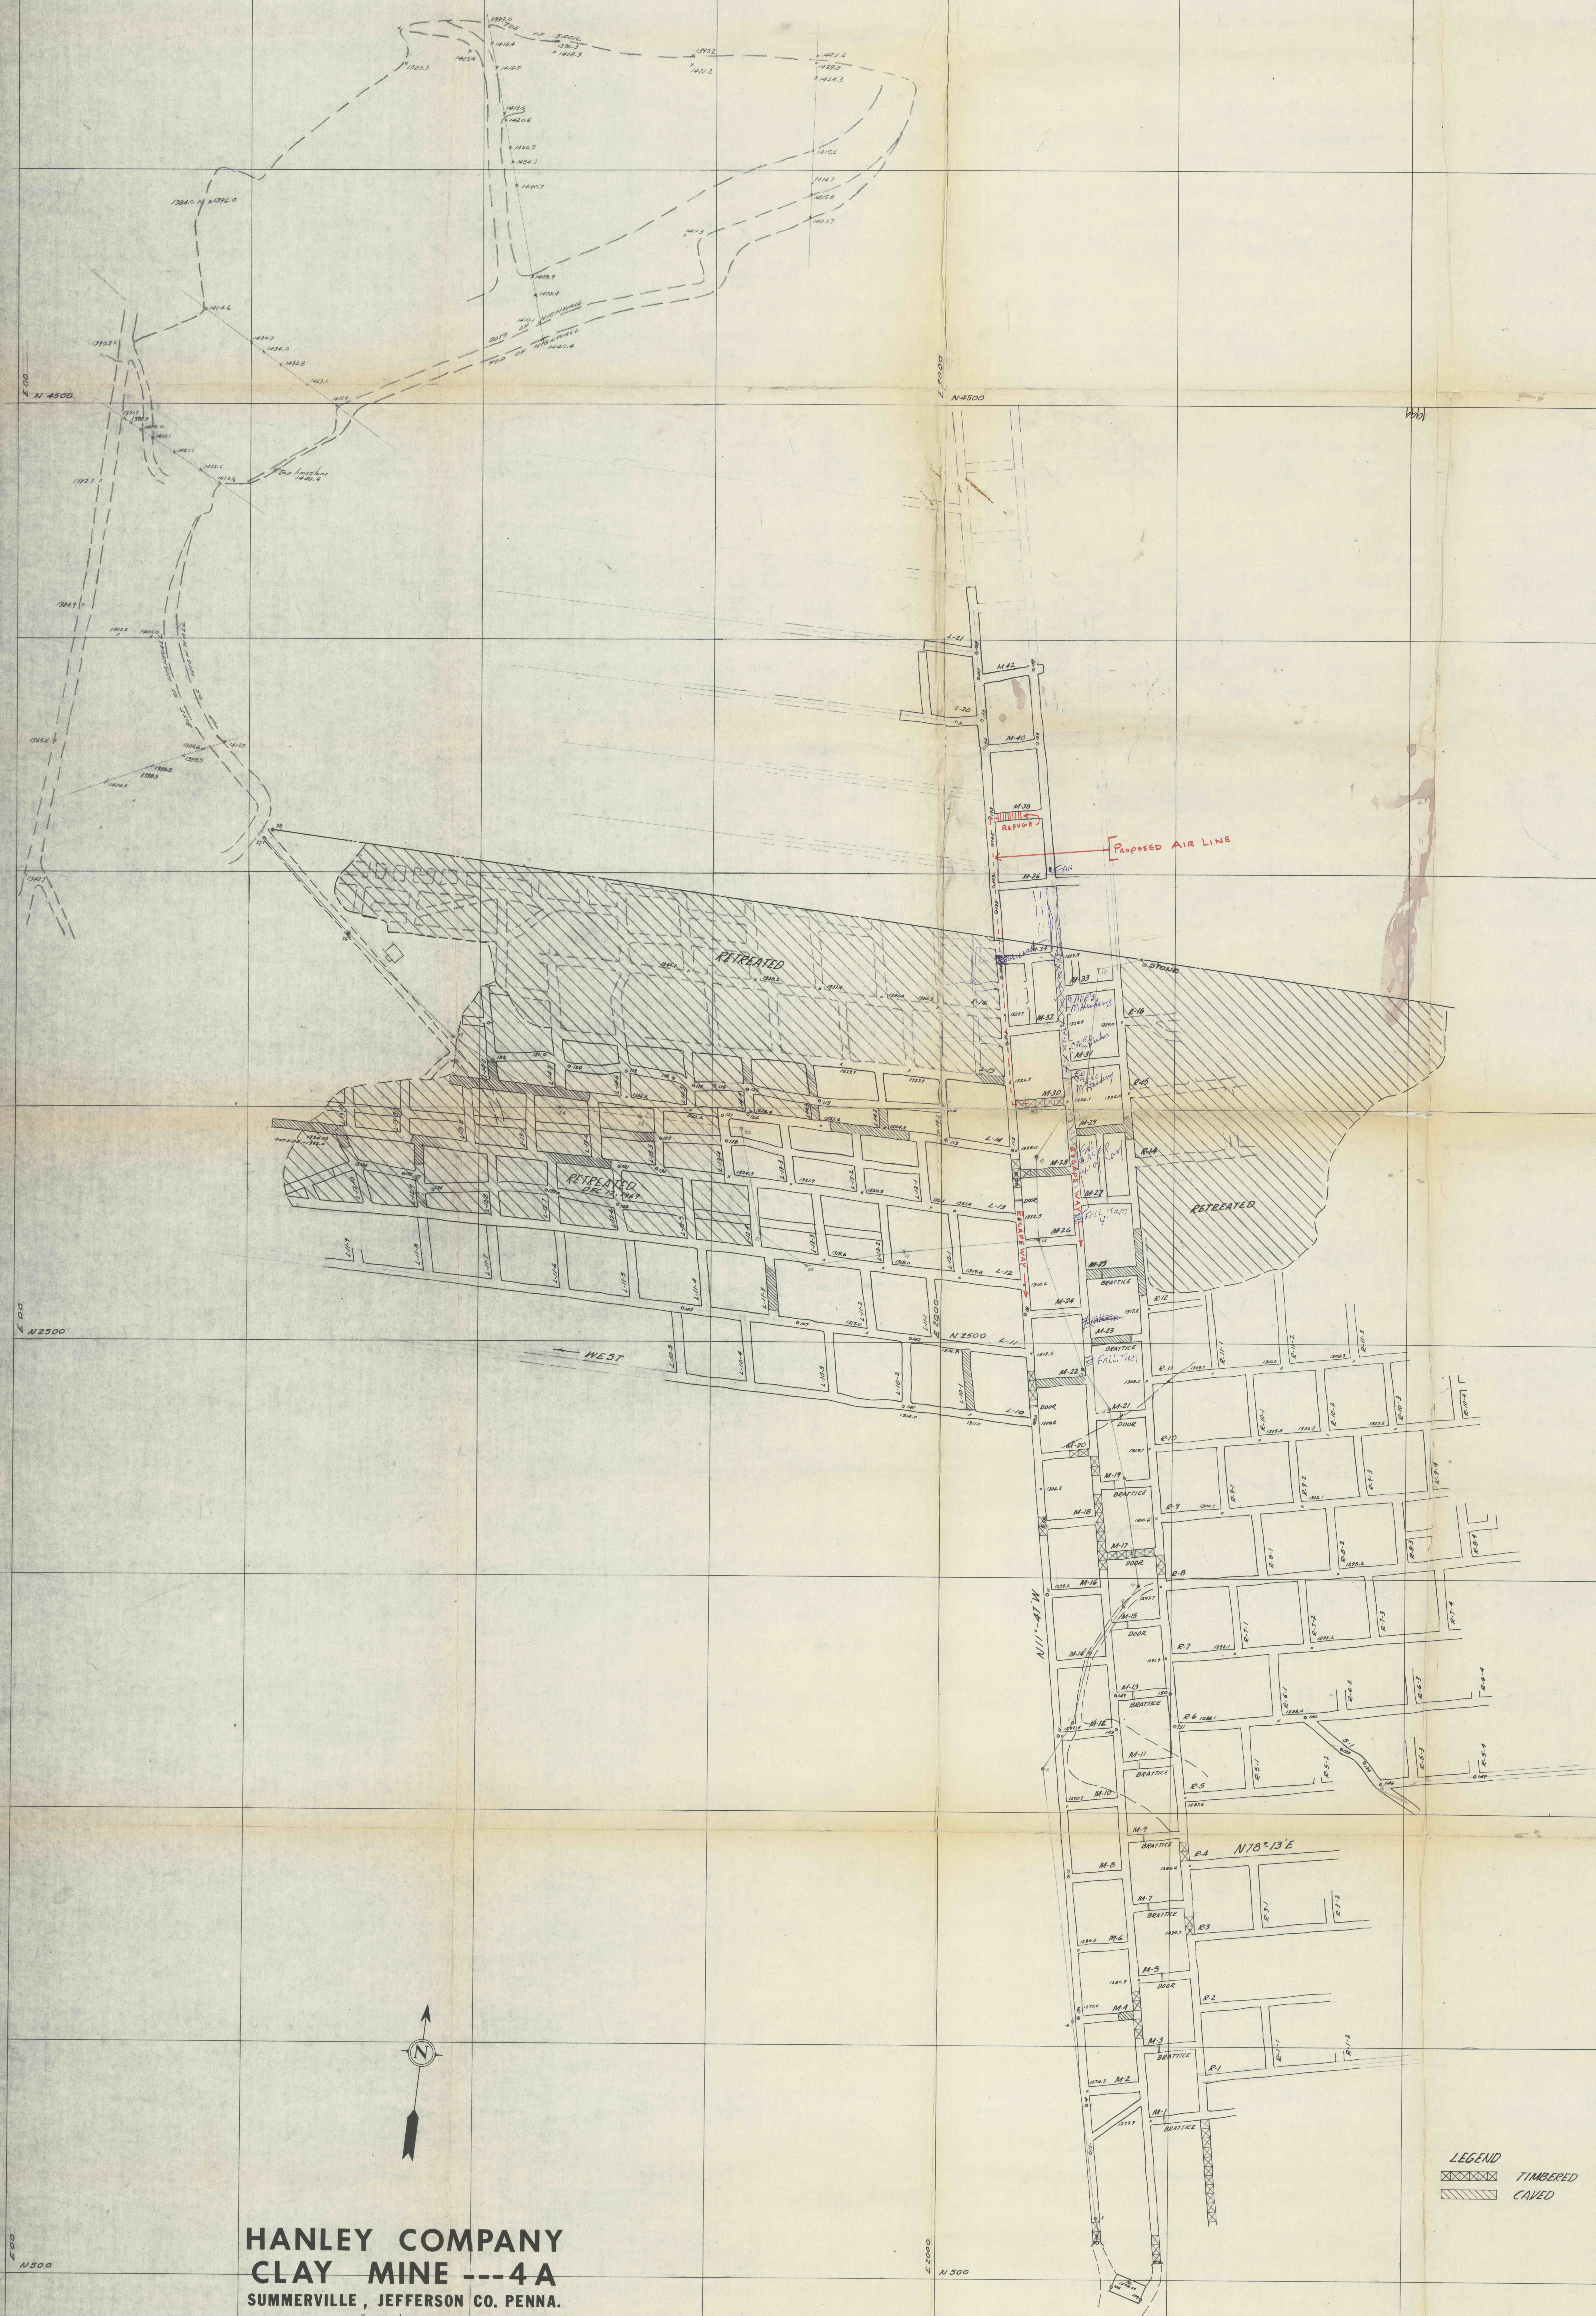

HANLEY COMPANY
CLAY MINE --- 4 A
SUMMERVILLE , JEFFERSON CO. PENNA.
SCALE:1"=100' JULY 17, 1968

YOST ASSOCIATES INC.
DUBOIS, PA.