


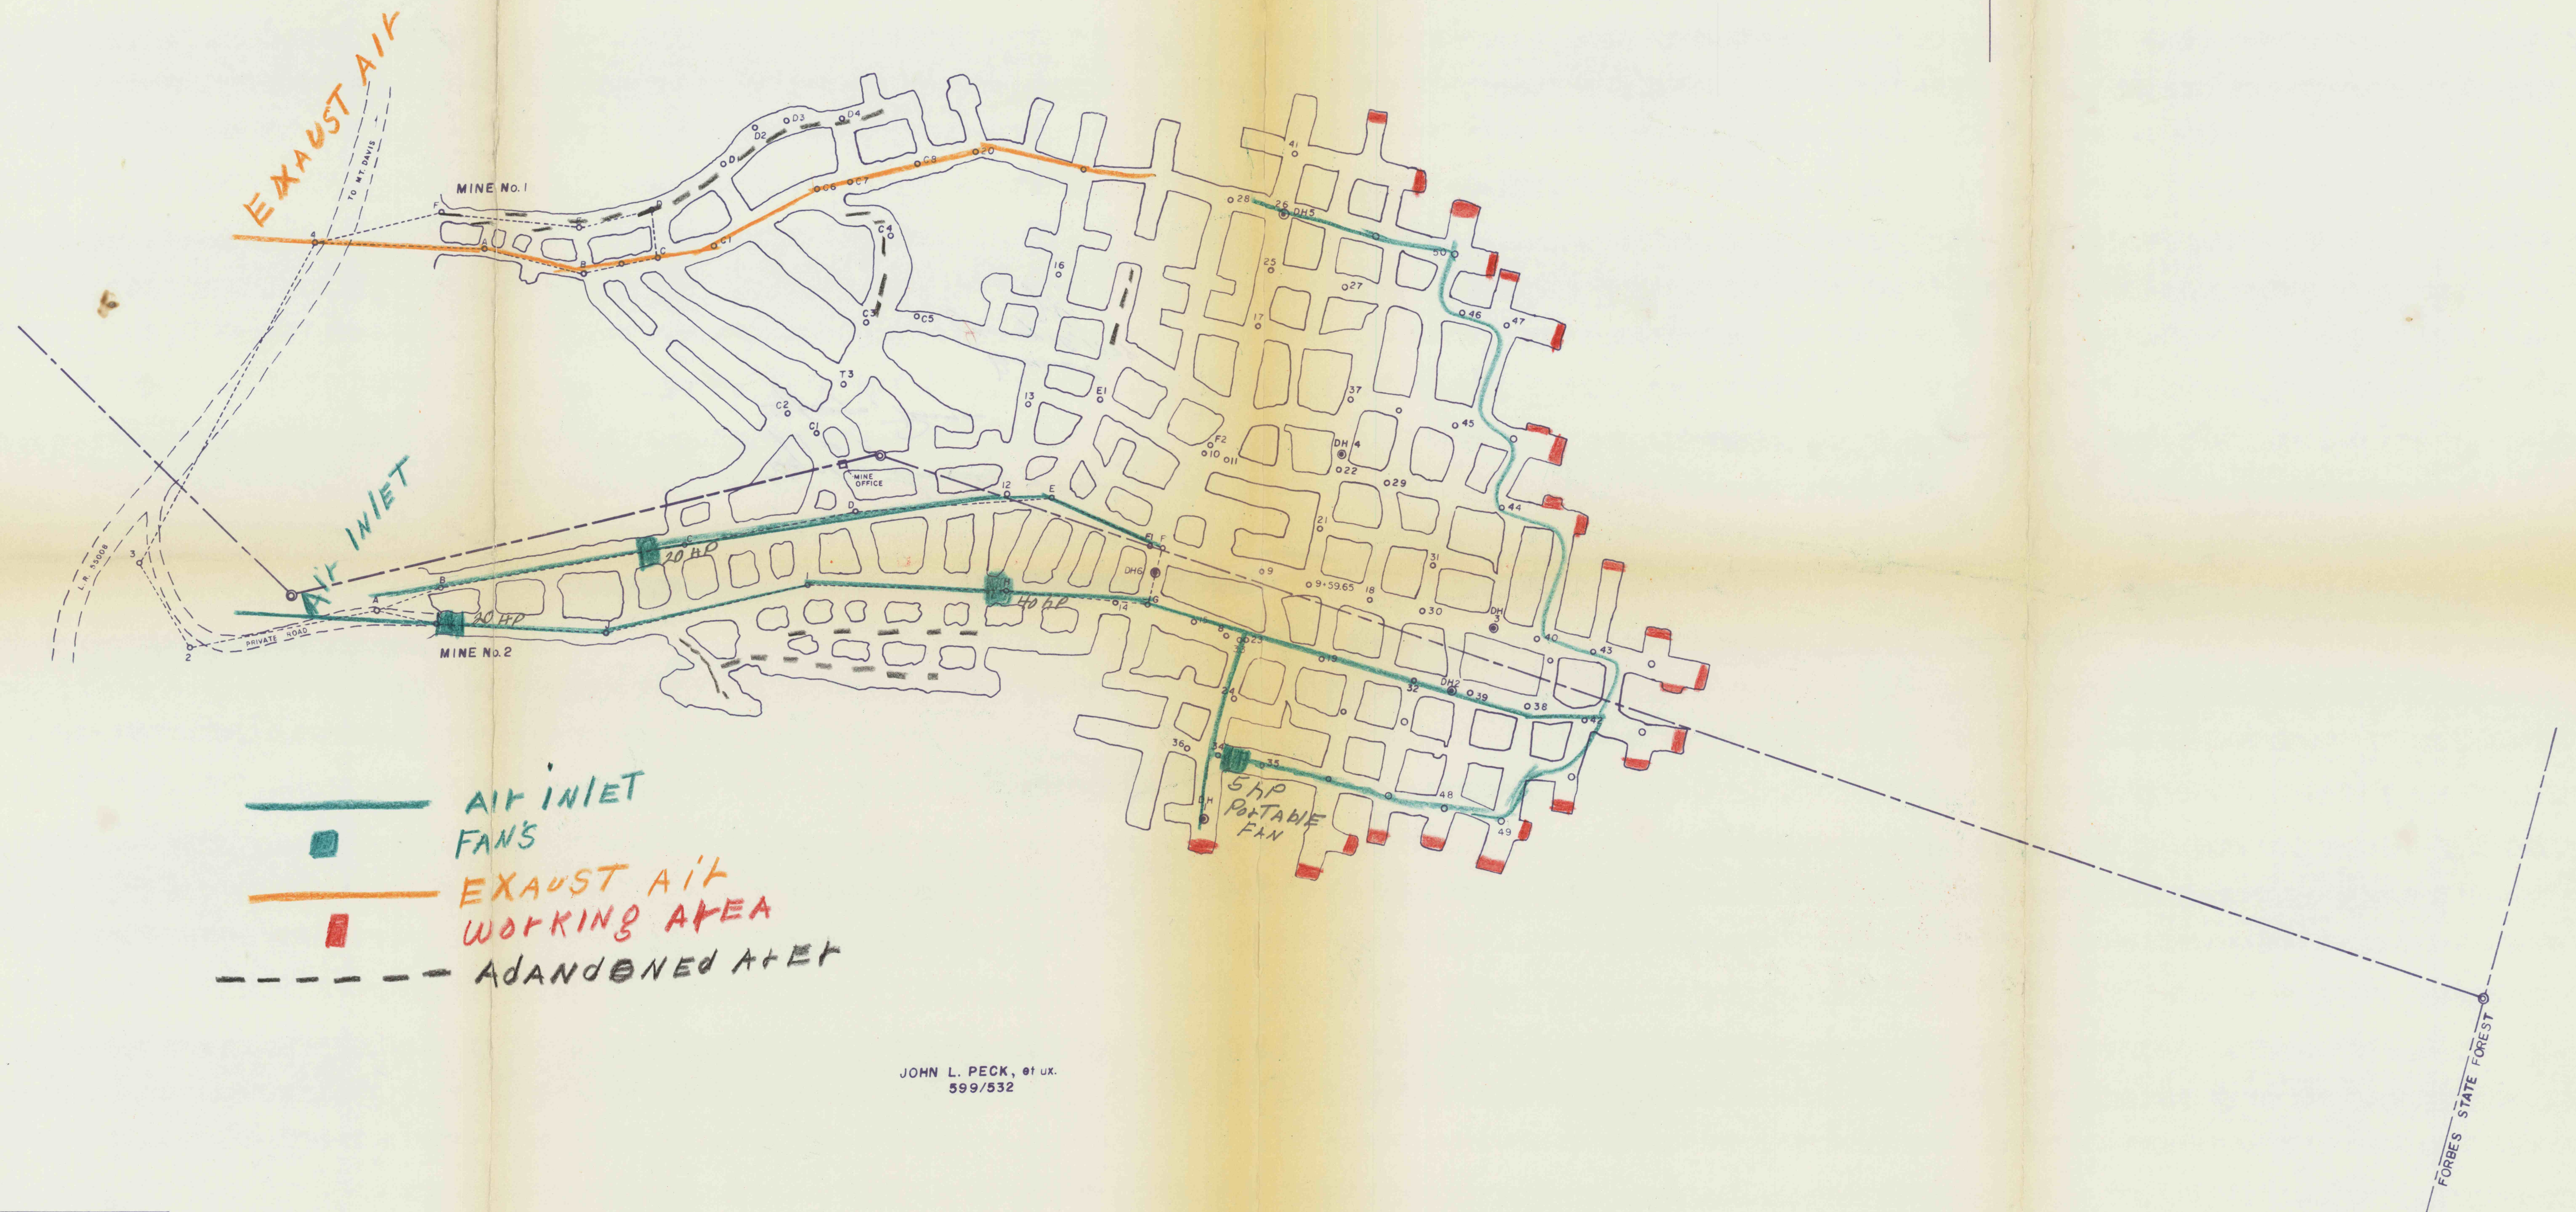

JOHN L. PECK, et ux.
599/532



PLAN OF

Keystone Lime Company, Inc.
Limestone Deep Mine
Location—Elk Lick Township, Somerset
County, Pennsylvania

Date—Sur. B.F.M. 12/6/77
Dwg. KEY 12/6/77 Scale 1"=100'

REVISIONS

1 Revised 12/28/78 M. J. M.

- © property corner
- proposed drill hole

Blaine E. Miller, Surveyor
Springs, Pa. 15562